


HAROLD H. KOLB

REGISTERED PROFESSIONAL LAND SURVEYOR
LAKE GENEVA, WISCONSIN

PLAT OF SURVEY OF
Lot 5, Tract 1, 2nd
Addition to
Tratt's 2nd Add.,
City of Lake Geneva,
Wisconsin, City of
Lake Geneva, Wisconsin,
County of Racine,
State of Wisconsin.

Park St.

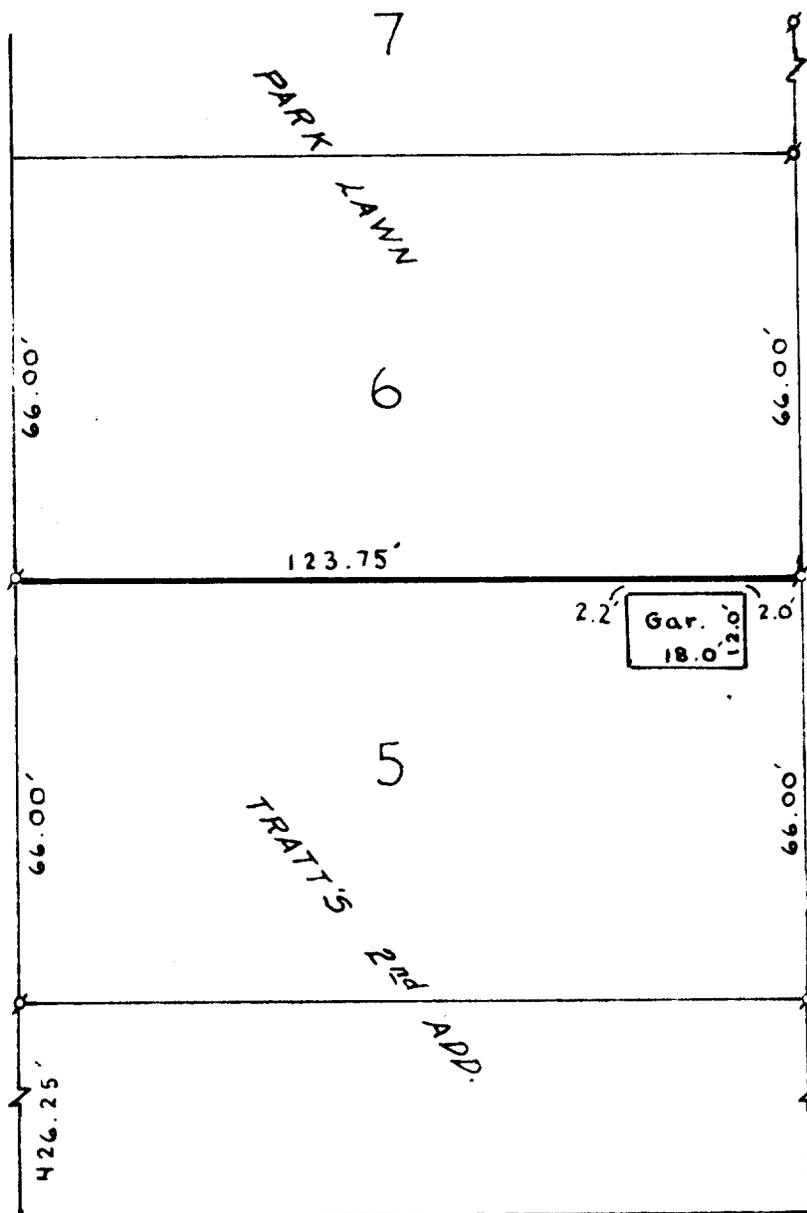


N



SCALE: 1" = 30'

LEGEND

- ⊘ — IRON PIPE FOUND
- — IRON PIPE PLACED
- — CONCRETE MONUMENT
- x — SPIKE

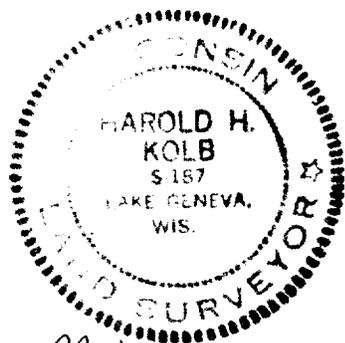

North St.

I, HAROLD H. KOLB, DO HEREBY CERTIFY THAT I HAVE SURVEYED THE PROPERTY HEREON DESCRIBED ACCORDING TO THE OFFICIAL RECORDS, AND THAT THE PLAT HEREON IS A CORRECT REPRESENTATION OF THE LOT LINES.

Harold H. Kolb

HAROLD H. KOLB
WISCONSIN REGISTERED LAND SURVEYOR, S-187
DATE May 10, 1971

TA-7 + PA-1

10-160