



PARTS OF LOTS 9 AND 10, ORIGINAL PLAT
CITY OF WHITEWATER, WISCONSIN

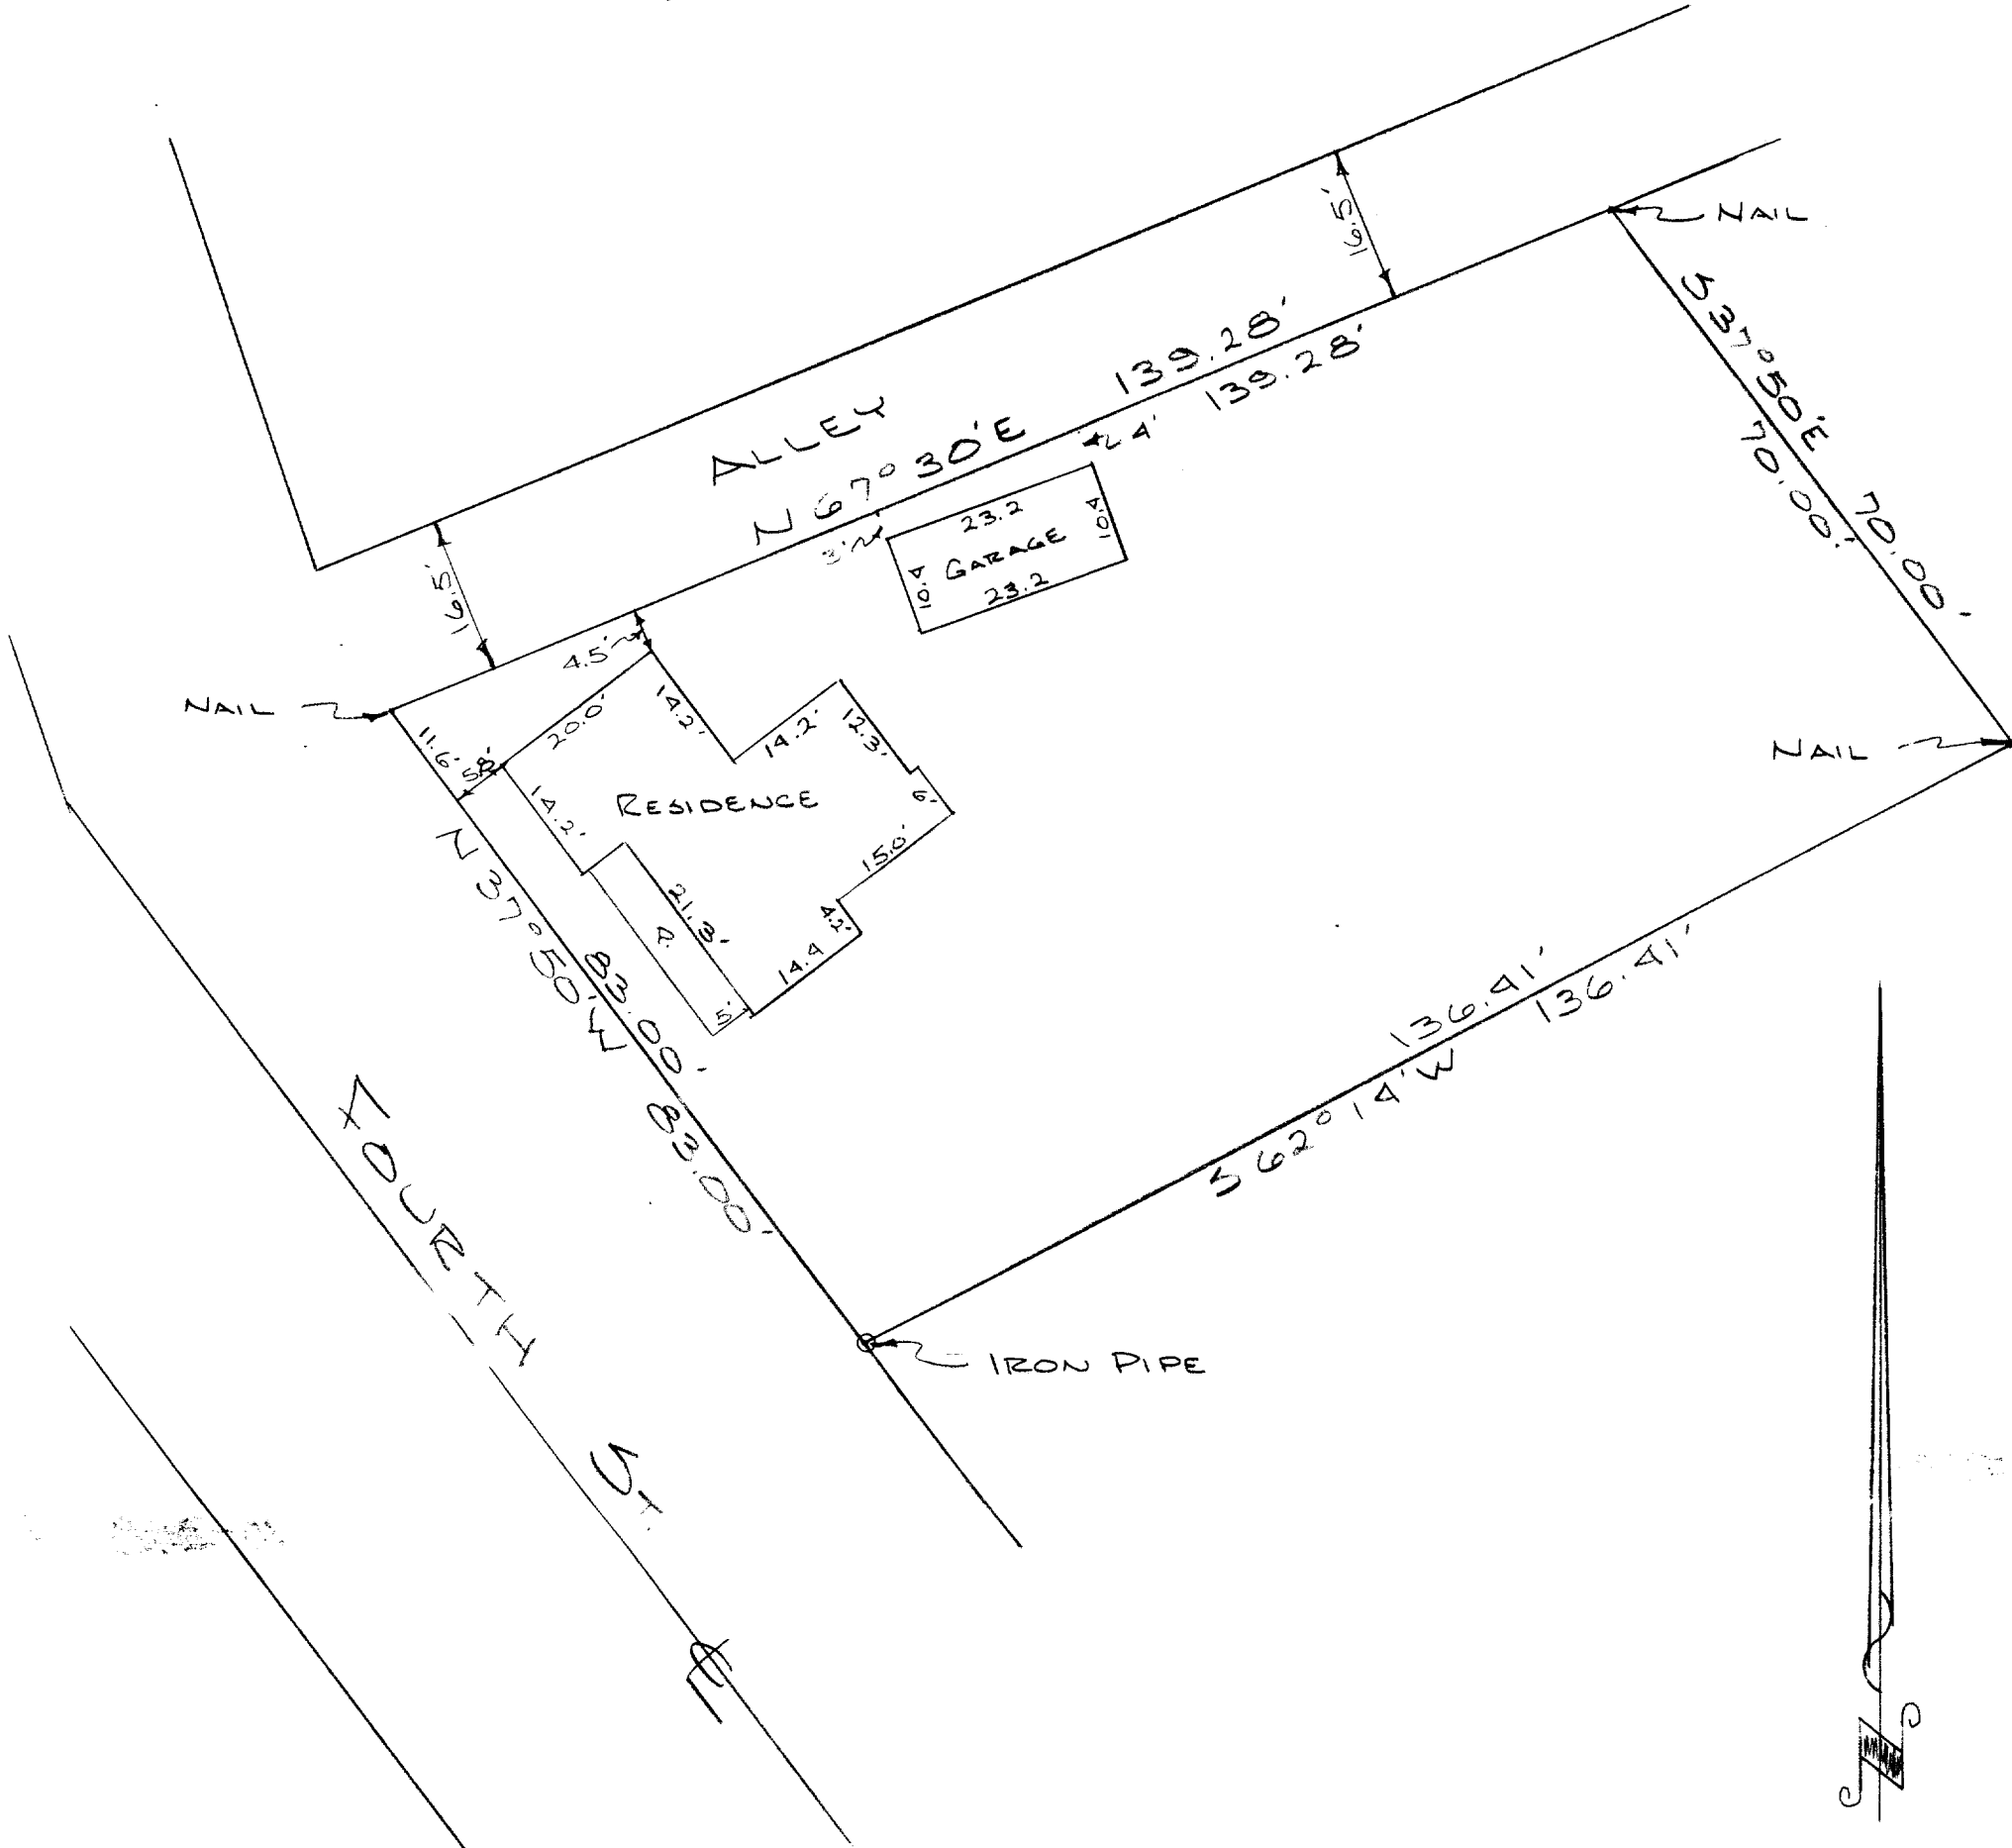

DESCRIPTION: Commencing at the NW corner of Lot 10, Original Plat, City of Whitewater, Walworth County, Wisconsin, thence N 67°30' E along the north line of Lots 9 and 10, 139.28 feet, thence S 37°50' E along the East line of said Lot 9, 70.00 feet, thence S 62°14' W, 136.41 feet to the West line of said Lot 10, thence N 37°50' W along said West line, 83.00 feet to the Place of Beginning.

CERTIFICATE: I, James F. Biagi, surveyor, do hereby certify that I have surveyed the lands hereon described.

DATED: October 7, 1970

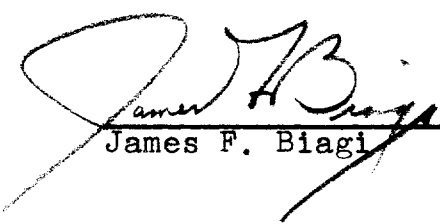
James F. Biagi R.L.S. 272



REVISIONS			Part of Lots 9 and 10, Orig. Plat, Whitewater, Wisconsin		
NO.	DATE	BY	Sam Soffa		
1					
2					
3			DRAWN BY	SCALE	MATERIAL
4			AR	1" = 20'	
5			CHK'D	DATE	DRAWING NO.
			JFB	10/7/70	
			TRACED	APP'D	