


# HAROLD H. KOLB

REGISTERED PROFESSIONAL LAND SURVEYOR  
LAKE GENEVA, WISCONSIN

HIGH STREET

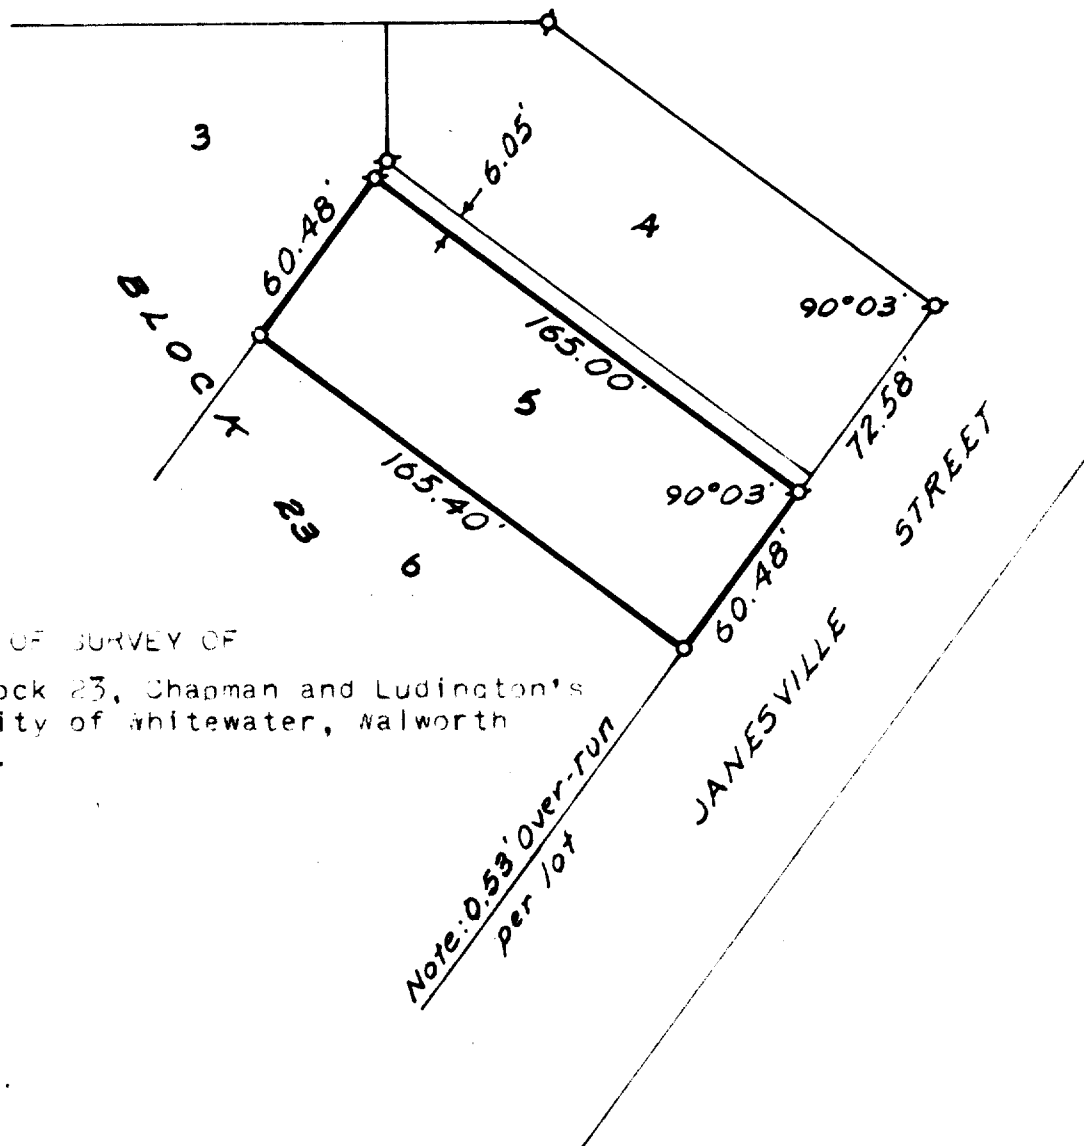

PLAT OF SURVEY OF

Part of Lot 5, Block 23, Chapman and Ludington's  
Addition to the City of Whitewater, Walworth  
County, Wisconsin.

N



SCALE 1" = 60'

## LEGEND

- Ø - IRON PIPE FOUND
- o - IRON ROD PLACED
- - CONCRETE MONUMENT
- x - SPIKE



I, HAROLD H. KOLB, DO HEREBY CERTIFY THAT I HAVE  
SURVEYED THE PROPERTY HEREON DESCRIBED ACCORDING  
TO THE OFFICIAL RECORDS, AND THAT THE PLAT HEREON  
IS A CORRECT REPRESENTATION OF THE LOT LINES.

*Harold H. Kolb*

HAROLD H. KOLB  
WISCONSIN REGISTERED LAND SURVEYOR, S-187  
DATE May 26, 1969