


HAROLD H. KOLB

REGISTERED PROFESSIONAL LAND SURVEYOR
LAKE GENEVA, WISCONSIN

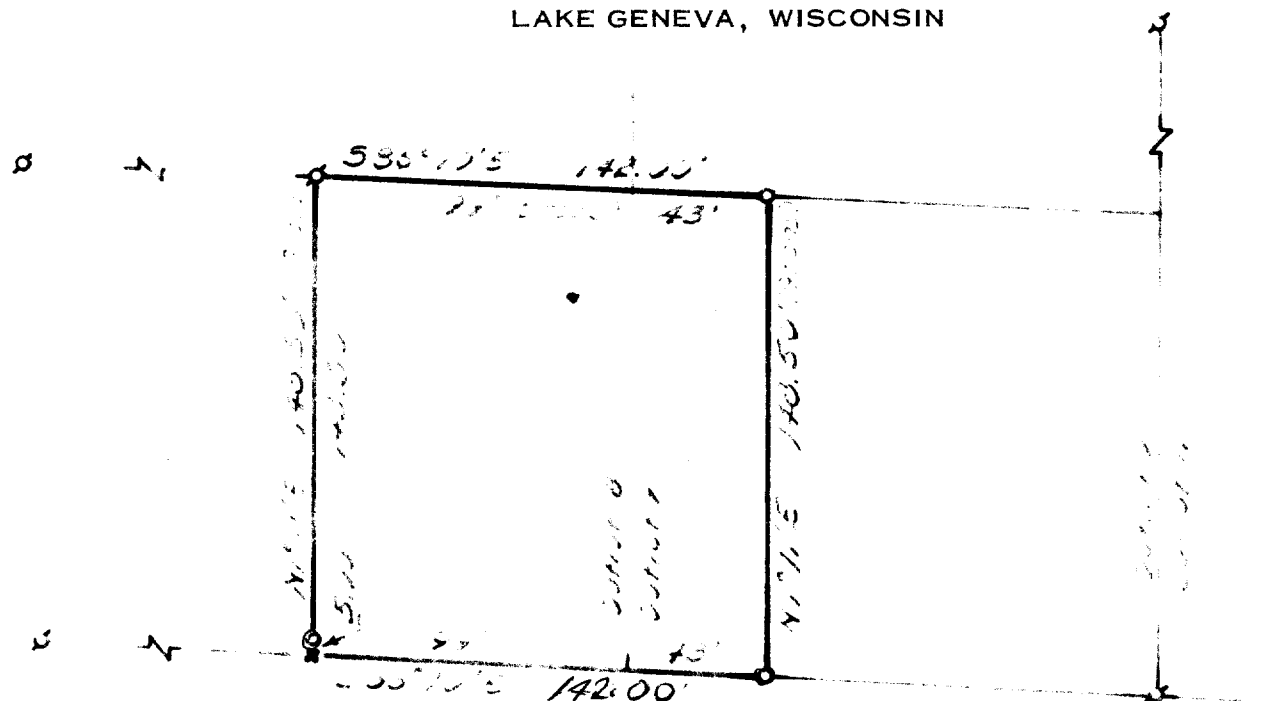

241 1/2 MAIN STREET

N



LEGEND

- Ø - IRON PIPE FOUND
- - IRON PIPE PLACED
- - CONCRETE MONUMENT
- x - Iron Pipe Found

PLAT OF SURVEY OF

The West 43 feet of the South 4 rods of
Lot 2 and the South 4 rods of the East 7
rods of Lot 2, J.C. Hall's Addition to the
Village, now City, of Whitewater, Walworth
County, Wisconsin

I, HAROLD H. KOLB, DO HEREBY CERTIFY THAT I HAVE
SURVEYED THE PROPERTY HEREON DESCRIBED ACCORDING
TO THE OFFICIAL RECORDS, AND THAT THE PLAT HEREON
IS A CORRECT REPRESENTATION OF THE LOT LINES.

Harold H. Kolb

HAROLD H. KOLB

WISCONSIN REGISTERED LAND SURVEYOR, S-187

DATE August 2, 1973

HAS-29A

40-193