


HAROLD H. KOLB

REGISTERED PROFESSIONAL LAND SURVEYOR
LAKE GENEVA, WISCONSIN



N

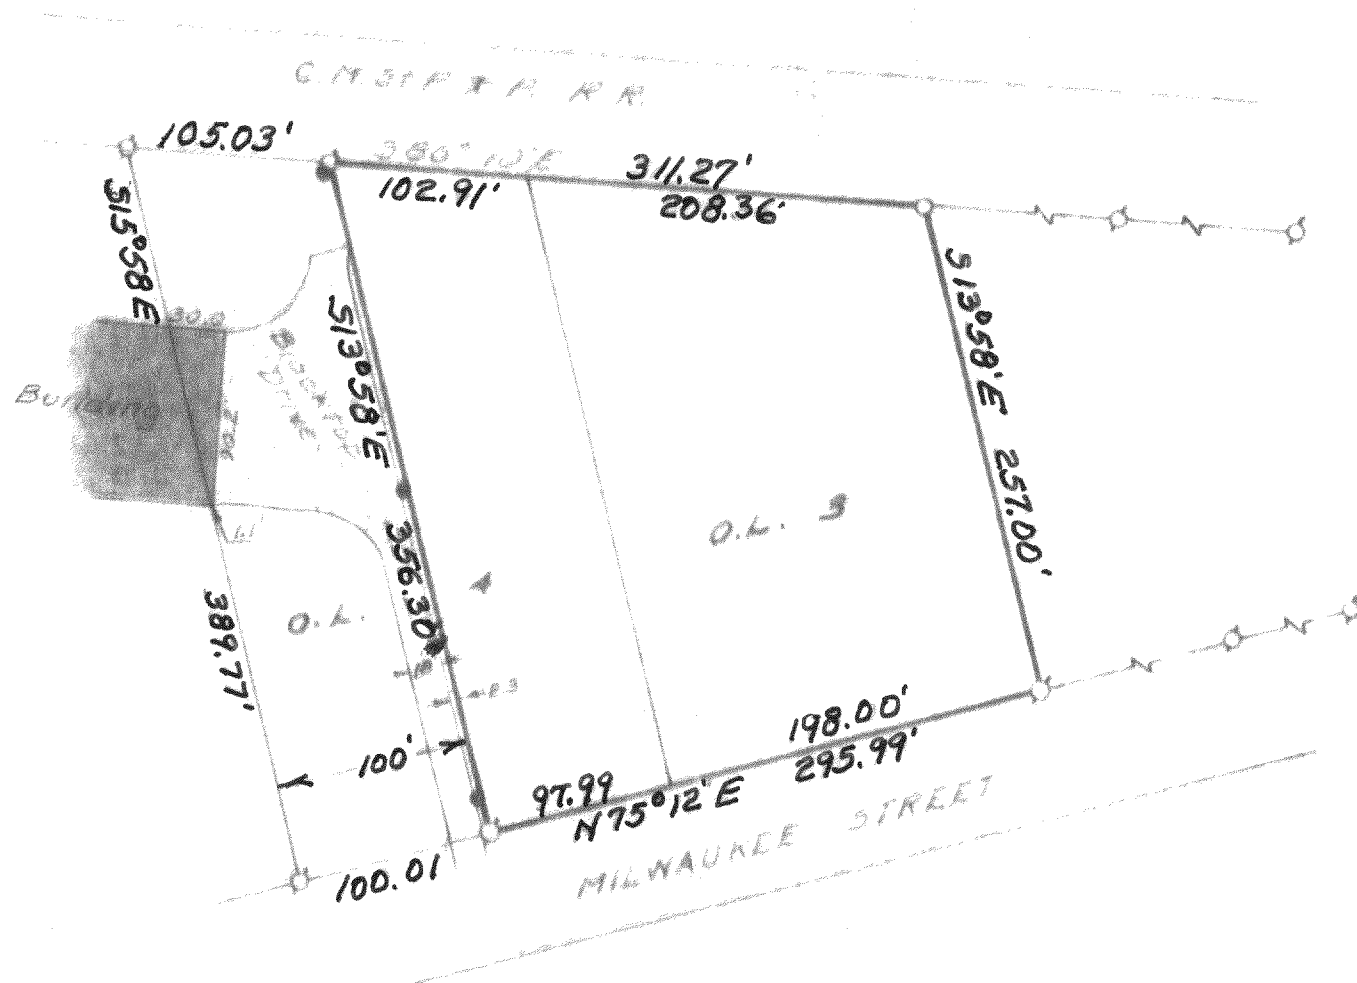

SCALE 1"=100'

LEGEND

- ⌀ - IRON PIPE FOUND
- - IRON PIPE PLACED
- - POWER POLE
- X - SPIKE

PLAT OF SURVEY OF
Outlots 3 and 4, S.C. Hall's Addition to
the Village, now City, of Whitewater,
Walworth County, Wisconsin.

I, HAROLD H. KOLB, DO HEREBY CERTIFY THAT I HAVE
SURVEYED THE PROPERTY HEREON DESCRIBED ACCORDING
TO THE OFFICIAL RECORDS, AND THAT THE PLAT HEREON
IS A CORRECT REPRESENTATION OF THE LOT LINES.

Harold H. Kolb

HAROLD H. KOLB

WISCONSIN REGISTERED LAND SURVEYOR, S-187

DATE May 31, 1967

10-177

HAS-69B