


N
 SCALE - 1" = 20'
 O = IRON PIPE

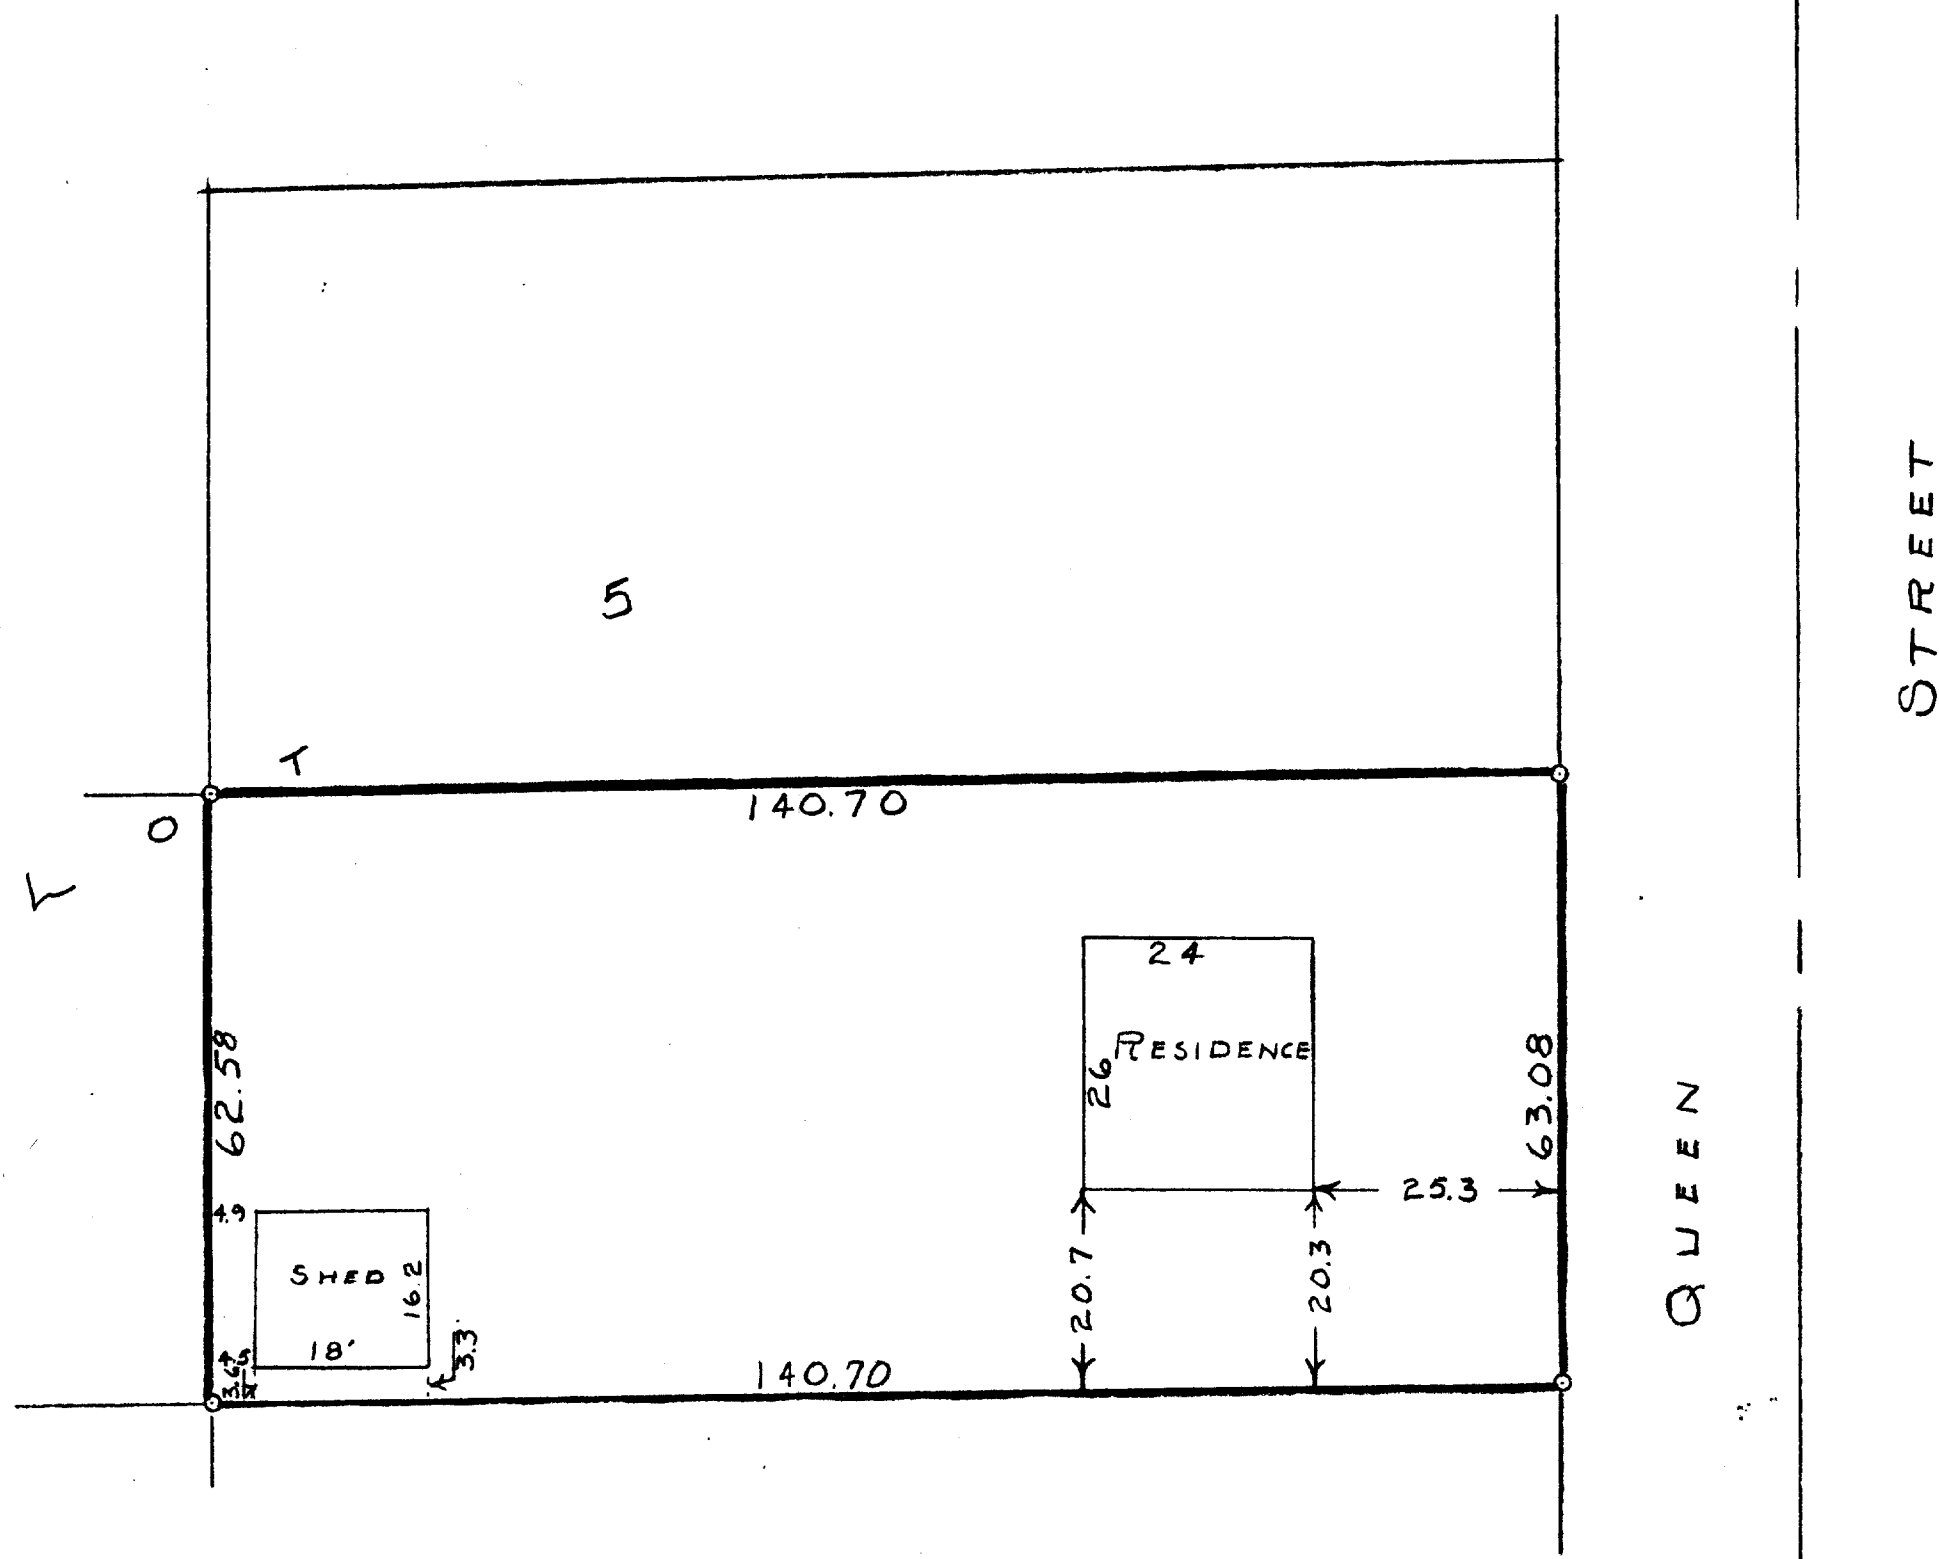

STATE OF WISCONSIN)
 COUNTY OF WALWORTH)

I, GEORGE T. DUNHAM, DO HEREBY CERTIFY THAT I HAVE SURVEYED
 THE PROPERTY, DESCRIBED AS FOLLOWS:

THE SOUTH 1/2 OF THE EAST 1/2 OF LOT 5, BLOCK 1 OF CORYDEN
 PRATTS ADDITION TO THE VILLAGE, (NOW CITY) OF WHITEWATER,
 WALWORTH COUNTY, WISCONSIN

AND THAT THE PLAT SHOWN ABOVE IS A CORRECT REPRESENTATION OF THE
 PROPERTY LINES
 NOV. 23, 1955

George T. Dunham
 GEORGE T. DUNHAM, SURVEYOR
 DELAVAN, WISCONSIN

10-18