


REGISTERED PROFESSIONAL LAND SURVEYOR
LAKE GENEVA, WISCONSIN
STARIN ROAD



N

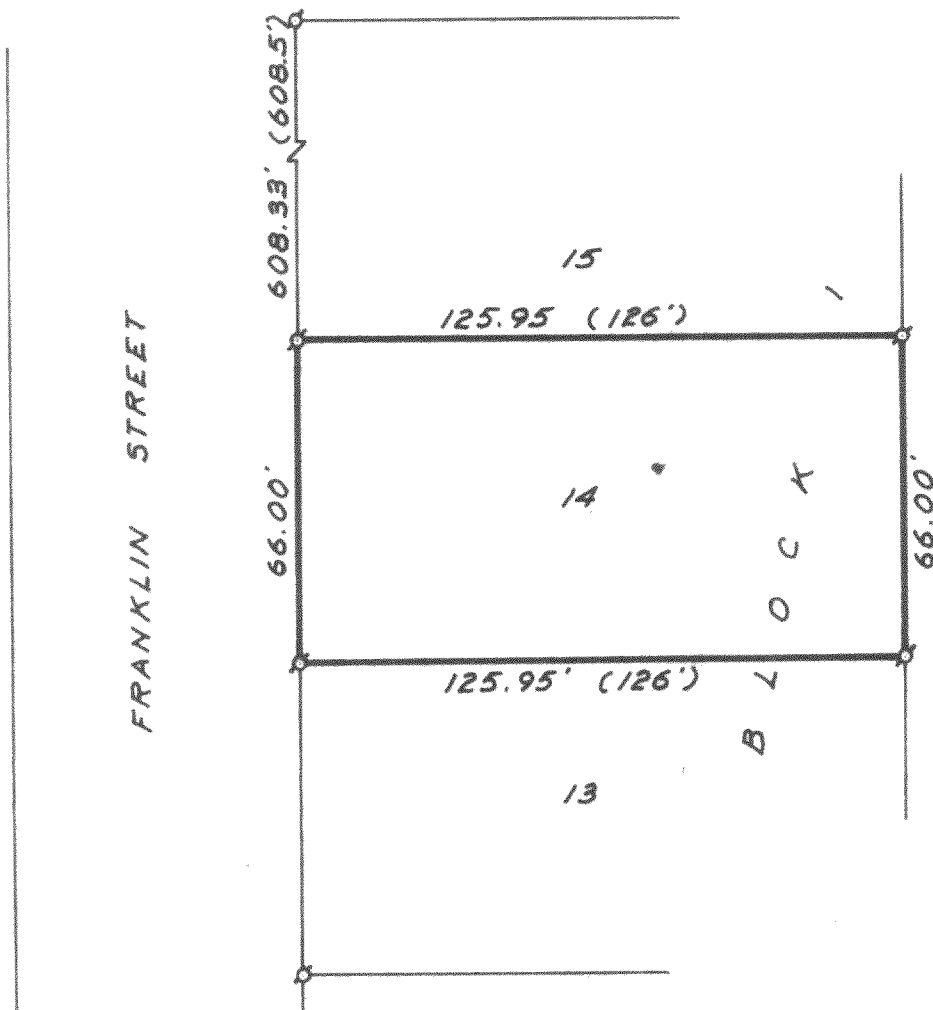

SCALE 1"=40'

LEGEND

- Ø — IRON PIPE FOUND
 O — IRON PIPE PLACED
 ● — CONCRETE MONUMENT
 X — SPIKE
 () — PLATTED DISTANCE

PLAT OF SURVEY OF

Lot 14, block 1, Cooper and Cox's Addition
to the City of Whitewater, Walworth County,
Wisconsin.

I, HAROLD H. KOLB, DO HEREBY CERTIFY THAT I HAVE SURVEYED THE PROPERTY HEREON DESCRIBED ACCORDING TO THE OFFICIAL RECORDS, AND THAT THE PLAT HEREON IS A CORRECT REPRESENTATION OF THE LOT LINES.

Harold W. Kolk

HAROLD H. KOLB

WISCONSIN REGISTERED LAND SURVEYOR, S-187

DATE October 15, 1965