


HAROLD H. KOLB
REGISTERED PROFESSIONAL LAND SURVEYOR
LAKE GENEVA, WISCONSIN

SUMMIT STREET

HIGH STREET

NOTE: Iron pipe set
1.00' West of corner


COTTAGE STREET

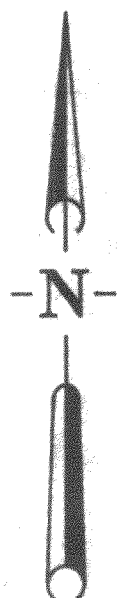

SCALE 1"=40'

- Iron Pipe Found
- Iron Pipe Placed

CL-68 68A 68B

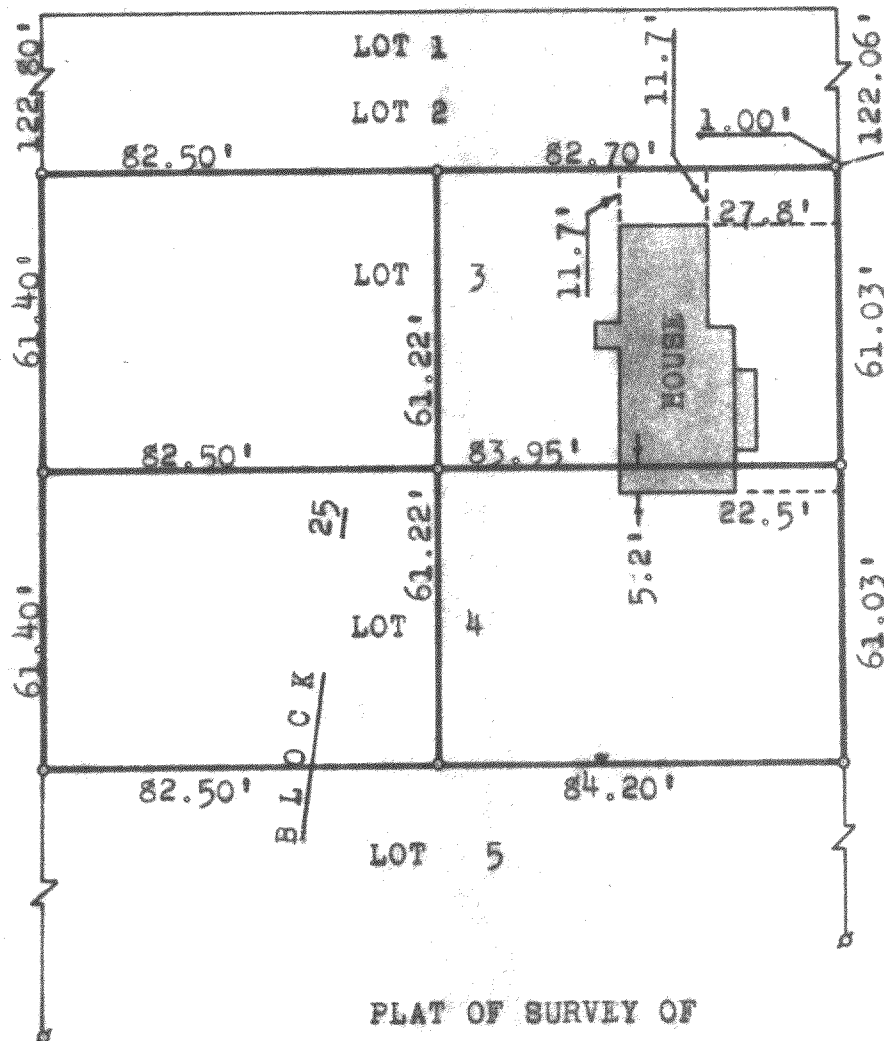

Lots 3 and 4, Block 25, Chapman &
Ludington's Addition to the Village
(Now City) of Whitewater, Walworth
County, Wisconsin.

Harold H. Kolb

Harold H. Kolb, Wisconsin Surveyor, S-187
DATE: March 28, 1964

10-199