



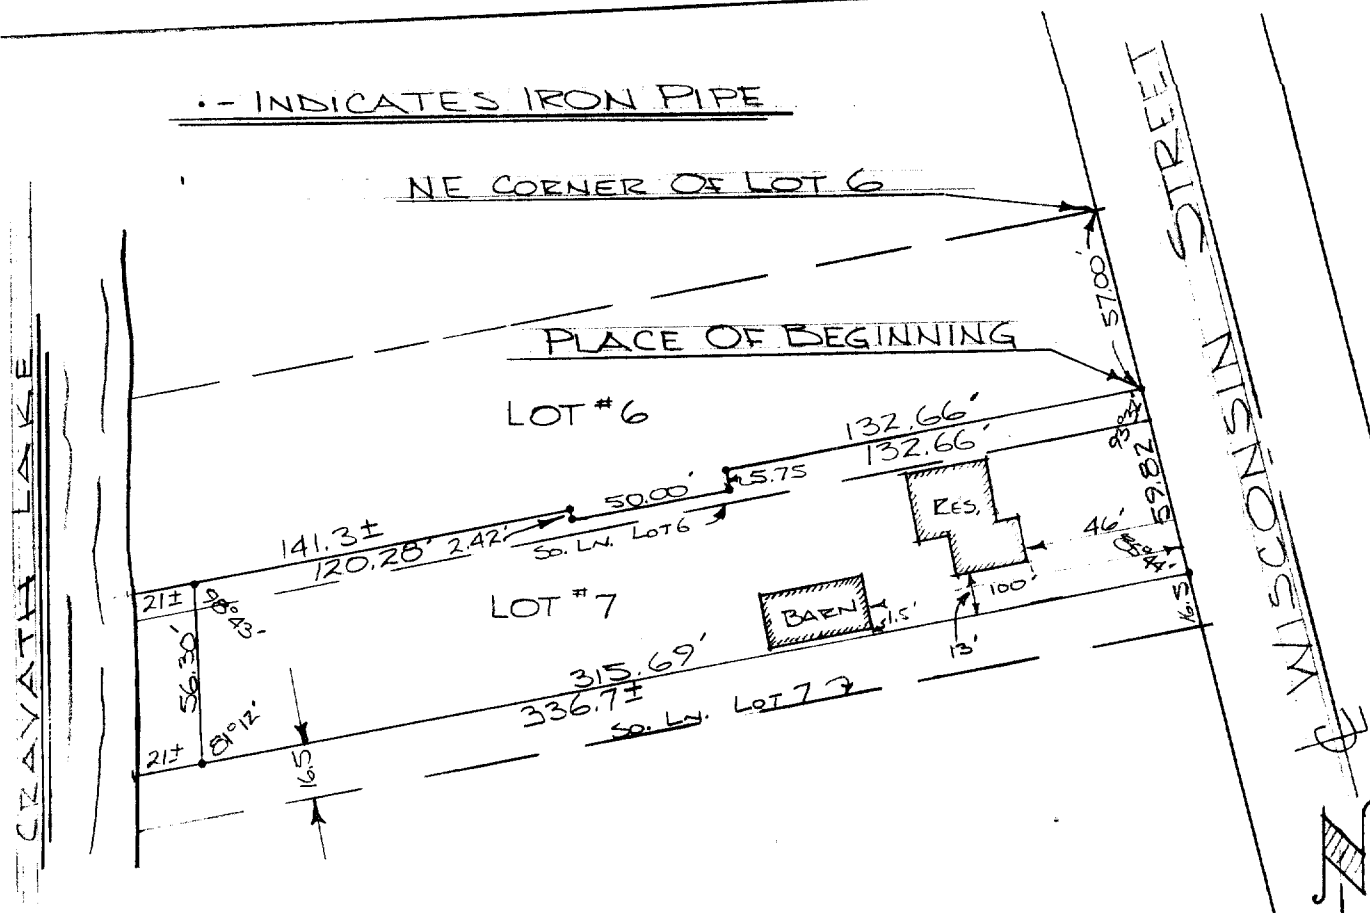

DESCRIPTION: Commencing at a point in the East line of Lot 6 that is 57.00 feet South of the NE corner of Lot 6 of Block 4 of Tripps Second Addition to the City of Whitewater, Walworth County, Wisconsin; thence West 132.66 feet, thence South 5.75 feet, thence West 50.00 feet, thence north 2.42 feet, thence West parallel to the north line of Lot 6, 141.30 feet more or less to the shore of Cravath Lake, thence southerly along said shore line 56.3 feet more or less to a point that is 16.50 feet north of the south line of Lot 7, thence East parallel to and 16.50 feet north of the south line of lot 7, 336.70 feet more or less to the east line of lot 7, thence North along the east line of lot 7, 59.82 feet to the place of beginning.

CERTIFICATE: I, James F. Biagi, surveyor, do hereby certify that I have surveyed the property hereon described and that the location of the improvements are as shown.

August 6, 1969.

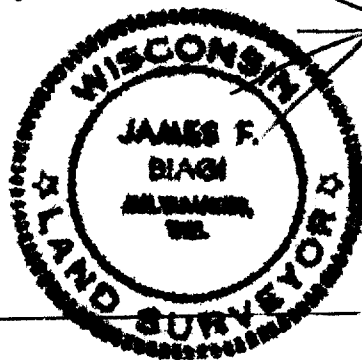

James F. Biagi R.L.S. 272