


SW Cor. of
Summit & Post

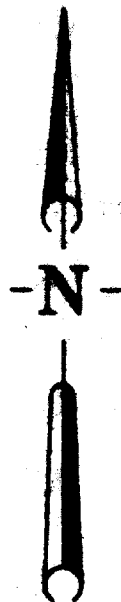

SUMMIT STREET

264.00' to NW Cor. Blk 26

66.00'

SW Cor of
Center Cottage

- NW Cor. of
High & Cottage

167.83'

4

১৬

167.91

•

BLOCK

COTTAGE STREET

SE Cor. of
High v Cottage

NE Cor of
Rock & Cottage

Lot 5, Block 26, Chapman & Ludington's Addition to the Village (Now City) of Whitewater, Walworth County, Wisconsin.

Harold H. Kalk

Harold N. Kolb, Wis. Surveyor, 8-187
DATE: December 13, 1963

NOTE: Iron pipe along Cottage placed
1.00 feet West of Lot corners.

- x - Cross in Conc. Found
- # - Iron Pipe Found
- - Iron Pipe Found

10-205