


FORT ATKINSON, WISCONSIN

Sec. 4 T 4 N R 15 E

Description—

Lot 1, Block 1, Esterley's addition to the City of Whitewater, Wisconsin.

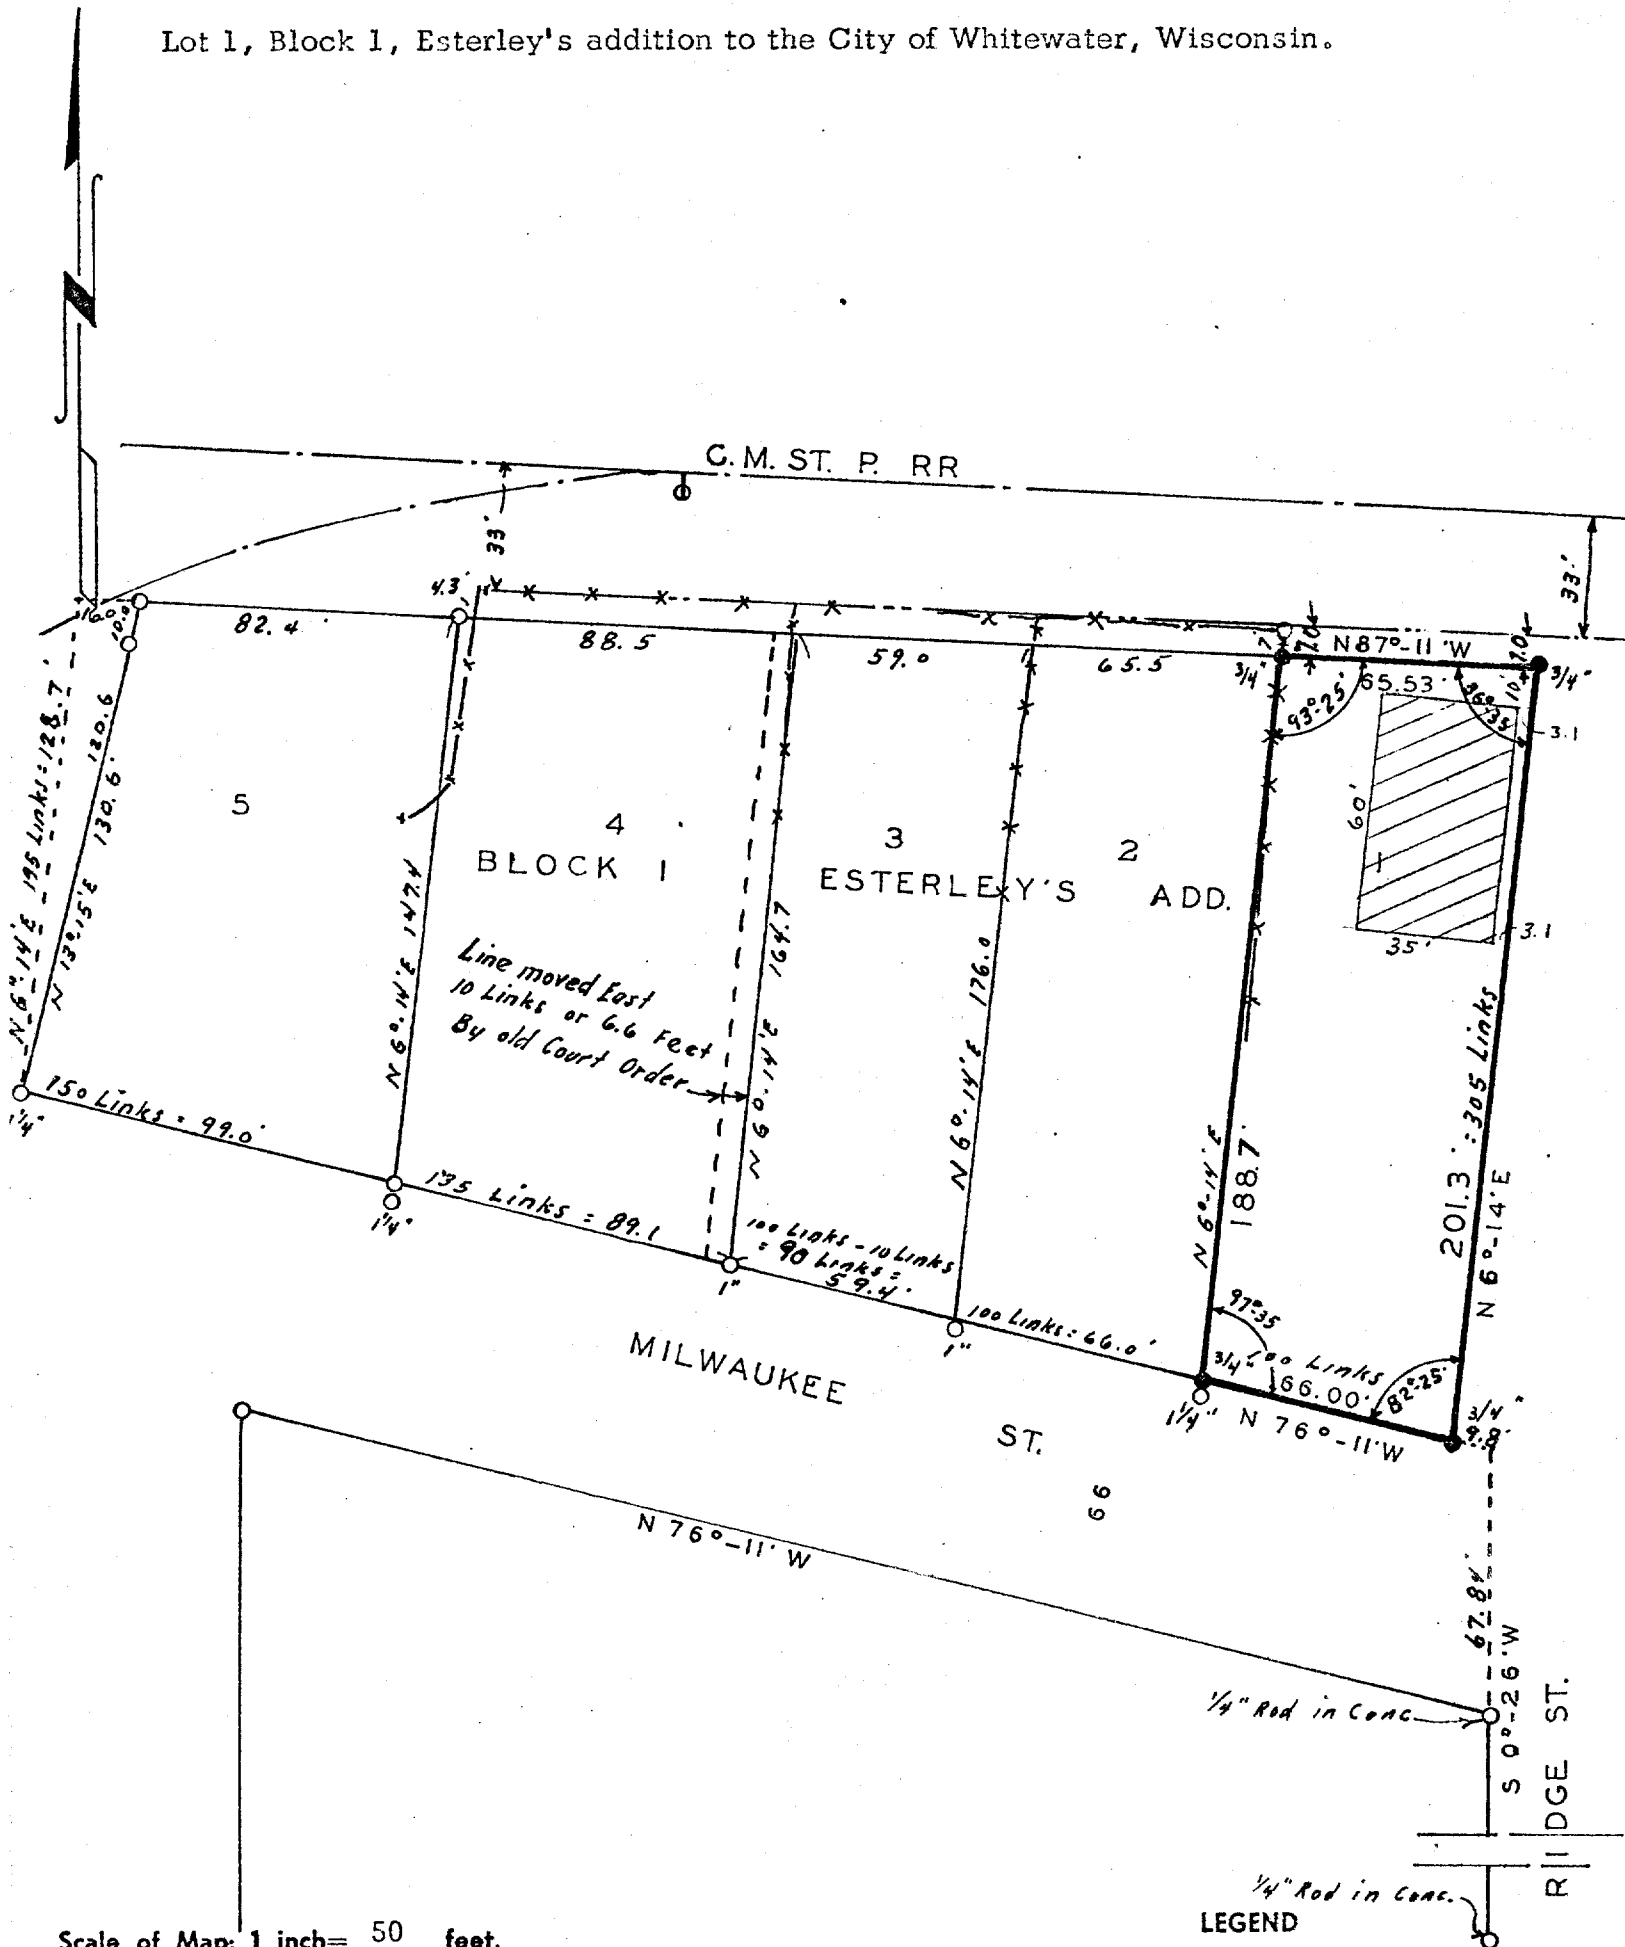

STATE OF WISCONSIN }
COUNTY OF JEFFERSON } SS.

I, David C. Knoerr a registered surveyor of the State of Wisconsin, do hereby certify that on 3-26-59 I surveyed the above described property according to official records and that the accompanying map is a correctly dimensioned representation to the scale of the boundaries, that all buildings and improvements lie wholly within the boundary lines, and that no encroachments by adjacent property owners appear from said survey.

David C. Knoers
SIGNATURE