




SCALE 1"=30'
0- IRON PIPE

STREET

PRAIRIE

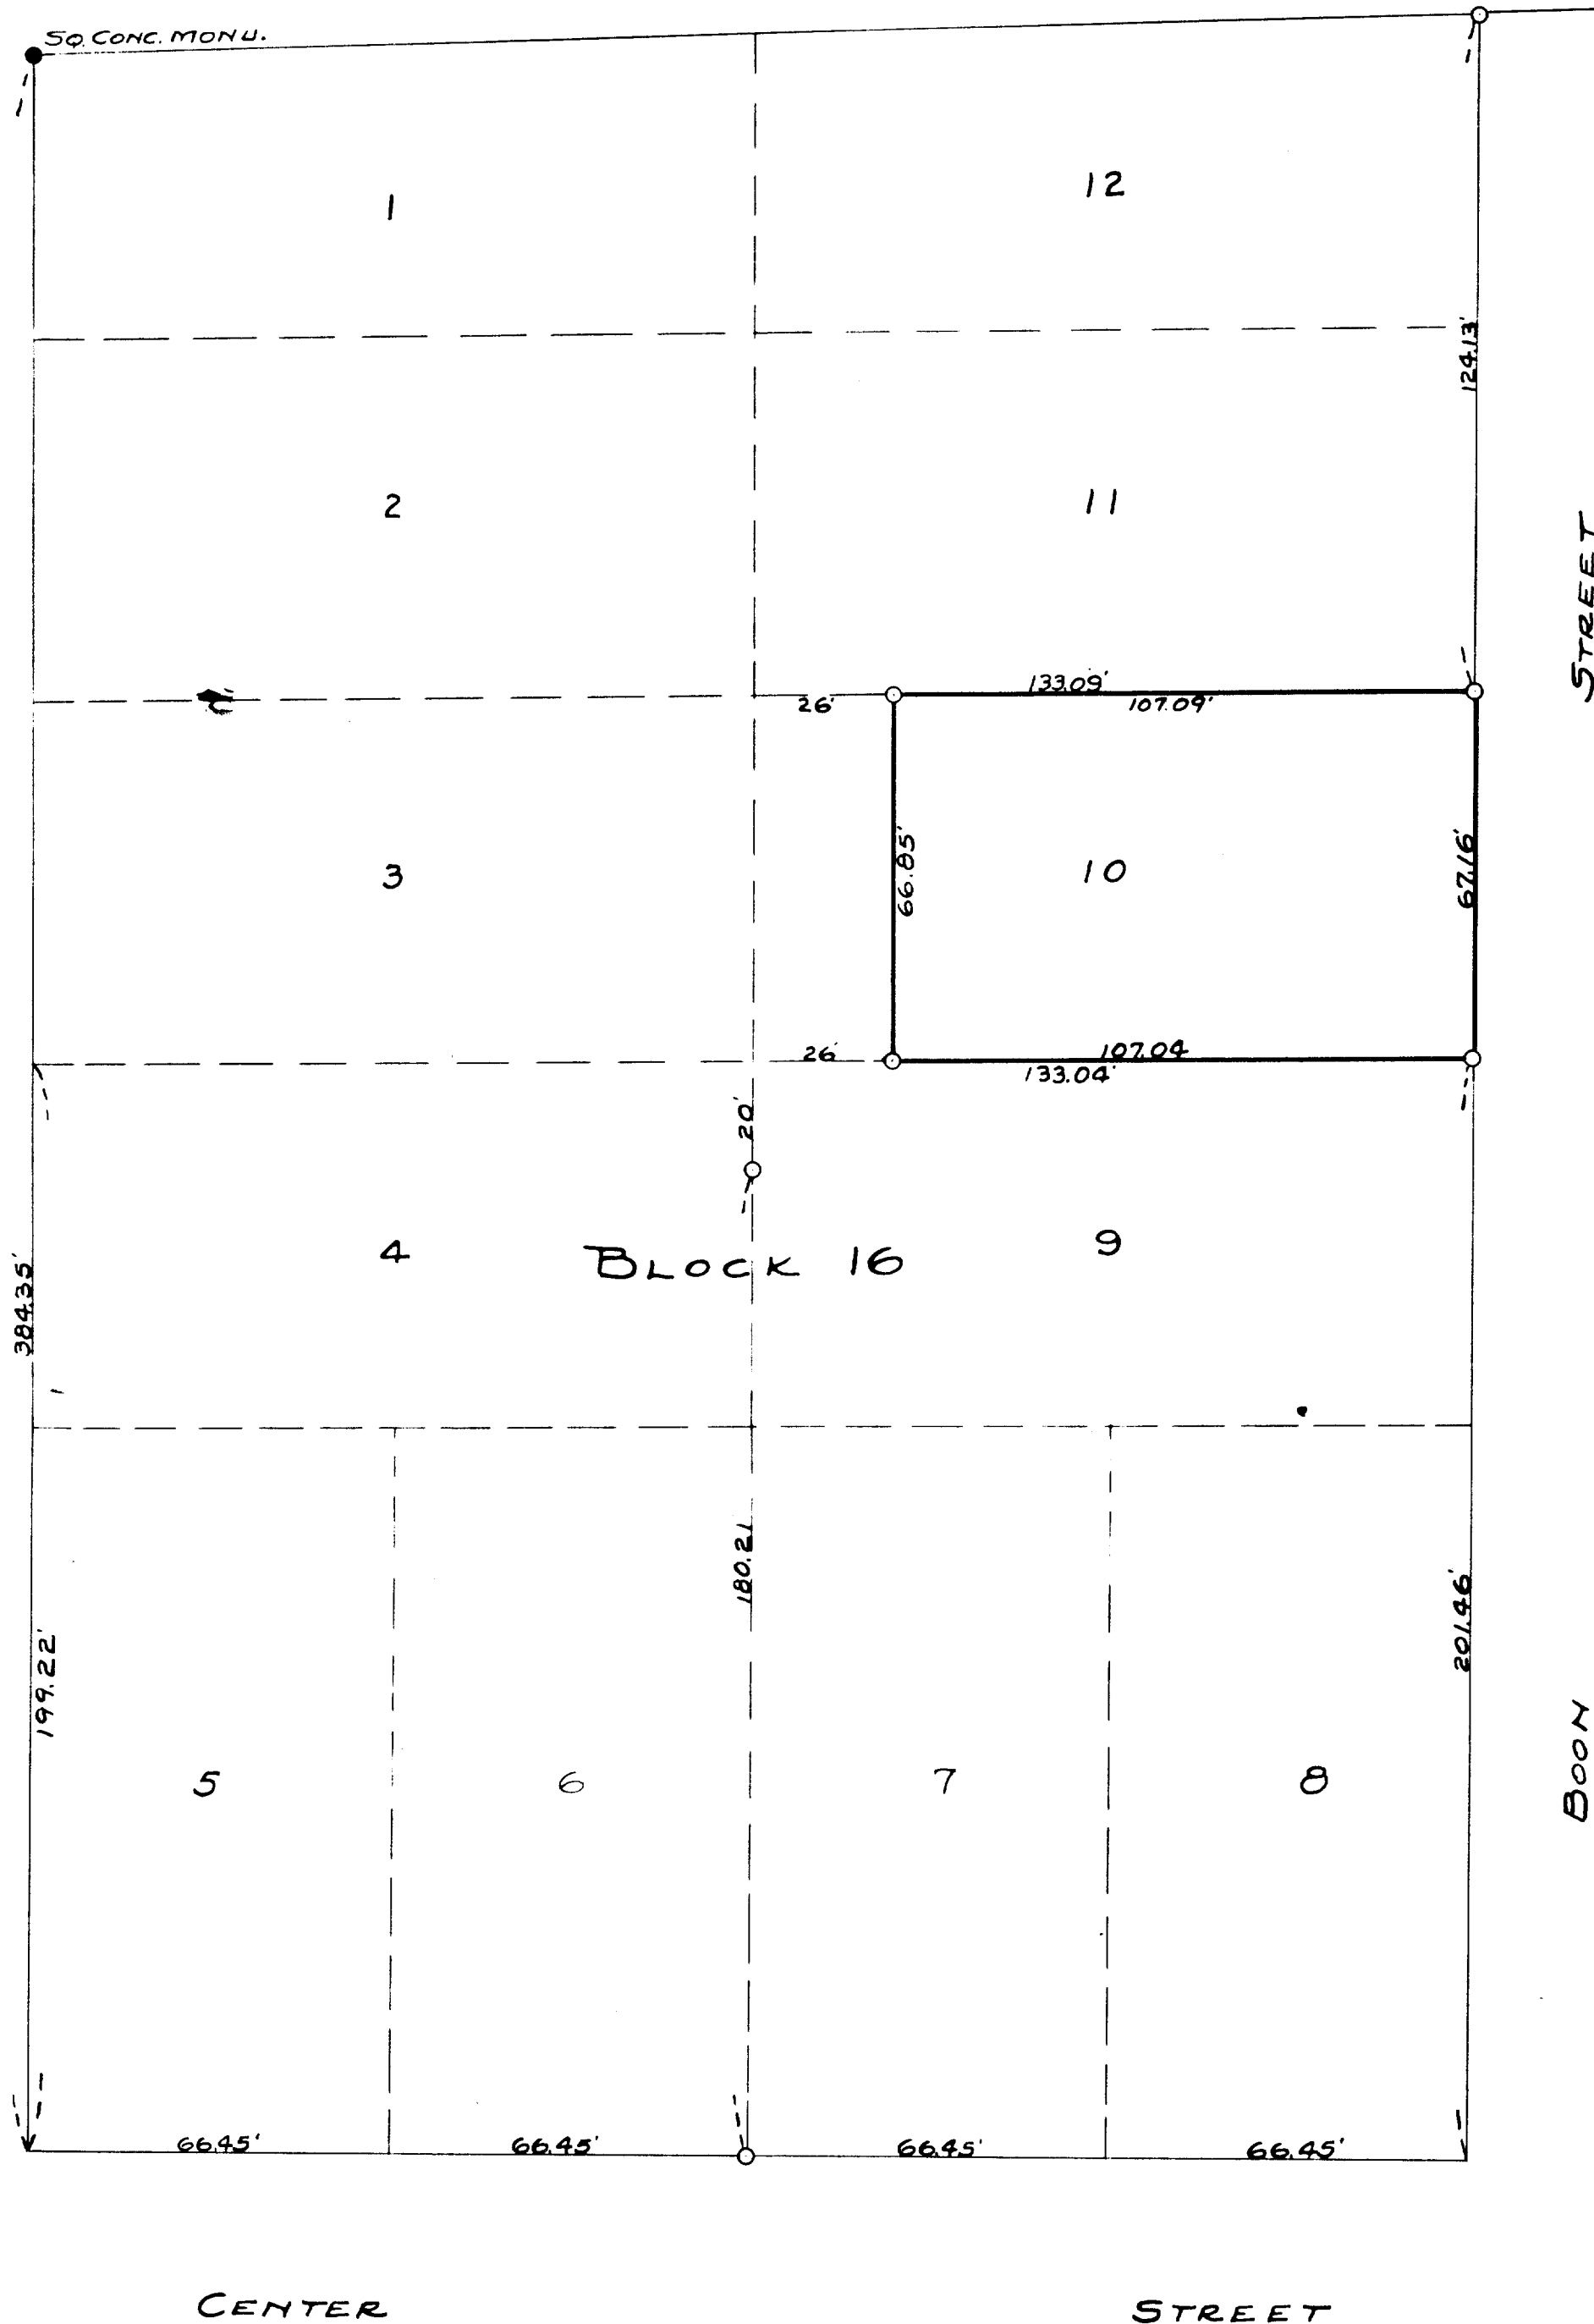

PLAT OF SURVEY OF LOT 10 OF BLOCK 16 OF CHAPMAN &
LUDINGTONS ADDITION TO THE CITY OF WHITEWATER,
WALWORTH COUNTY WISCONSIN, EXCEPT THE WEST 26 FEET
THERE OF,
FEB. 1940
Roy L. Jensen
COUNTY SURVEYOR