


HAROLD H. KOLB
REGISTERED PROFESSIONAL LAND SURVEYOR
LAKE GENEVA, WISCONSIN

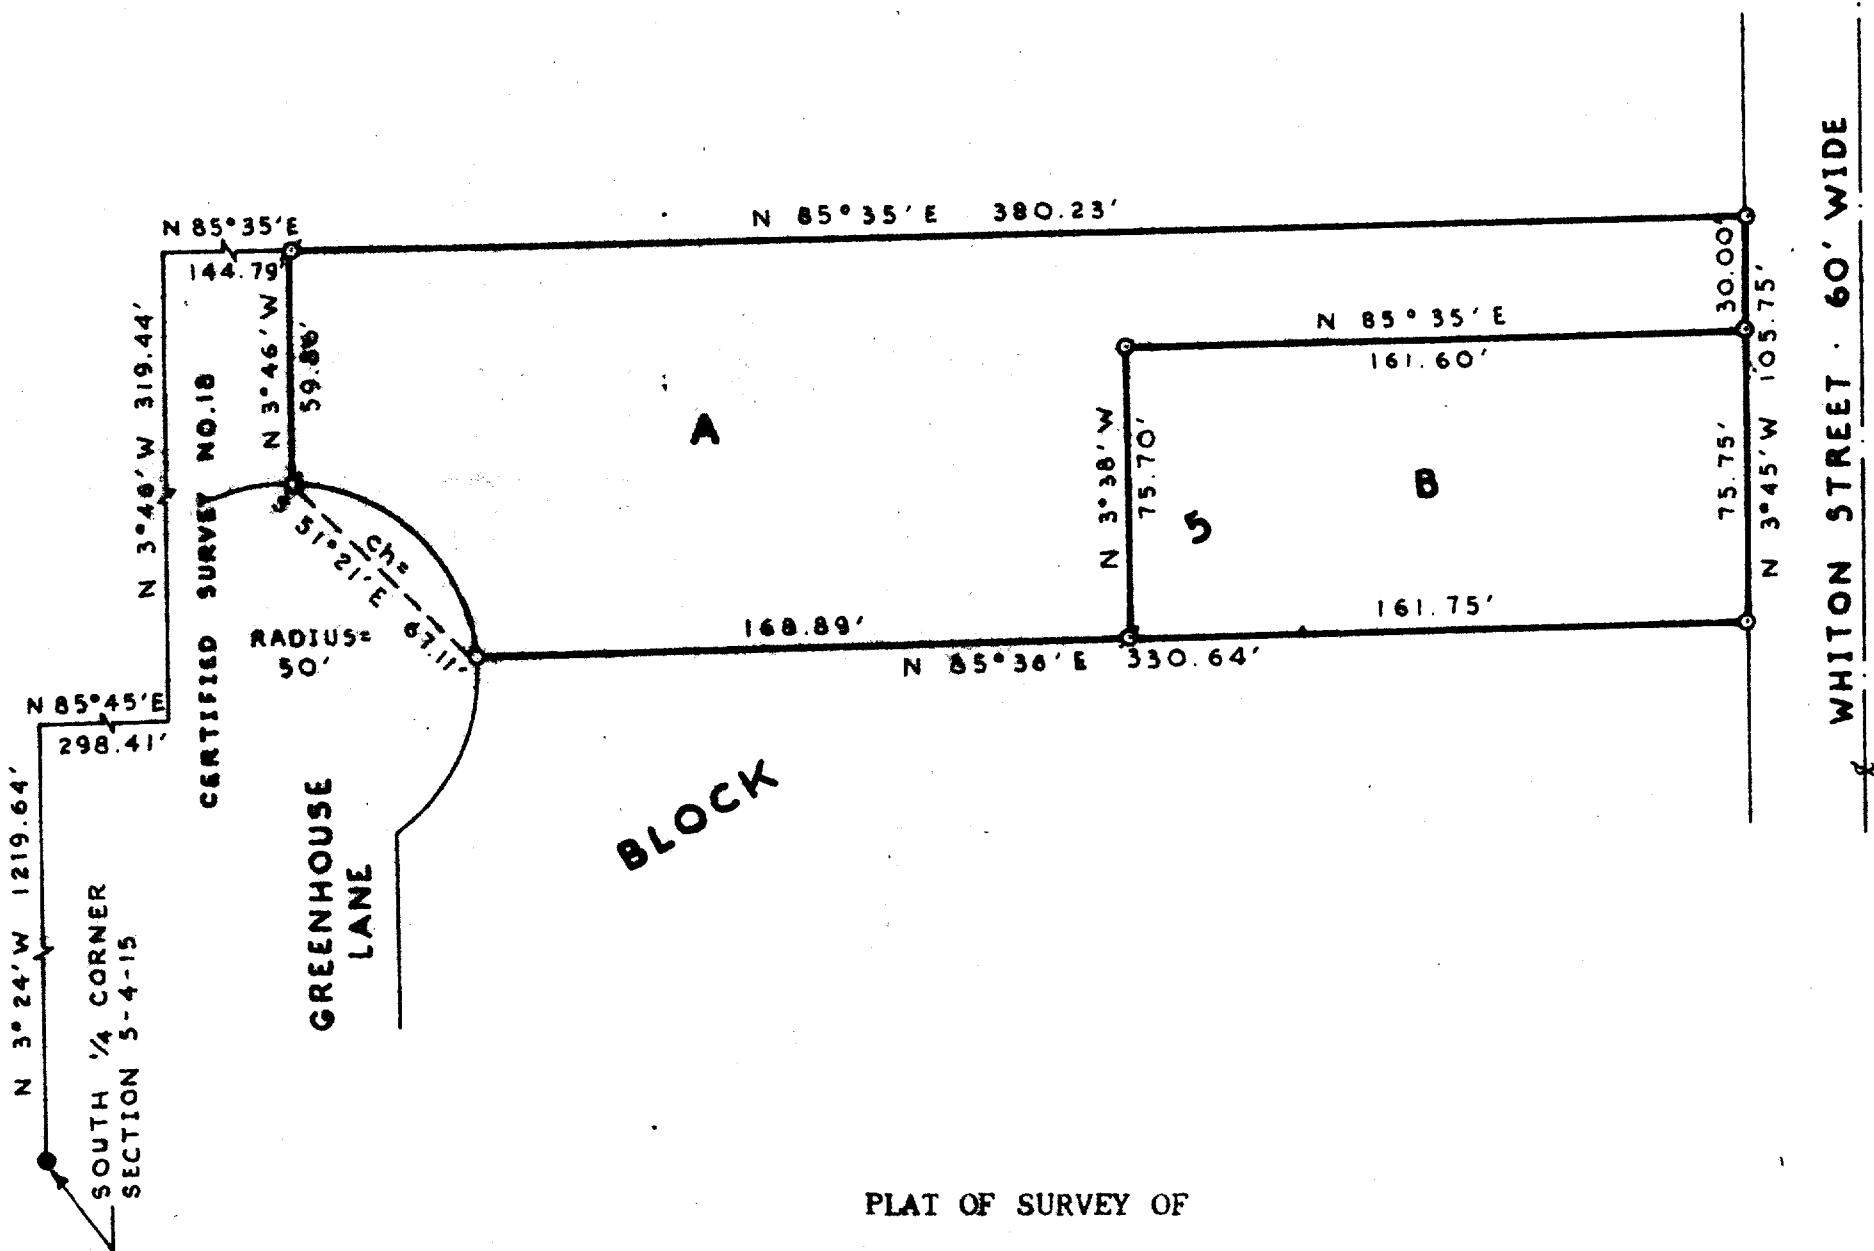

PLAT OF SURVEY OF

Two parcels of land located in Block 5 of Birge's Addition to the City of Whitewater, Walworth County, Wisconsin, and described as follows:

Parcel A: Commencing at the South $\frac{1}{4}$ of Section 5, T 4 N, R 15 E; thence N 3° 24' W 1219.64 feet; thence N 85° 45' E 298.41 feet; thence N 3° 46' W 319.44 feet; thence N 85° 35' E 144.79 feet to the place of beginning; thence continue N 85° 35' E 380.23 feet; thence S 3° 45' E 30.00 feet; thence S 85° 35' W 161.60 feet; thence S 3° 38' E 75.70 feet; thence S 85° 36' W 168.89 feet; thence along the arc of a curve to the left with a chord of N 51° 21' W 67.11 feet and a radius of 50 feet; thence N 3° 46' W 59.86 feet to the place of beginning.

Parcel B: Commencing at the South $\frac{1}{4}$ of Section 5, T 4 N, R 15 E; thence N 3° 24' W 1219.64 feet; thence N 85° 45' E 298.41 feet; thence N 3° 46' W 319.44 feet; thence N 85° 35' E 525.02 feet; thence S 3° 45' E 30.00 feet to the place of beginning; thence continue S 3° 45' E 75.75 feet; thence S 85° 36' W 161.75 feet; thence N 3° 38' W 75.70 feet; thence N 85° 35' E 161.60 feet to the place of beginning.

Note: Bearings are true by solar observation as shown on City of Whitewater Plats.



LEGEND

- ⊙ - IRON PIPE FOUND
- - IRON PIPE PLACED
- - CONCRETE MONUMENT
- ✕ - SPIKE



I, HAROLD H. KOLB, DO HEREBY CERTIFY THAT I HAVE SURVEYED THE PROPERTY HEREON DESCRIBED ACCORDING TO THE OFFICIAL RECORDS, AND THAT THE PLAT HEREON IS A CORRECT REPRESENTATION OF THE LOT LINES.

Harold H. Kolb
HAROLD H. KOLB

WISCONSIN REGISTERED LAND SURVEYOR, S-187
DATE May 30, 1972