



HAROLD H. KOLB
 REGISTERED PROFESSIONAL LAND SURVEYOR
 LAKE GENEVA, WISCONSIN

Note: We have found two locations for George Street staked in the field. We have used the location where we found the majority of stakes and those that appear to have been there the longest. City records and the original plat show George Street to be 50' wide.

GEORGE STREET - 50' WIDE

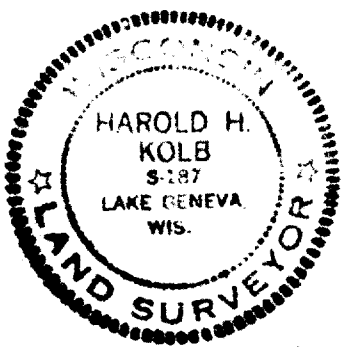

- LEGEND**
- ⌘ - IRON PIPE FOUND
 - - IRON PIPE PLACED
 - - CONCRETE MONUMENT FOUND
 - x - SPIKE
 - () - AS RECORDED

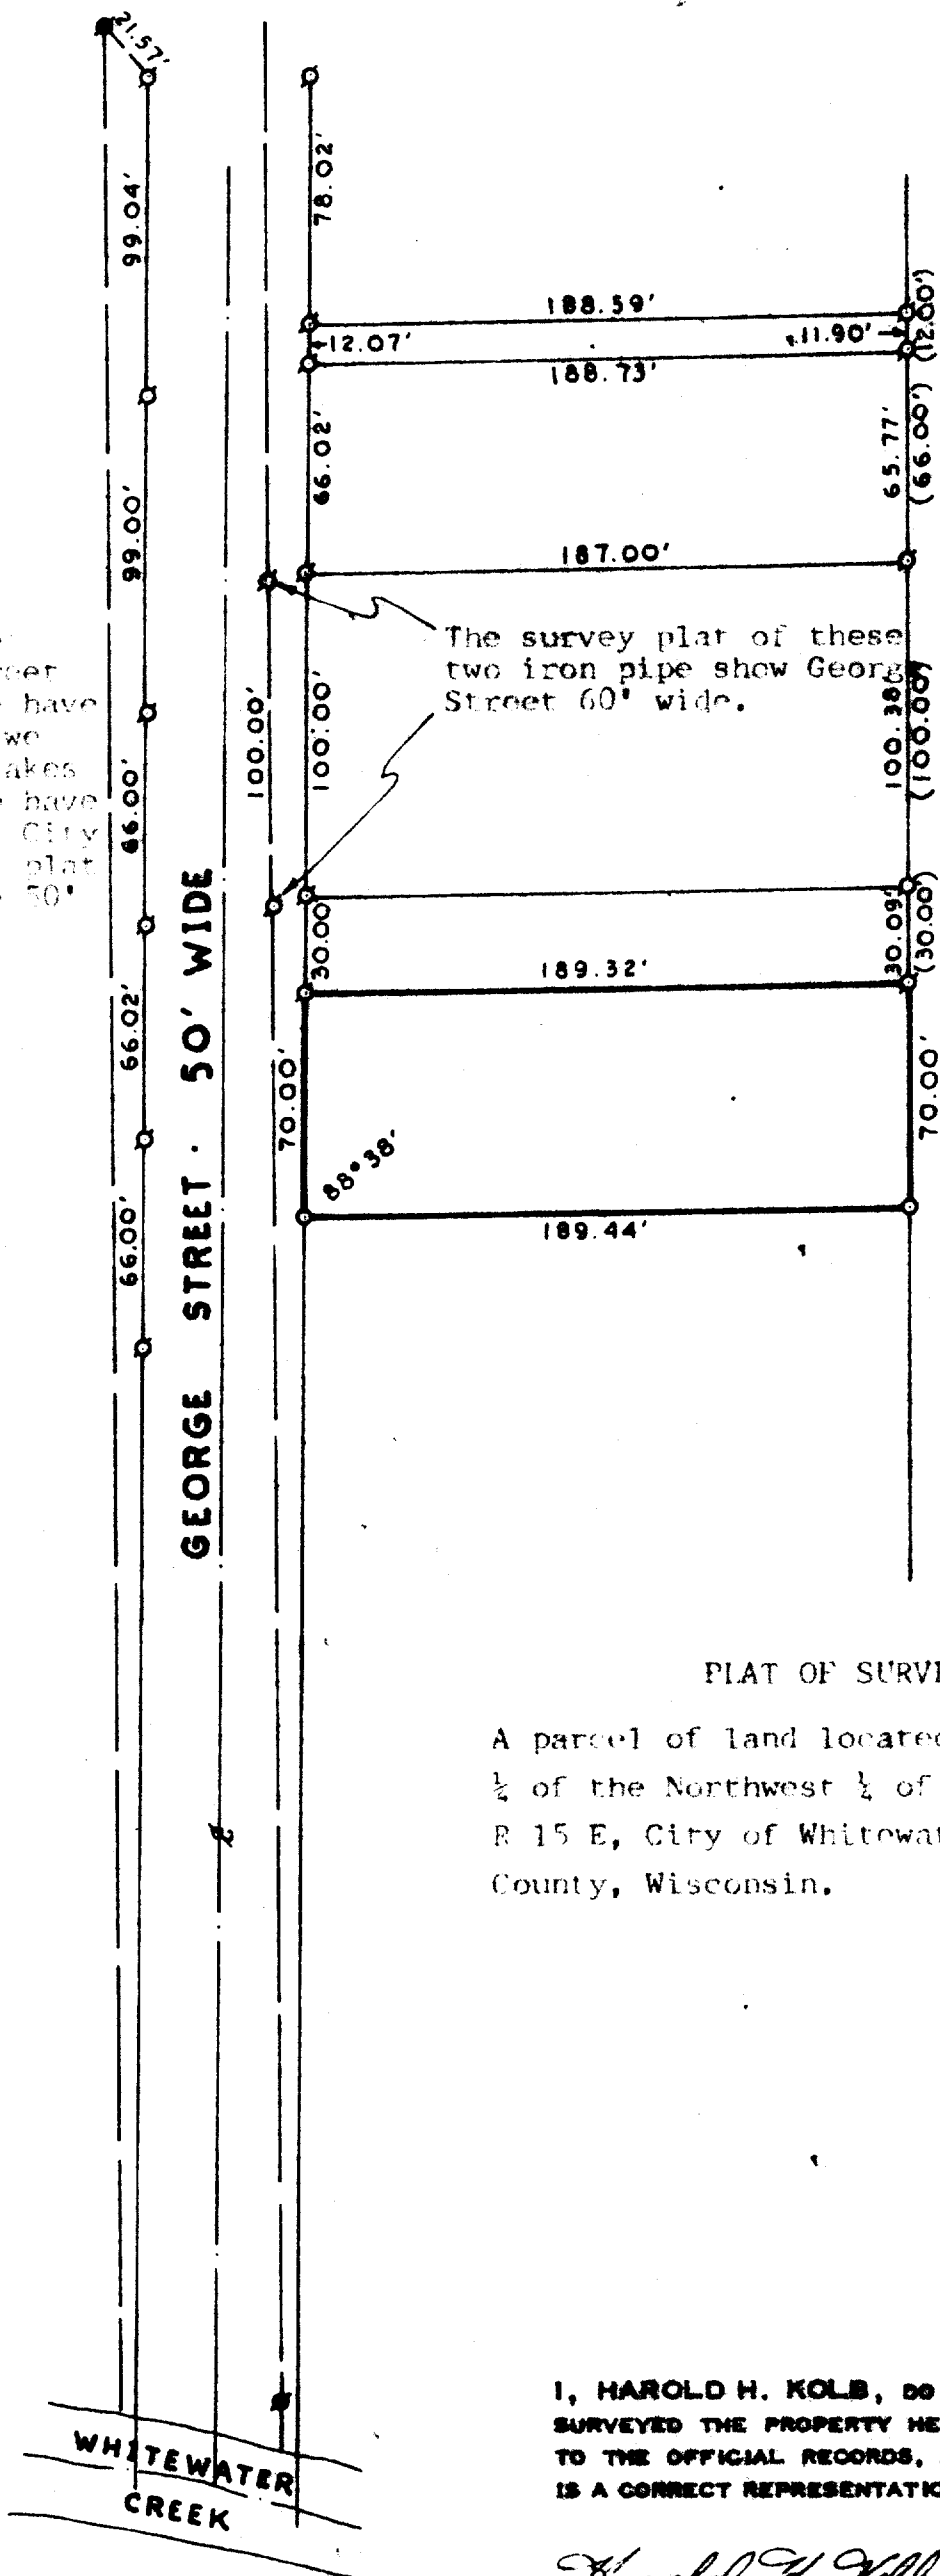

PLAT OF SURVEY OF

A parcel of land located in the Southeast 1/4 of the Northwest 1/4 of Section 4, T 4 N, R 15 E, City of Whitewater, Walworth County, Wisconsin.

I, HAROLD H. KOLB, DO HEREBY CERTIFY THAT I HAVE SURVEYED THE PROPERTY HEREON DESCRIBED ACCORDING TO THE OFFICIAL RECORDS, AND THAT THE PLAT HEREON IS A CORRECT REPRESENTATION OF THE LOT LINES.

Harold H. Kolb

HAROLD H. KOLB
 WISCONSIN REGISTERED LAND SURVEYOR, S-187
 DATE August 17, 1972

WSS-61E + 61G
 61F

10-218
 415-102