


N

 SCALE=1"=50'
 O=IRON PIPE

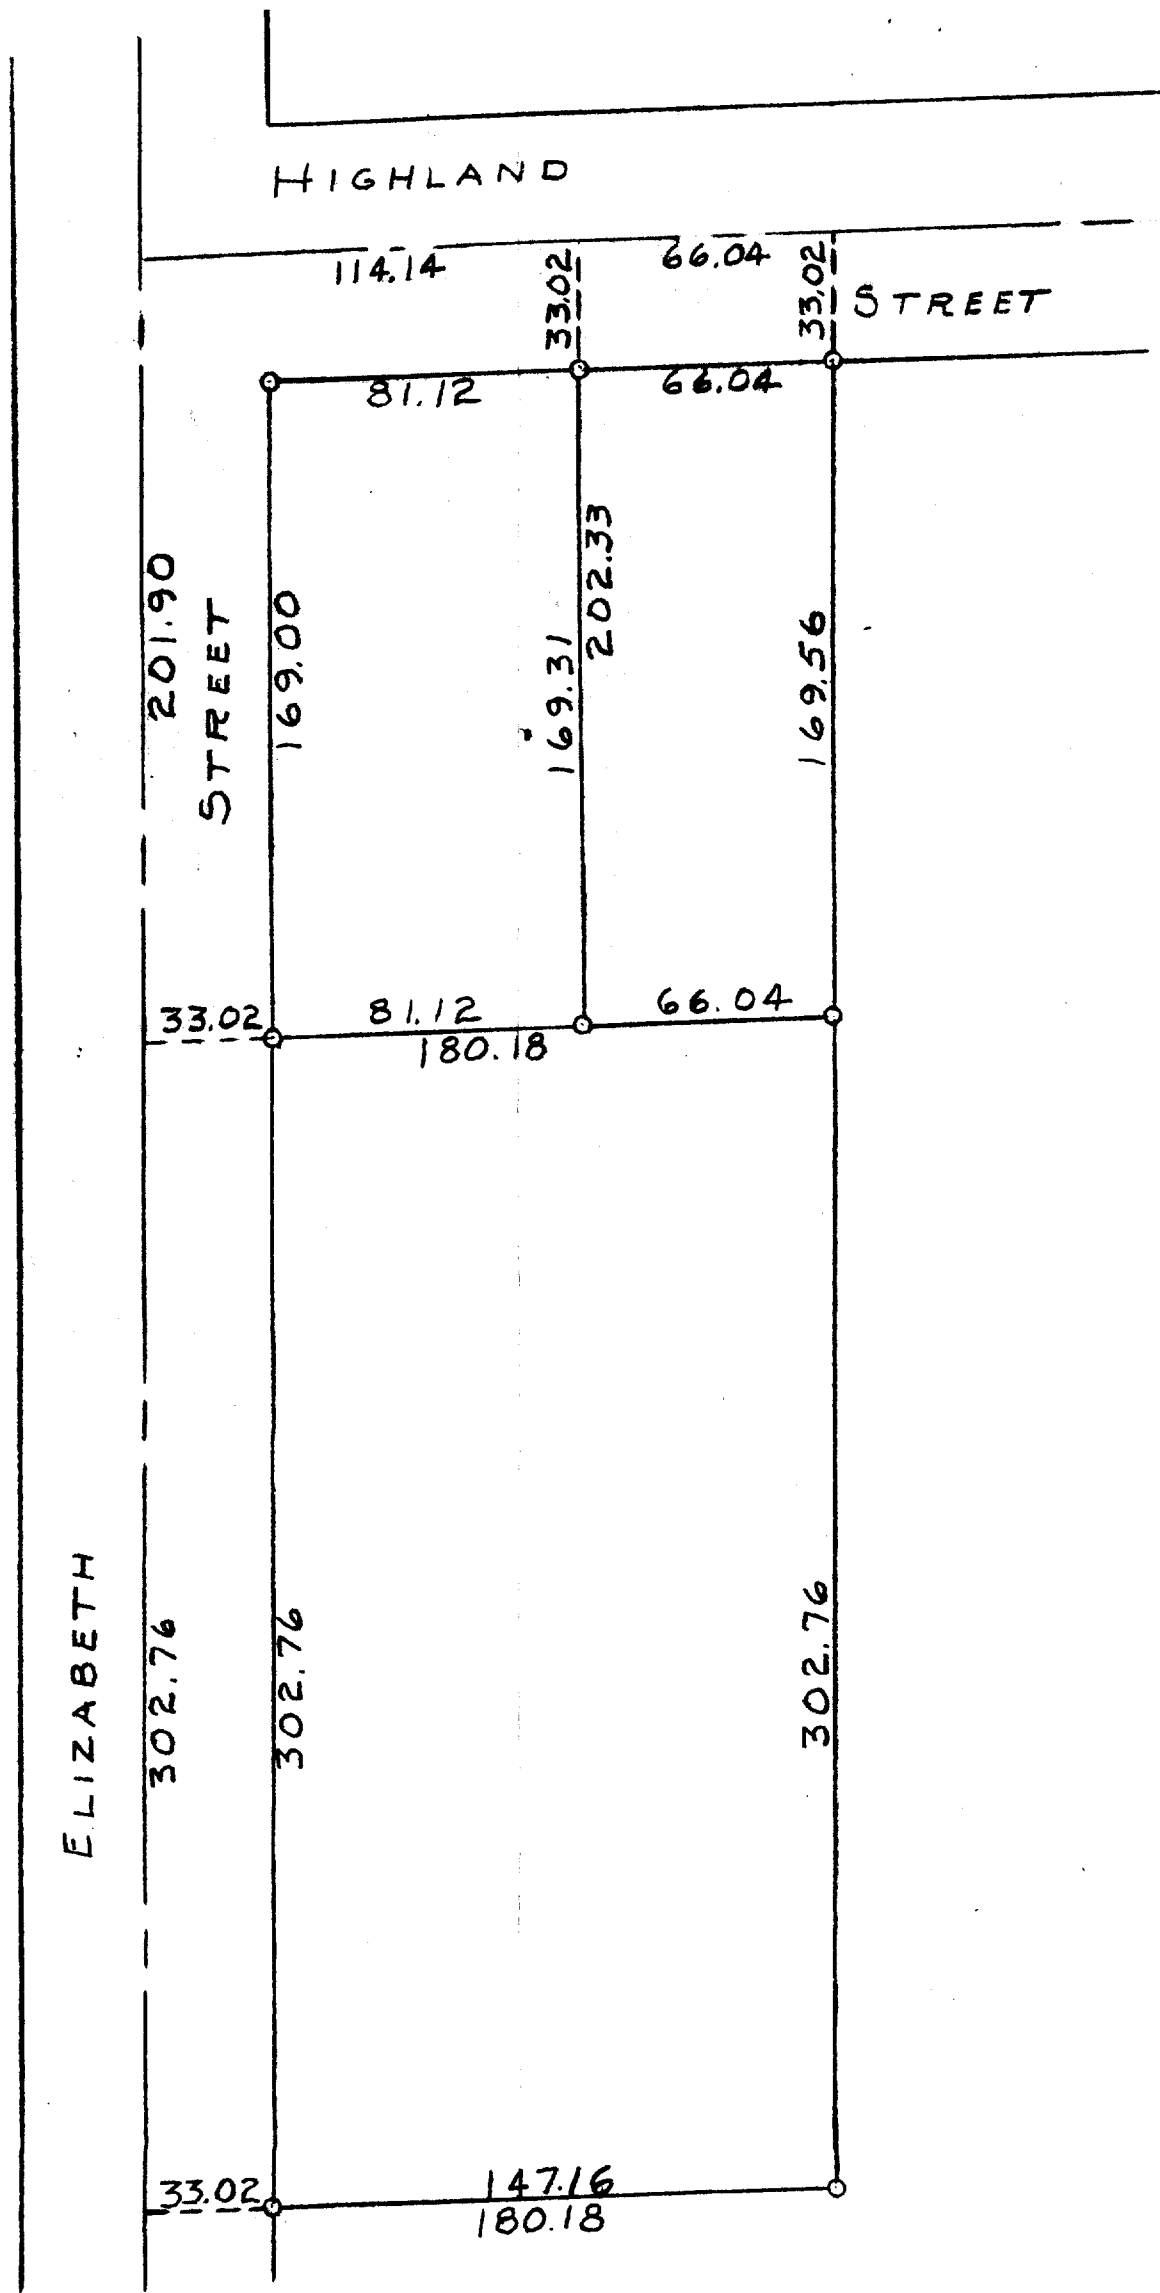

PLAT OF SURVEY OF A PARCEL OF LAND LOCATED IN THE SOUTHWEST 1/4
 OF SECTION 5, T4N R15E, CITY OF WHITEWATER, WALWORTH COUNTY, WISCONSIN
 MAY 11, 1956

George T. Dunham
 GEORGE T. DUNHAM, SURVEYOR
 DELAVAN, WISCONSIN

10-22

UP-218A + C. & 586