


GEORGE T. DUNHAM
SURVEYING & SUBDIVIDING
DELAVAN, WISCONSIN



Scale - 1" = 20'
o = Iron Pipe

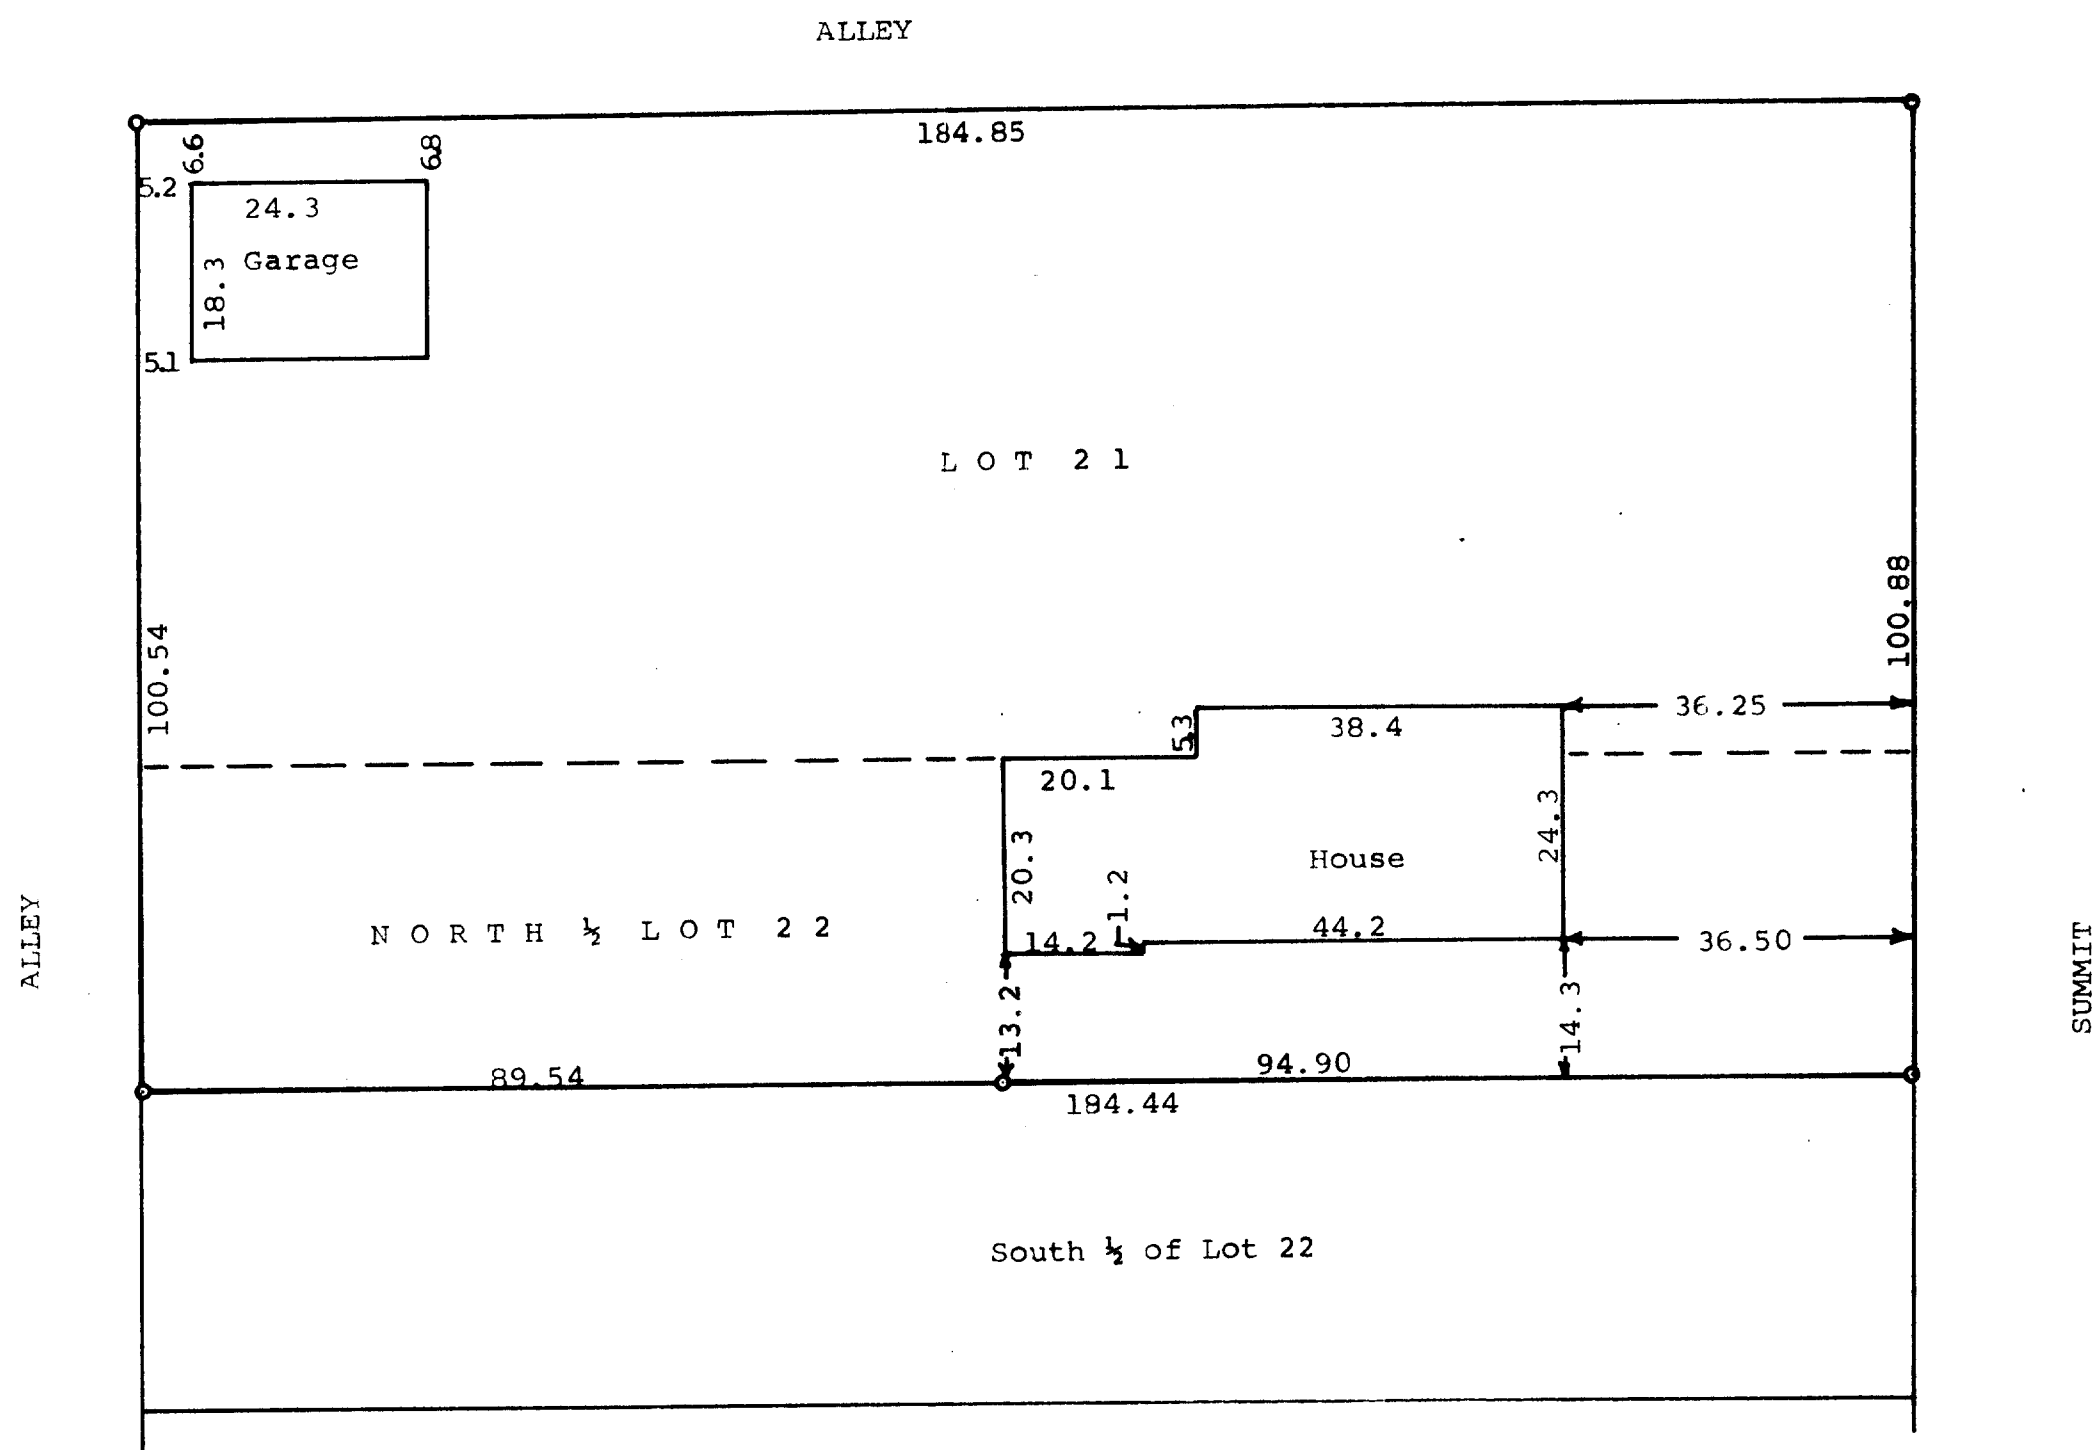

STATE OF WISCONSIN)
COUNTY OF WALWORTH) SS

I, George T. Dunham, Surveyor, certify that I have surveyed the property described as follows,

Lot 21 and the North 1/2 of Lot 22 in Block 2 of Birges' Addition to the Village (Now City) of Whitewater, Walworth County, Wisconsin, and that the above plat is an accurate survey and a true representation thereof and correctly shows the exterior boundary lines and location of buildings on said property and the correct measurements thereof.

October 1, 1973

George T. Dunham
George T. Dunham, Surveyor

