


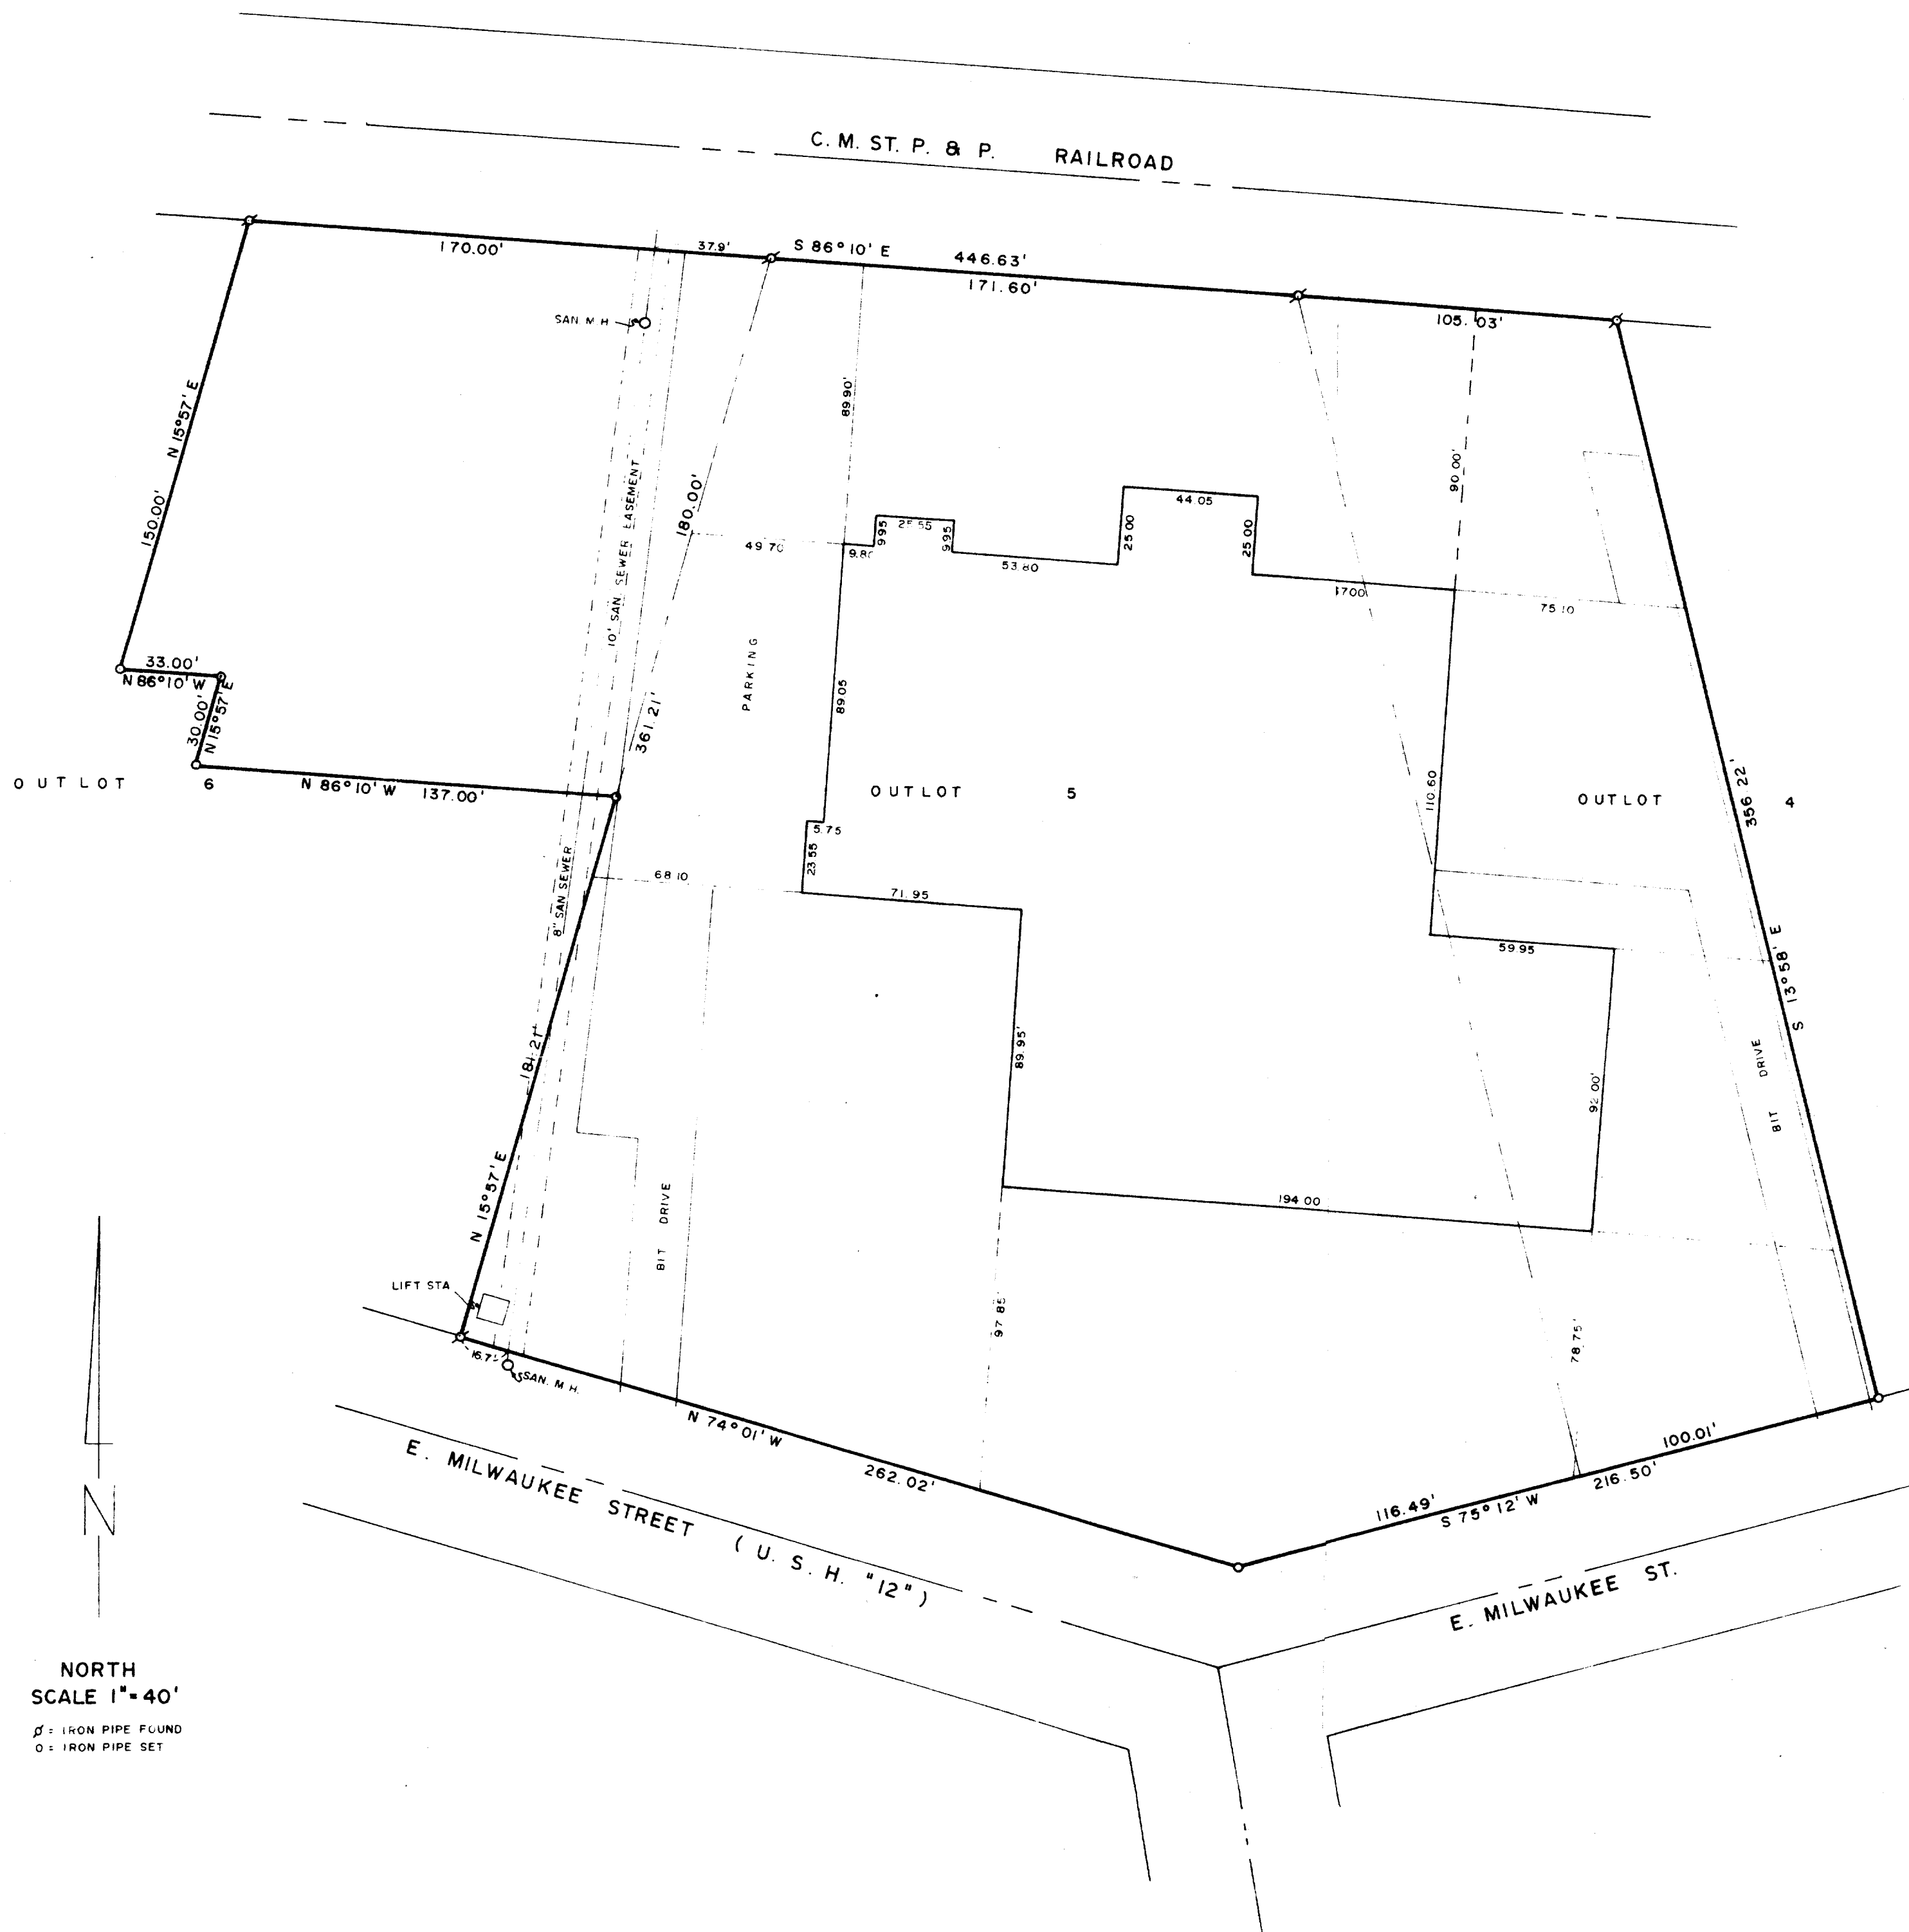

PLAT OF SURVEY

A PART of Outlot Number 6 in S. C. Hall's Addition to the Village, now City of Whitewater, described as follows: Commencing at a point on the E. line of Outlot 6, 180 feet Southwest of the Northeast corner of Outlot 6; running thence NE'ly along the E. line of Outlot 6 a distance of 180 feet; thence W'ly along the North line of said Outlot 170 feet to an iron stake; thence S'ly parallel to the E. line of said Outlot 6, 150 feet; thence E'ly parallel to the N. line 33 feet; thence S'ly parallel to the E. line of Outlot 6, 30 feet; thence E'ly to the point of beginning.

ALSO, a strip of land 100 feet wide off the West side of Outlot 4, more specifically described as follows: Beginning at the SW corner of said Outlot, running thence NW'ly along the W. line of said Outlot to the N. line of said Outlot 4, thence E. along the N. line of said Outlot 100 feet; thence SE'ly along a line parallel with the W. line of said Outlot to the S. line of said Outlot; thence SW'ly along the S. line of said Outlot 4 to the place of beginning.

ALSO, Outlot 5 of S.C.Hall's Outlots in S. C. Hall's Addition to the City of Whitewater, Walworth County, Wisconsin.

VOL 669 PAGE 504 WALWORTH COUNTY REGISTER OF DEEDS


ACREAGE

171,314 Sq. Ft. (2.326 Ac.)

To all parties interested in title to the premises surveyed

State of Wisconsin)
County of Walworth)SS

I, ALAN L BERG a registered surveyor of the State of Wisconsin, do hereby certify that on February 19, 1974, I surveyed the above described property according to the official records and that the accompanying map is a correctly dimensioned representation to the scale of the boundaries; that all buildings and improvements lie wholly within the boundary lines; and that no encroachments by adjacent property owners appear from said survey.

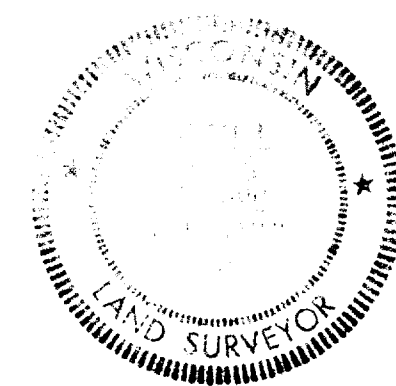

Alan L. Berg
Alan L Berg S-1090

NORTH
SCALE 1"=40'

⊙ = IRON PIPE FOUND
○ = IRON PIPE SET

REVISIONS					
NO.	DATE	BY			
1					
2					
3			DRAWN BY	SCALE	MATERIAL
4			CHK'D	DATE	DRAWING NO.
5			TRACED	APP'D	

HAS-69

10-227