

WATERMAN, FUGE & ASSOCIATES, INC.

ARCHITECTS - ENGINEERS - SURVEYORS

FORT ATKINSON, WISCONSIN


Client— A. H. Mackie

Address— 251 George Street, Whitewater, Wis.

Whitewater, City of

Sec. 4 T 4N R 15E

Description— That part of the Southeast 1/4 of the Northwest 1/4 of Section 4, Town 4 North, Range 15 East, City of Whitewater, Walworth County, Wisconsin, as described in Deed Volume 570, Page 441 of said County, and more particularly described as follows: Commencing at a chisel mark in the concrete pavement indicating the West 1/4 corner of said Section 4; thence, N. 88° 38' E., along the South line of the Northwest 1/4 of said Section 4, 1527.74 feet to the centerline of George Street; thence N 0°-00' E., along the centerline of George Street, and parallel to the West line of Jefferson Street, 878.00 feet to a point lying on an extension of the South line of this parcel; thence N. 88°-38' E., parallel to the South line of said Northwest 1/4, 30.00 feet to a 1 1/4" iron pipe on the East line of George Street, and the point of beginning of this description; thence continue N. 88°-38' E., 198.55 feet to a 1 1/4" iron pipe on a line lying 626 feet West of the West line of Jefferson Street and parallel thereto; thence, N. 0°-00' E., along said line lying 626 feet West of the West line of Jefferson Street and parallel thereto, 100.00 feet to a 1 1/4" iron pipe; thence S. 88°-38' W., parallel to the South line of said Northwest 1/4 Section, 198.55 feet to a 1 1/4" iron pipe in the East line of George Street; thence S. 0°-00' W., along the East line of George Street, 100.00 feet to the point of beginning.

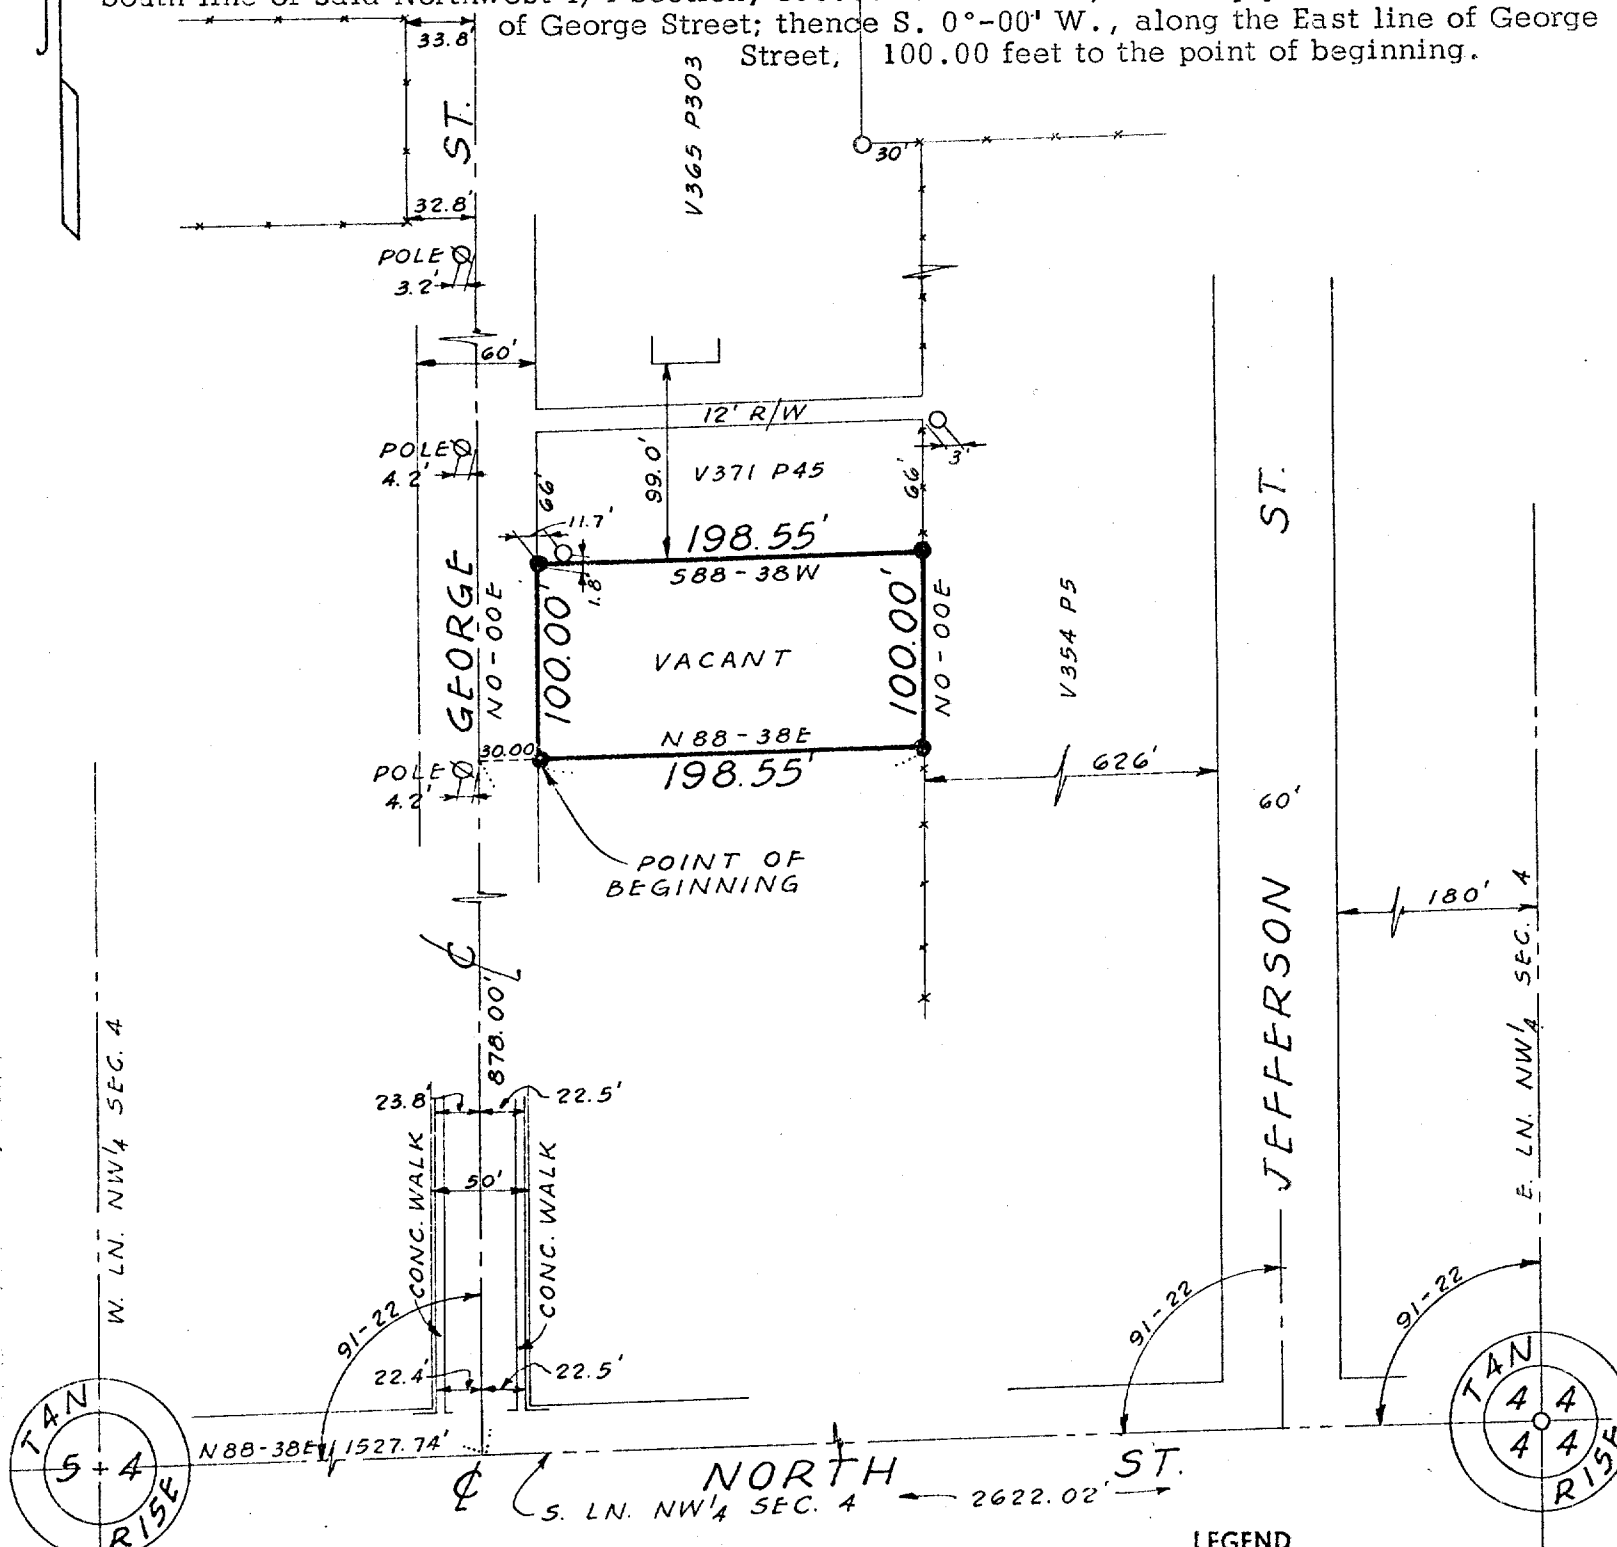

Scale of Map: 1 inch = 100 feet.

STATE OF WISCONSIN }
COUNTY OF JEFFERSON } SS.

I, Paul E. Meves a registered surveyor of the State of Wisconsin, do hereby certify that on March 15, 1961 I surveyed the above described property according to official records and that the accompanying map is a correctly dimensioned representation to the scale of the boundaries; that all buildings and improvements lie wholly within the boundary lines, and that no encroachments by adjacent property owners appear from said survey.

- LEGEND**
- Iron Pipes Found
 - Iron Pipes Set
 - X—X—X—X— Fences
 - Reference Points
 - ⊕ T-Bar Stake Set

Paul E. Meves
SIGNATURE

Map No. 1040

62-10