


PLAT OF SURVEY OF

Existing survey monuments found which mark the corners of a parcel surveyed by Harold H. Kolb, S-187 in November of 1964. Said parcel is described on Kolb survey map as: Lot 10, and part of Lots 9 and 11, Block 17, Chapman and Ludington's Addition to the Village (now City) of Whitewater, Walworth County, Wisconsin. Reference County Surveyor Record No. 10-192 by Kolb in 1964 and also survey by Lloyd Jensen in 1950 and 1952 which adjoin on the north and the south respectively on the survey by Kolb.

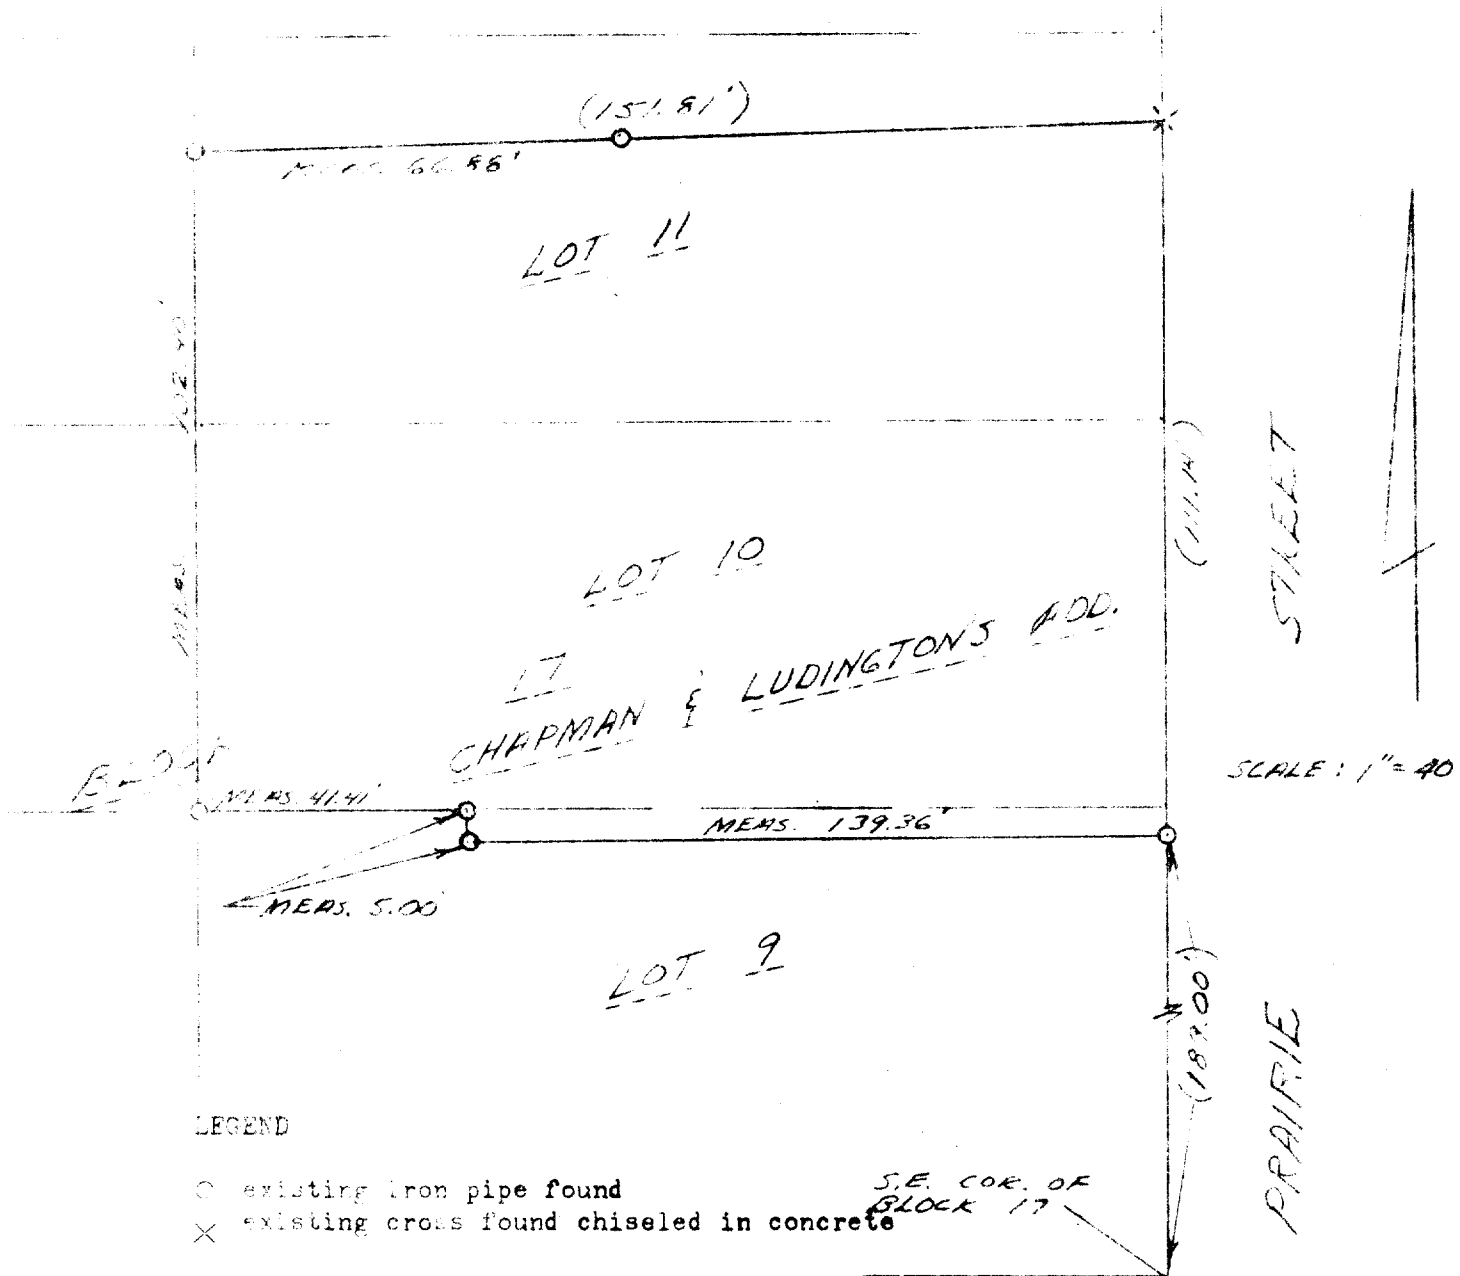

I hereby certify that I have searched for and found the monuments as same are shown on this plat. The distances indicated as measured were measured; distances in parenthesis are not measured.

June 3, 1974
Date

Glen L. Northrop
Glen L. Northrop

Survey Ltd.
Madison, Wis.

Ord. No. AB
Sheet 1 of 1

