


#130-66
#116-69

B.M. HYDRANT (SOUTH DOLT TOP)
Q ELEV. 100.00

WHITEWATER STR.
(BRICK PAVEMENT) (POOR)

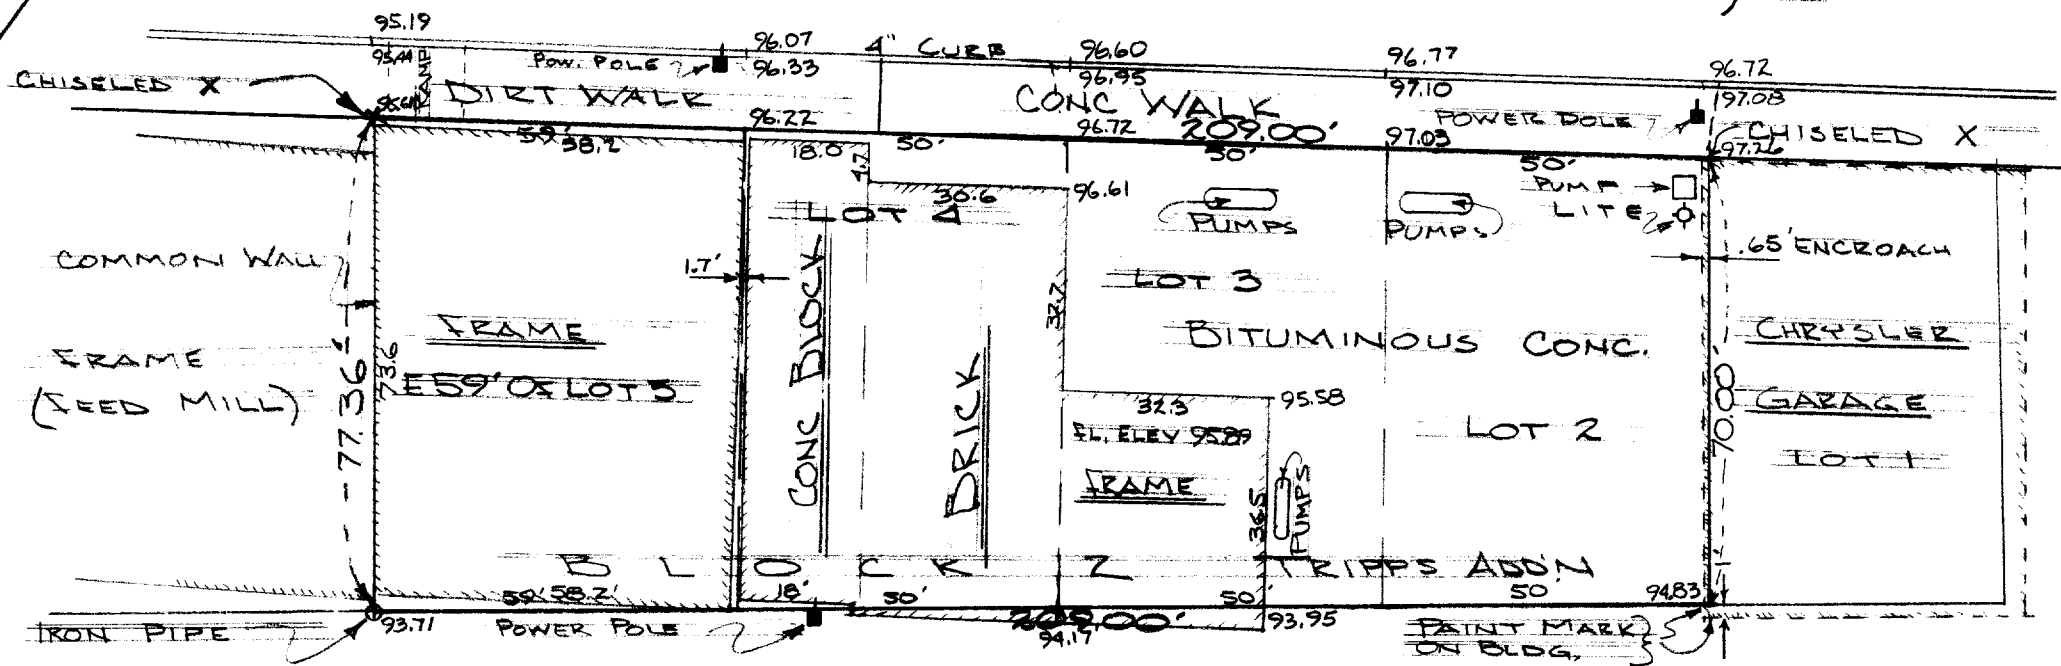

RAILROAD - RIGHT OF WAY
CHIC.-MIL.-ST. PAUL & PACIFIC R.R.

JAMES STREET

DESCRIPTION: Lots 2, 3, 4, and the East 59.00 feet to Lot 5 of Block #1 in Tripp's Addition to the City of Whitewater, Walworth County, Wisconsin.

CERTIFICATE: I, James F. Biagi, surveyor, do hereby certify that I have surveyed the property hereon described, and that the location of the improvements are as shown.

August, 19, 1969

James F. Biagi
James F. Biagi RLS 272

