


BENCH MARK IS 50' 2
BOLT ON TOP OF HYDRANT
AT NE COR WHITEWATER & 2ND
STREETS ELEV 100.00

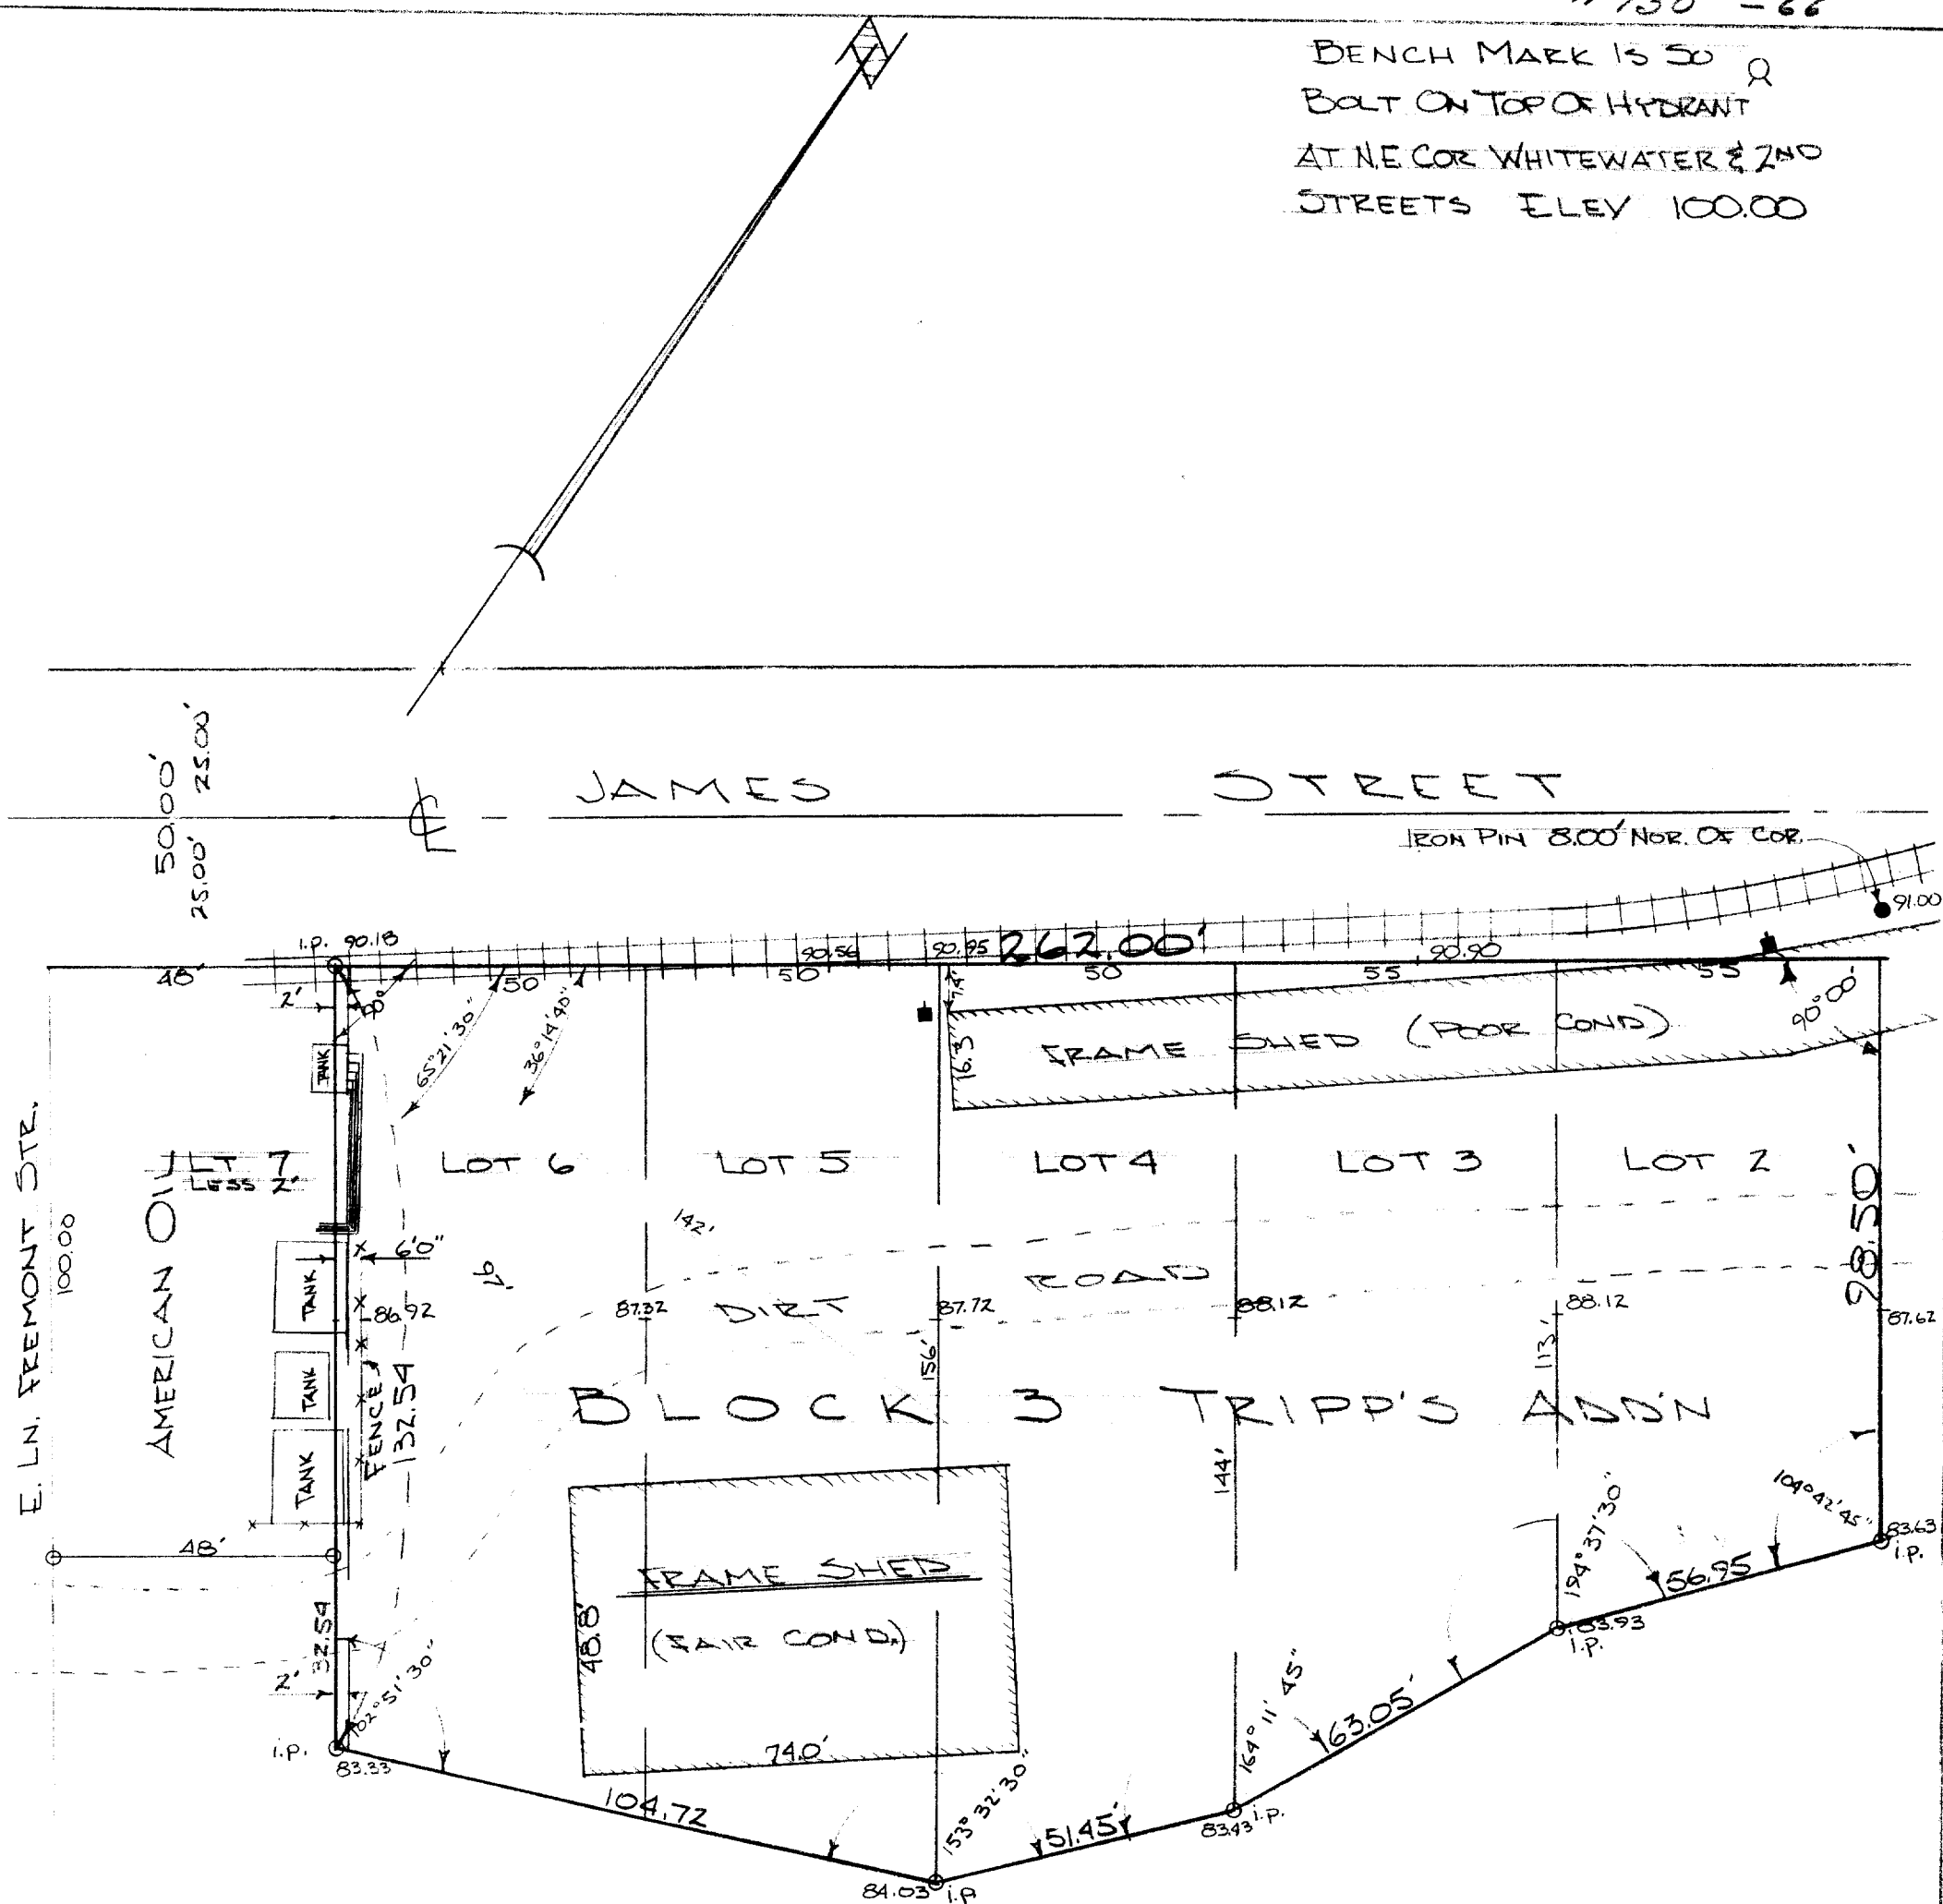

CERTIFICATE: I, James F. Biagi, surveyor, do hereby certify that I have surveyed the property hereon described.

James F. Biagi
James F. Biagi RLS 272

