

HAROLD H. KOLB


REGISTERED PROFESSIONAL LAND SURVEYOR
LAKE GENEVA, WISCONSIN

PLAT OF SURVEY OF

Lot 49, Buckingham Estates, section 6,
T4N, R15E, City of Whitewater, Walworth
County, Wisconsin.

ACCURACY: Distances $\pm 0.01'$
Angles $\pm 05''$
Error of closure less
than 1 part in 3000

Ordered by: Ken Schaffeld

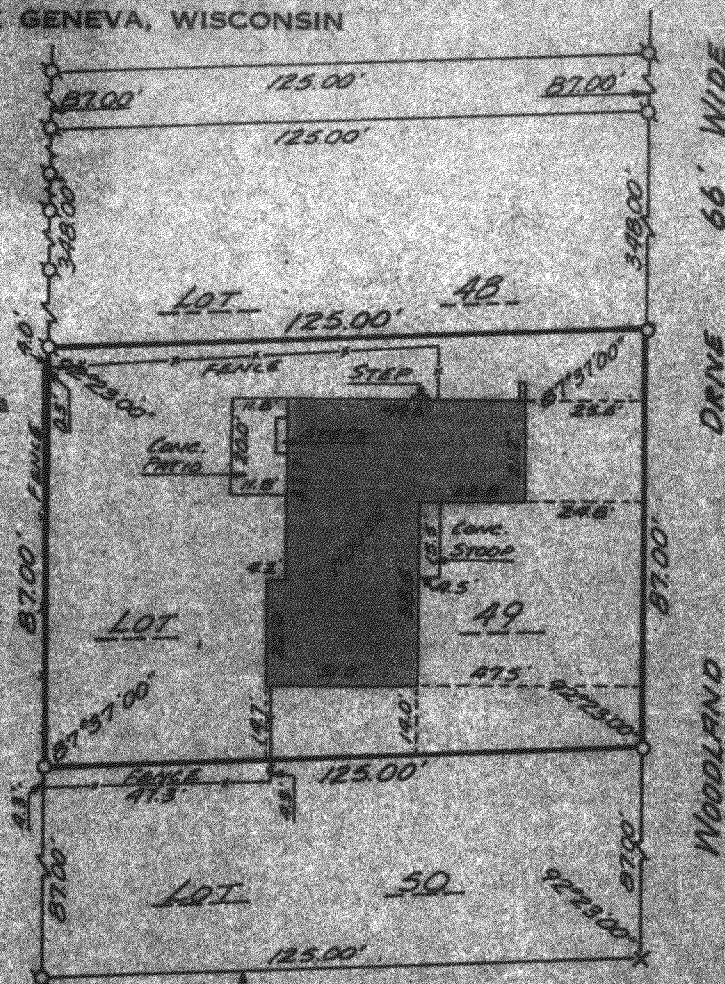

SCALE 1" = 40'

LEGEND

- ⊕ — IRON PIPE FOUND
- — IRON PIPE PLACED
- — CONCRETE MONUMENT
- x — SPIKE



I, EUGENE BLUMQUIST, DO HEREBY CERTIFY THAT I HAVE
SURVEYED THE PROPERTY HEREON DESCRIBED ACCORDING
TO THE OFFICIAL RECORDS, AND THAT THE PLAT HEREON
IS A CORRECT REPRESENTATION OF THE LOT LINES.

EUGENE A. BLUMQUIST
WISCONSIN REGISTERED LAND SURVEYOR, S-1279
DATE Aug 5, 1976

BU-47

10-276