


N

SCALE-1"=20'
 ●=CONC. MONU
 ○=IRON PIPE

LINDSEY

50'

COURT

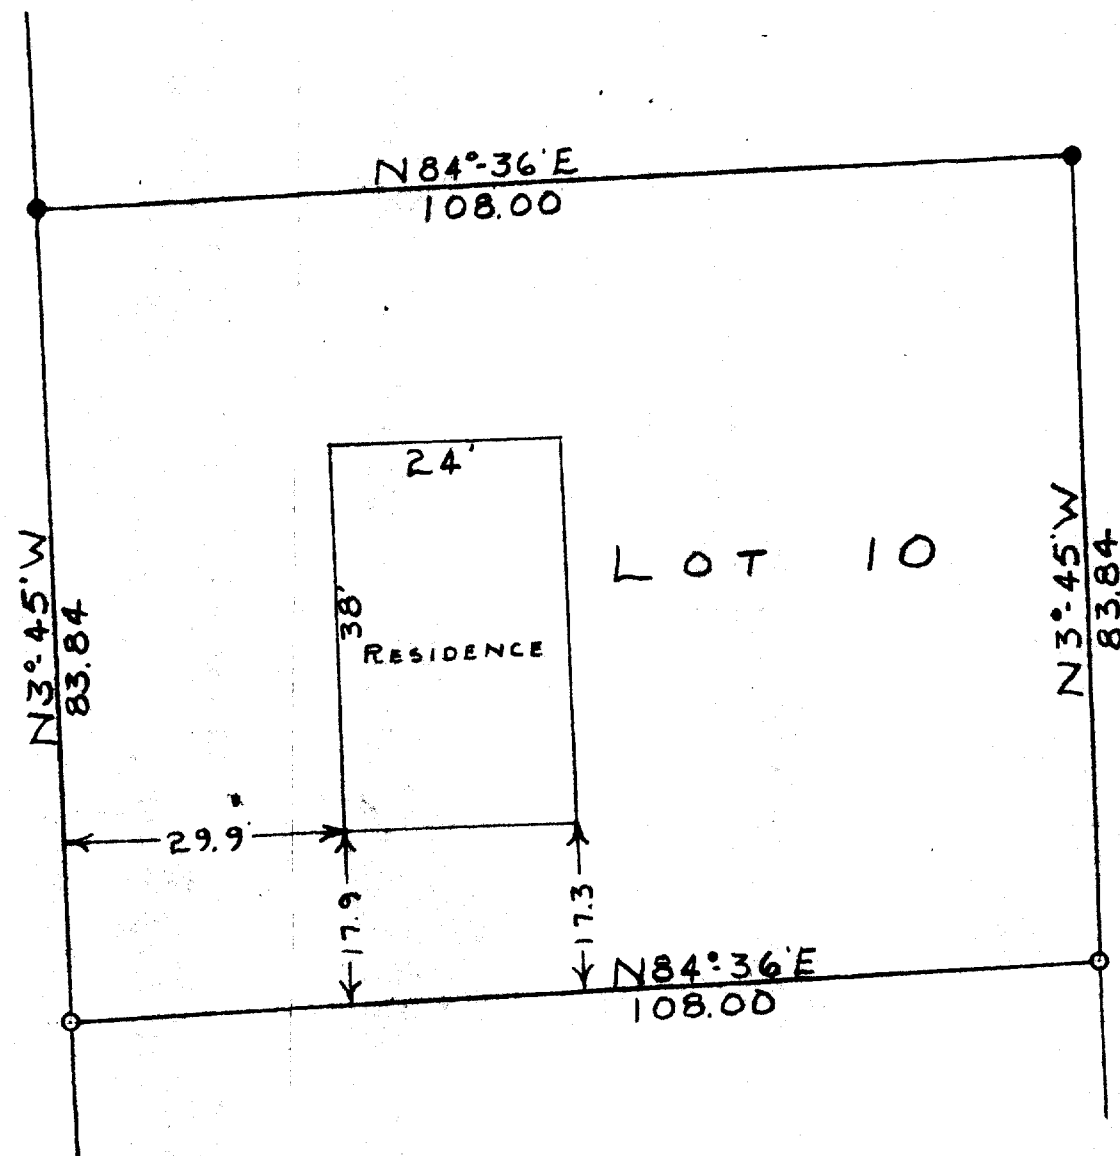

STATE OF WISCONSIN)
 COUNTY OF WALWORTH)

I, GEORGE T. DUNHAM, DO HEREBY CERTIFY THAT I HAVE SURVEYED THE
 PROPERTY DESCRIBED AS FOLLOWS:

LOT 10 OF BELL-AIRE HEIGHTS LOCATED IN THE CITY OF WHITEWATER
 WALWORTH COUNTY, WISCONSIN

AND THAT THE PLAT SHOWN ABOVE IS A CORRECT REPRESENTATION OF THE PROPERTY
 LINES AND OF THE IMPROVEMENTS LOCATED THEREON.
 FEB. 6, 1957

George T. Dunham
 GEORGE T. DUNHAM, SURVEYOR
 DELAVAN, WISCONSIN

10-28