


EUGENE A. BLONQUIST

REGISTERED PROFESSIONAL LAND SURVEYOR
LAKE GENEVA, WISCONSIN

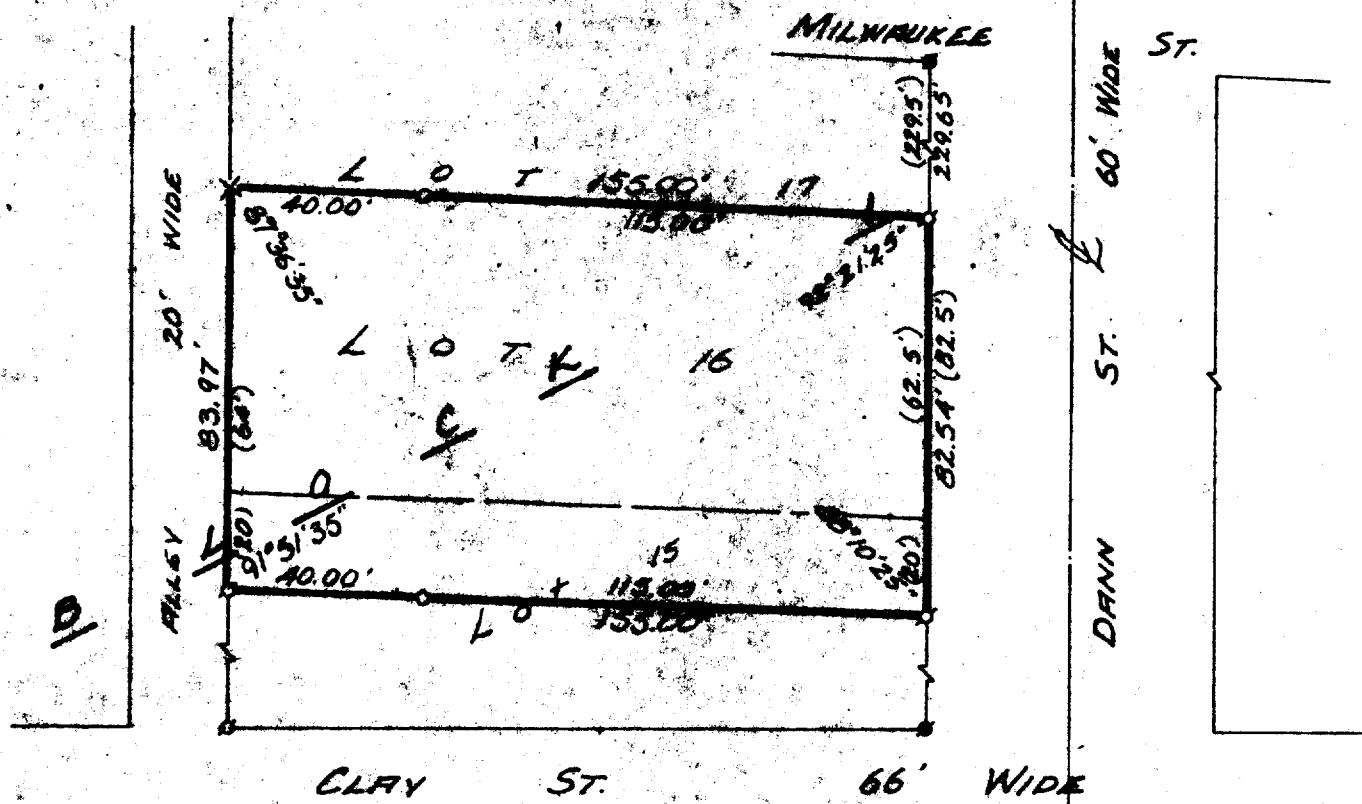

PLAT OF SURVEY OF

Lot 16 and part of Lot 15, Block 1, ~~Chapman~~
~~and Ludington's Addition~~, City of Whitewater,
Walworth County, Wisconsin. **TRIPP & POSEY'S**

Owner: Denis Sanders
239 E. Milwaukee St.
Whitewater, WI

Accuracy: Distances $\pm .01'$
Angles $\pm .05''$
Error of Closure less than
one part in 3000

N



SCALE: 1" = 40'

LEGEND

- ◆ - IRON PIPE FOUND
- - IRON PIPE PLACED
- - CONCRETE MONUMENT
- x - SPIKE
- () - PLATTED AS



I, Eugene Blonquist, DO HEREBY CERTIFY THAT I HAVE
SURVEYED THE PROPERTY HEREON DESCRIBED ACCORDING
TO THE OFFICIAL RECORDS, AND THAT THE PLAT HEREON
IS A CORRECT REPRESENTATION OF THE LOT LINES.

Eugene A. Blonquist
EUGENE A. BLONQUIST
WISCONSIN REGISTERED LAND SURVEYOR, S-1279
DATE *May 9, 1977*

10-288