



HAROLD H. KOLB
REGISTERED PROFESSIONAL LAND SURVEYOR
LAKE GENEVA, WISCONSIN

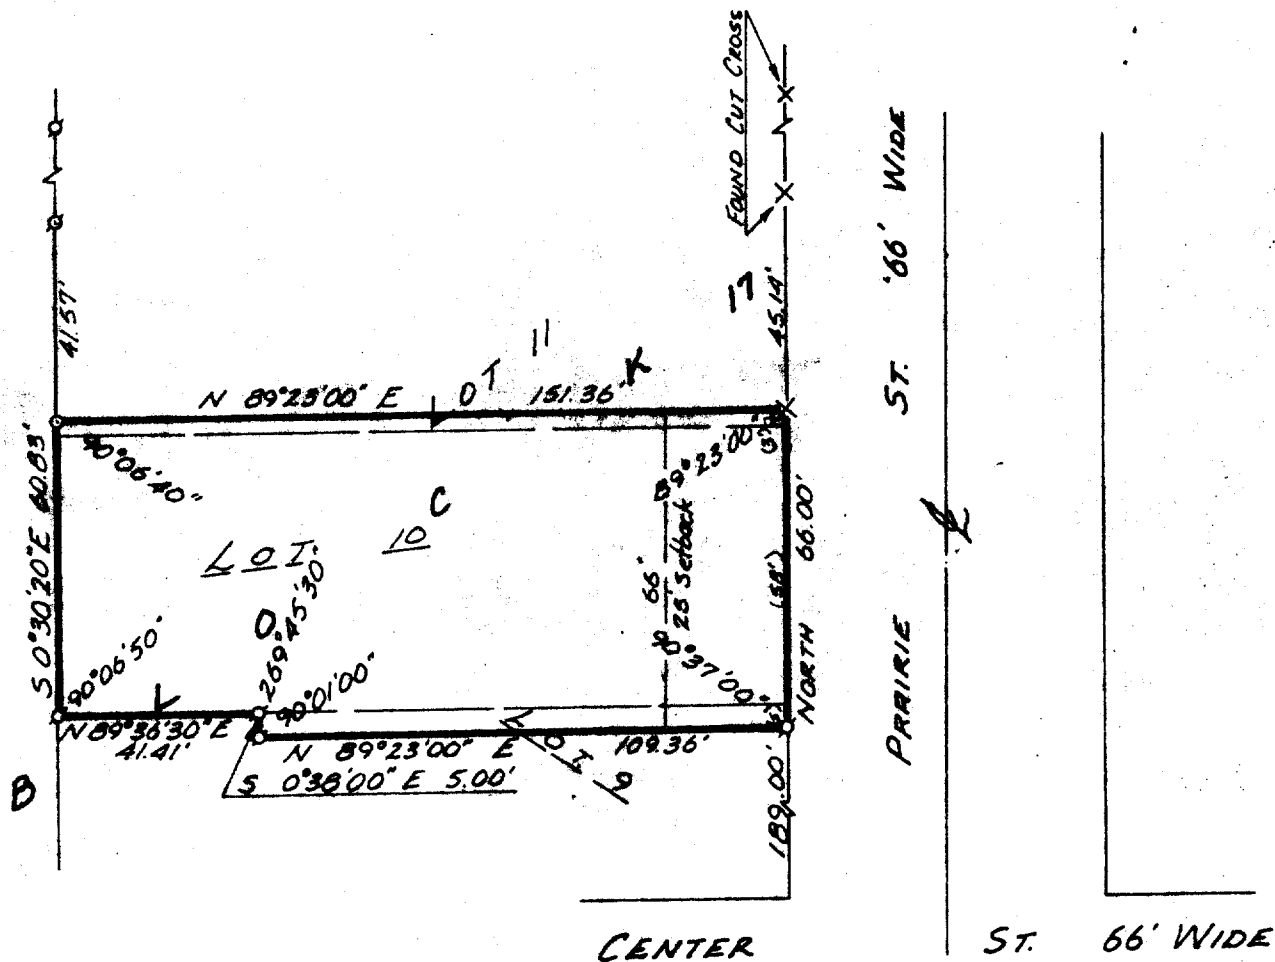

PLAT OF SURVEY OF
 Lot 10 and part of Lots 2 and 11, Block 17, *Chapman + Ludington*
Tripp and Passey's Subdivision of Block 10,
 City of Whitewater, Walworth County, Wisconsin

Owner: Denis Sanders
 239 E. Milwaukee St.
 Whitewater, WI


Accuracy: Distances $\pm .01'$
 Angles $\pm .05''$
 Error of closure less than
 one part in 3000

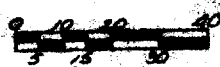

SCALE IN FEET

LEGEND

- O — IRON PIPE PLACED. 1" x 24" 1.13 LB./LIN. FT.
- — CONCRETE MONUMENT. 5" DIA. x 30"
- X — CROSS CUT IN CONCRETE
- D — IRON PIPE FOUND

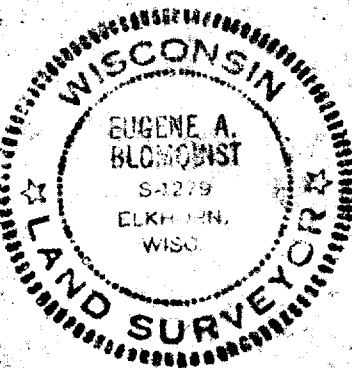

I, Eugene A. Blomquist, do hereby certify
 that I have surveyed the property hereon
 described according to the official records,
 and that the plat hereon is a correct
 representation of the lot lines.

Eugene A. Blomquist
 EUGENE A. BLOMQUIST
 WISCONSIN REGISTERED LAND SURVEYOR, S-1279
 DATE *May 9, 1977*

10-289