


N

SCALE ~ 1" = 20'
 O = IRON PIPE
 ● = CONC. MONU.

TRATT

STREET

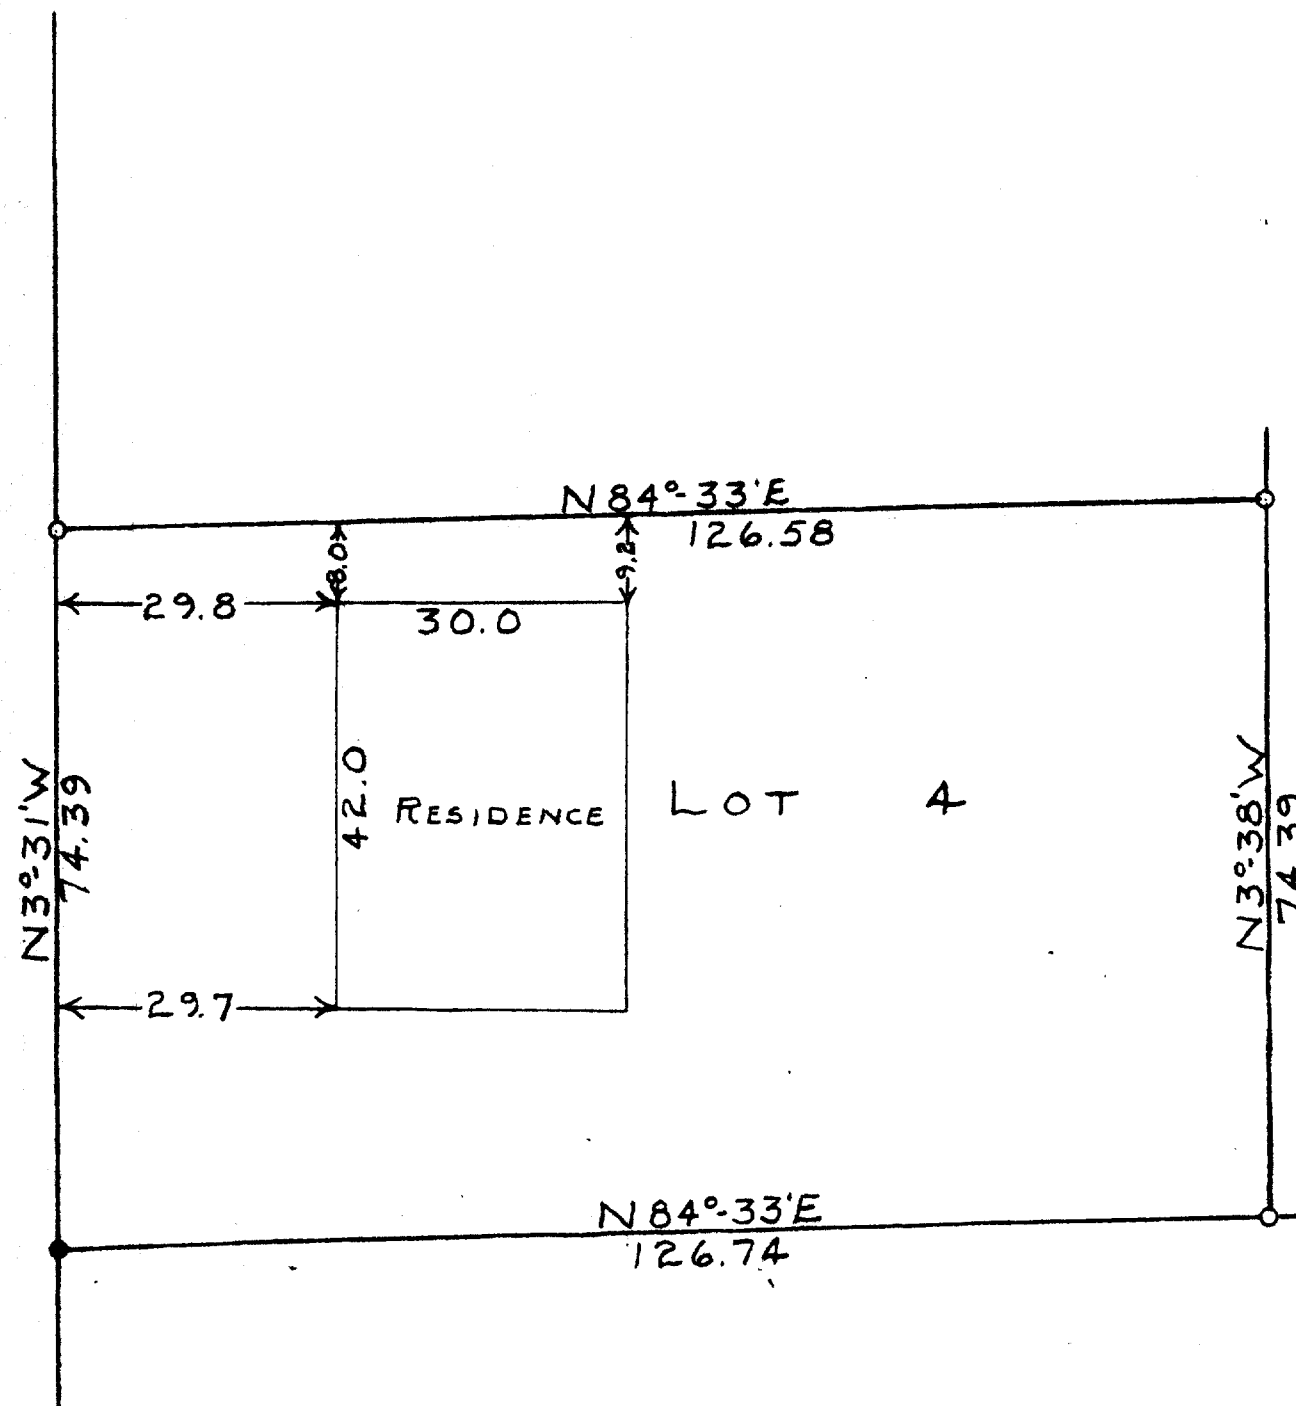

STATE OF WISCONSIN)^{SS}
 COUNTY OF WALWORTH)

I, GEORGE T. DUNHAM, DO HEREBY CERTIFY THAT I HAVE SURVEYED
 THE PROPERTY DESCRIBED AS FOLLOWS:

LOT 4 OF BELL-AIRE HEIGHTS, LOCATED IN THE CITY OF
 WHITEWATER, WALWORTH COUNTY, WISCONSIN.

AND THAT THE PLAT SHOWN ABOVE IS A CORRECT REPRESENTATION OF THE
 PROPERTY LINES AND OF THE IMPROVEMENTS, LOCATED THEREON.
 OCT. 5, 1956

George T. Dunham
 GEORGE T. DUNHAM, SURVEYOR
 DELAVAN, WISCONSIN

10-29

BH-4