

HAROLD H. KOLB
 REGISTERED PROFESSIONAL LAND SURVEYOR
 LAKE GENEVA, WISCONSIN

SOUTH STREET 60' WIDE

PLAT OF

Building location on Lot 5, Block 2, F.W.
 Tratts Addition to the City of Whitewater,
 Walworth County, Wisconsin.

ORDERED BY: Waukesha Savings & Loan
 P.O. Box 235
 Waukesha, Wisconsin

Lot 4

(2340')

Lot 5

(2340')

Lot 6

(82.5')


N



SCALE: 1" = 30'

LEGEND

- ◊ - IRON PIPE FOUND
- - IRON PIPE PLACED
- - IRON ROD FOUND
- x - SPIKE
- () - PLATTED AS

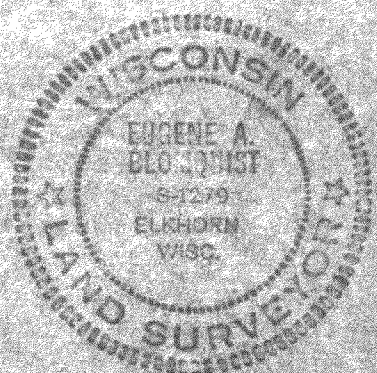

Eugene Blomquist DO HEREBY CERTIFY THAT I HAVE
 SURVEYED THE PROPERTY HEREON DESCRIBED ACCORDING
 TO THE OFFICIAL RECORDS, AND THAT THE PLAT HEREON
 IS A CORRECT REPRESENTATION OF THE LOT LINES.

Eugene A. Blomquist

EUGENE A. BLOMQUIST
 WISCONSIN REGISTERED LAND SURVEYOR, S-1279
 DATE FEB 24, 1972

7-19

10-290

WH-9