

HAROLD H. KOLB

REGISTERED PROFESSIONAL LAND SURVEYOR

LAKE GENEVA, WISCONSIN

EAST 1/4 CORNER
SEC. 4-4-15

SOUTH
1583.84'


PLAT OF SURVEY OF

A parcel of land located in the Southeast 1/4 of Section 4 and the Northeast 1/4 of Section 9, T 4 N, R 15 E, City of Whitewater, Walworth County, Wisconsin, described as follows:
Commencing at the East 1/4 Corner of said Section 4;
thence South 1583.84 feet; thence N 89°55'50" W 800.41 feet; thence S 2°04'10" W 165.00 feet; thence S 89°55'50" E 40.00 feet to the place of beginning;
thence N 89°55'50" W 40.00 feet; thence N 2°04'10" E 165.00 feet; thence S 89°55'50" E 264.00 feet; thence S 0°32'35" W 534.98 feet; thence S 89°55'50" E 61.0 feet to the shoreline of Tripp Lake; thence South-
erly 1805.0 feet along said shoreline to a point that is South 697.16 feet from the place of beginning;
thence North 697.16 feet to the place of beginning.
Containing 7.81 acres.

NOTE: Bearings are assumed from previous survey records.

ORDERED BY: Pat McCormick
210 S. Green St.
Whitewater, WI.

ACCURACY: Distances $\pm 0.01'$
Angles $\pm 05''$
Error of closure less
than one part in 3000

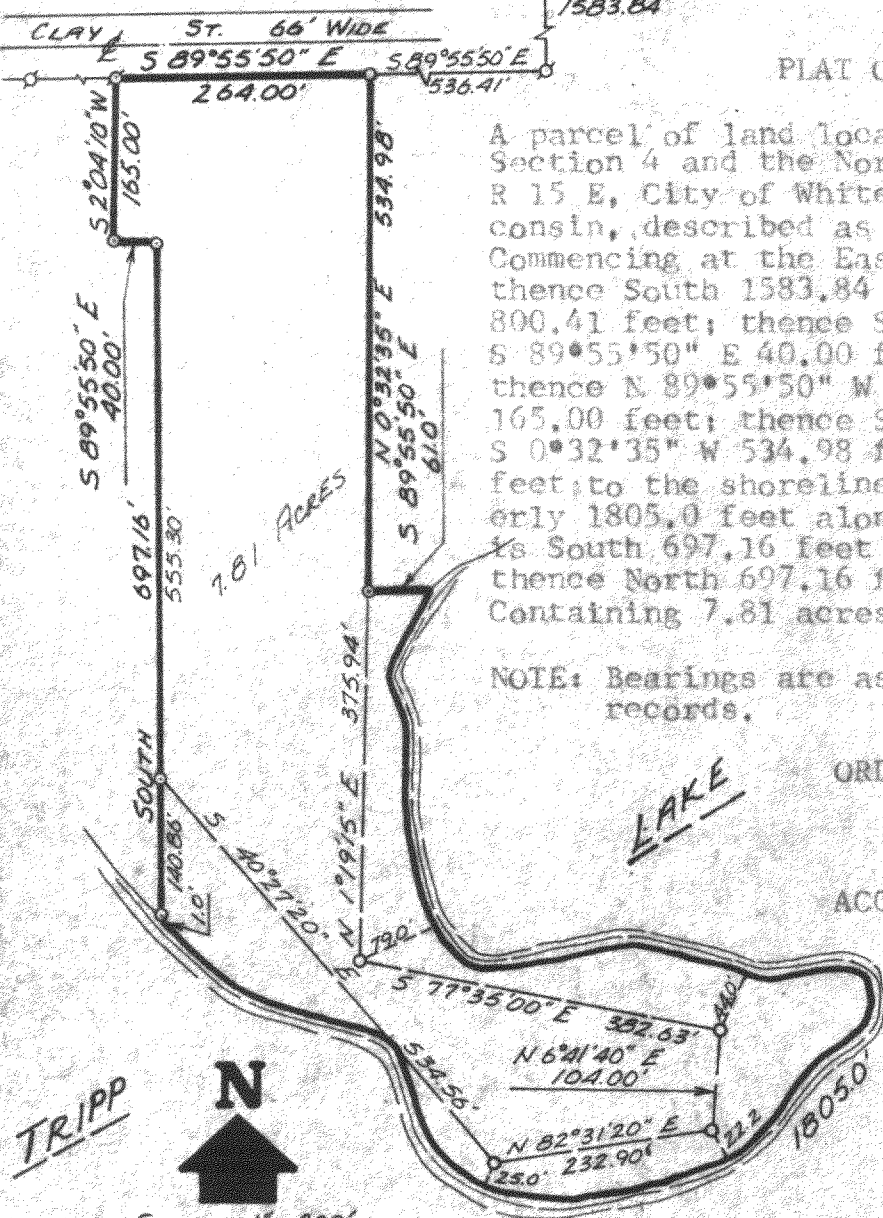

TRIPP
N
SCALE: 1" = 200'

LEGEND

- φ — IRON PIPE FOUND
- — IRON PIPE PLACED
- — CONCRETE MONUMENT
- x — SPIKE

I, EUGENE BLONQUIST DO HEREBY CERTIFY THAT I HAVE
SURVEYED THE PROPERTY HEREON DESCRIBED ACCORDING
TO THE OFFICIAL RECORDS, AND THAT THE PLAT HEREON
IS A CORRECT REPRESENTATION OF THE LOT LINES.

Eugene A. Blomquist
EUGENE A. BLONQUIST
WISCONSIN REGISTERED LAND SURVEYOR, S-1279
DATE May 26, 1976

