


HAROLD H. KOLB

REGISTERED PROFESSIONAL LAND SURVEYOR
LAKE GENEVA, WISCONSIN

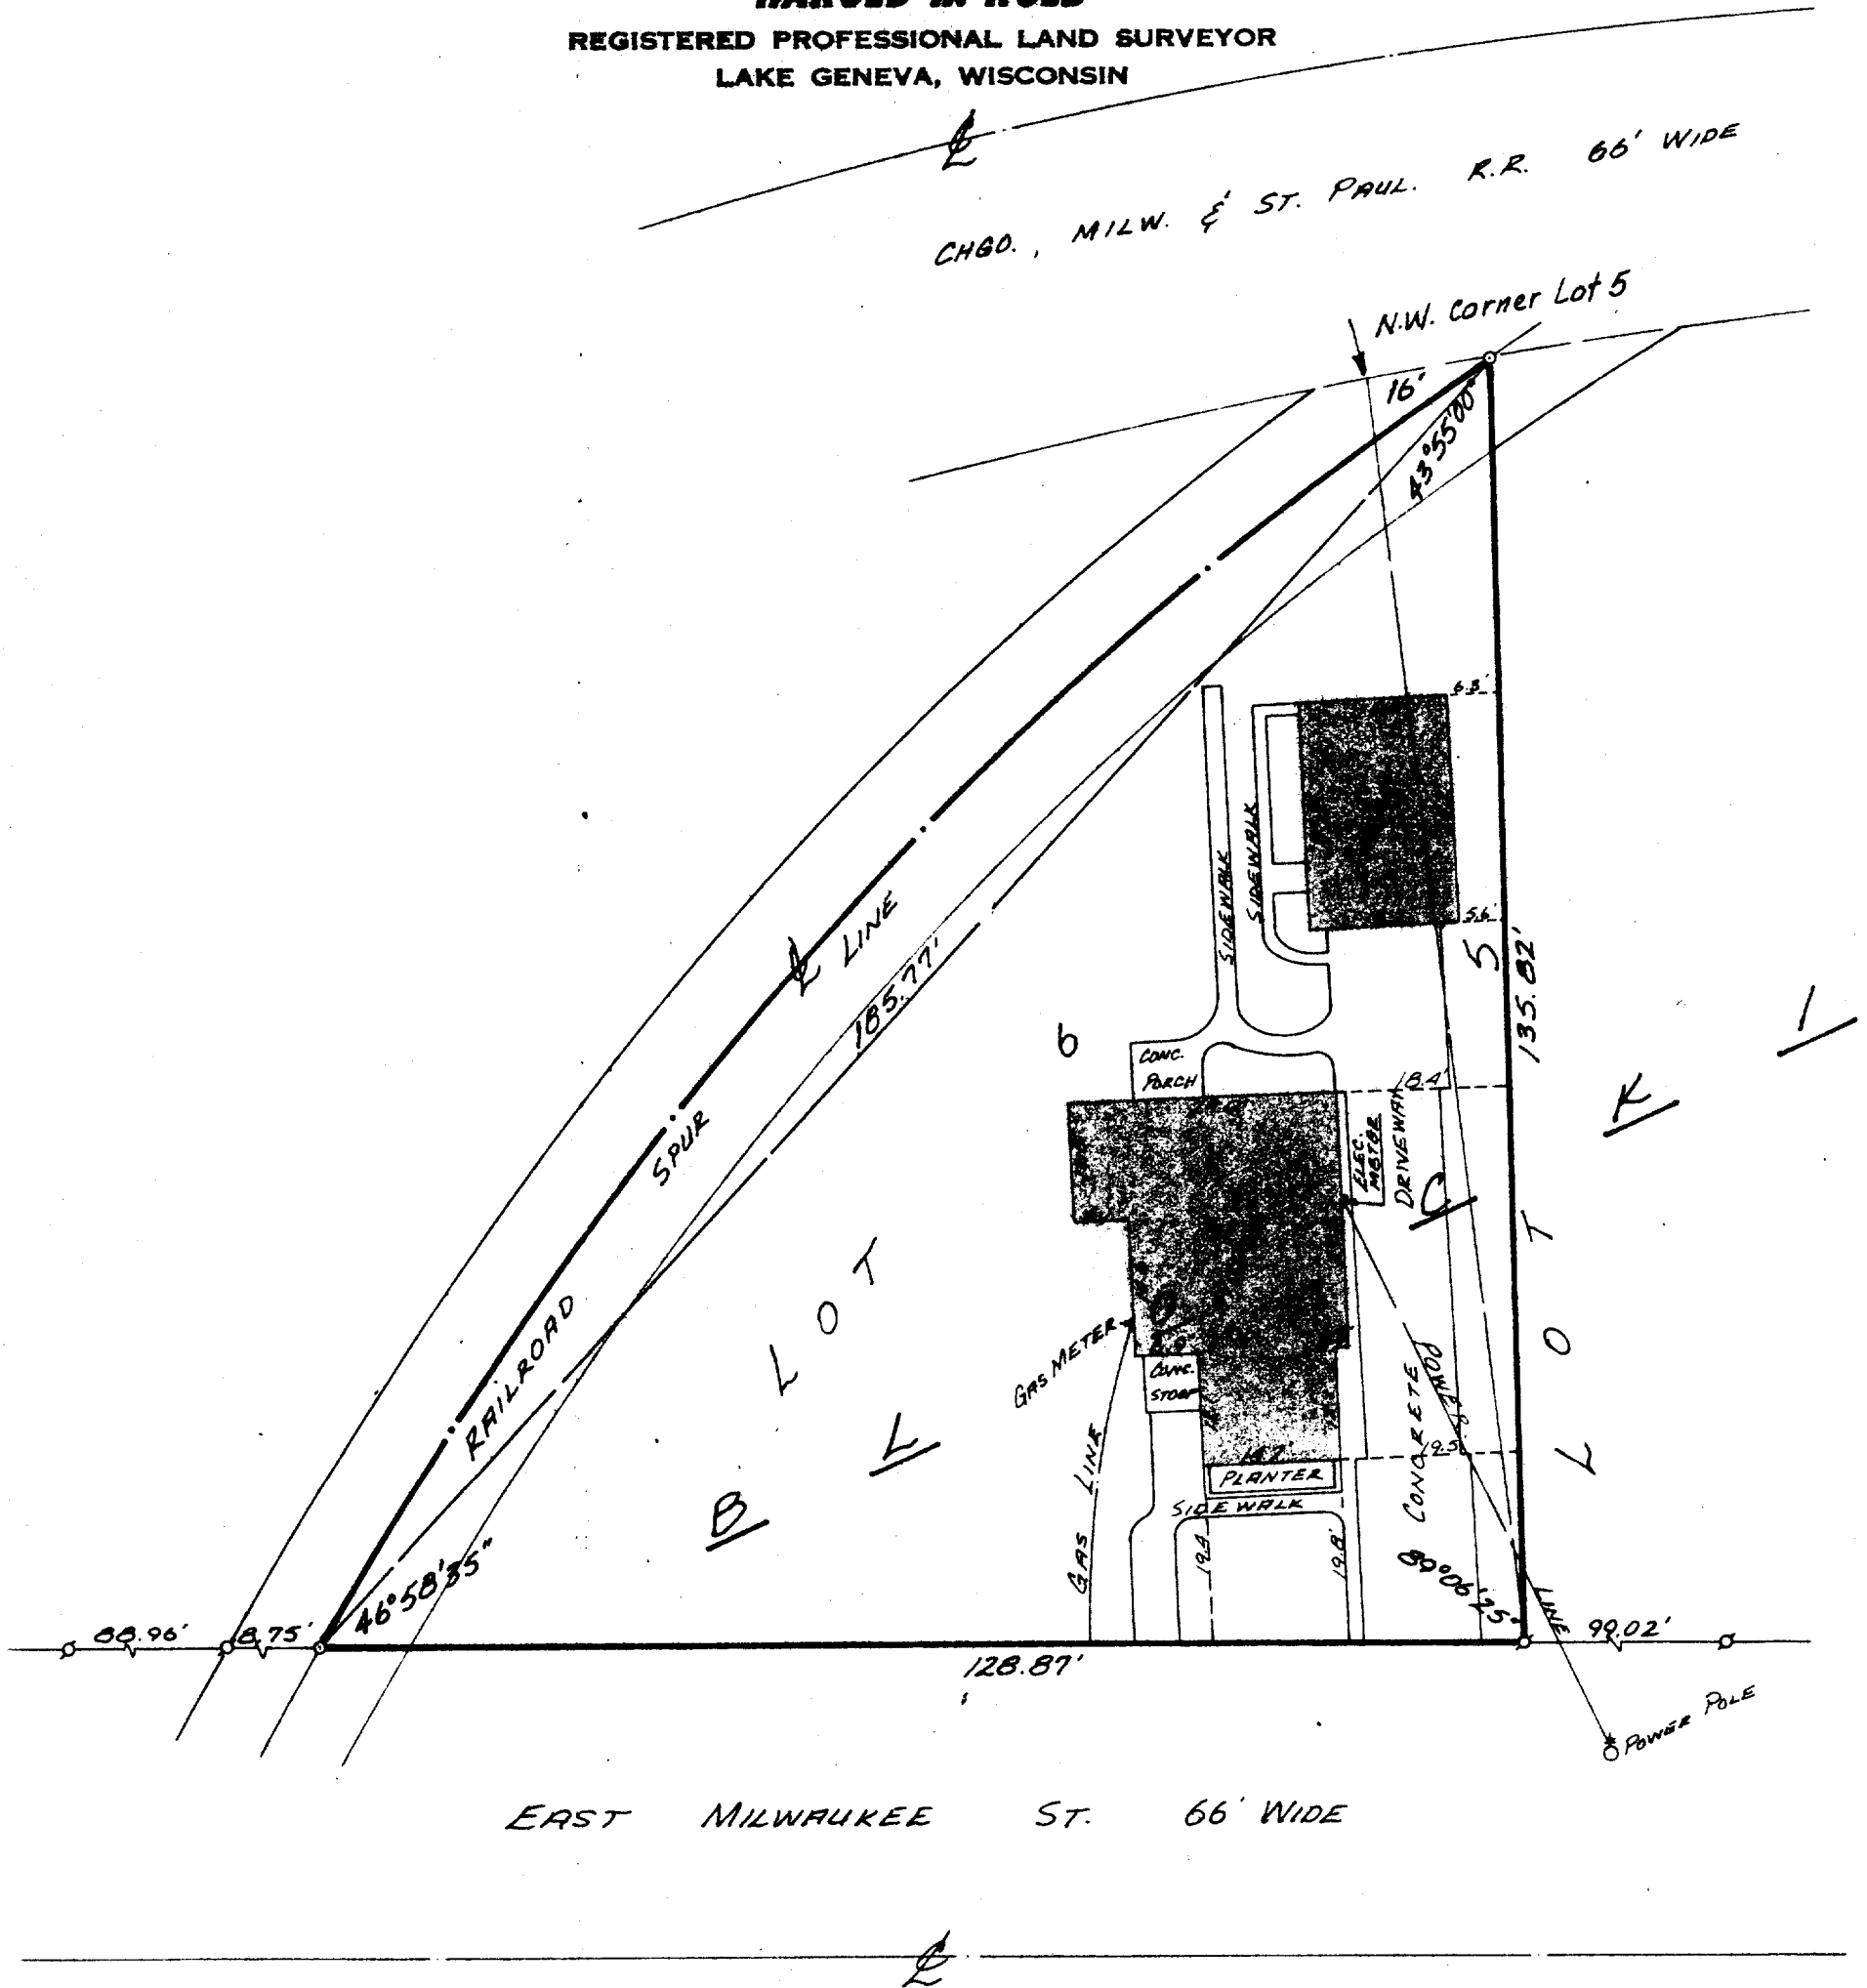

PLAT OF SURVEY OF

Part of lot 6 and part of lot 5, block 1, Chicago's Addition, City of Whitewater, Walworth County, Wisconsin, as shown in Volume 113, Page 466 of records.

ORDERED BY: Wauwatosa Realty Company
524 Whitewater Av.
Fort Atkinson, WI.

ACCURACY: Distances $\pm 0.01'$
Angles $\pm 05''$
Error of closure less than one part in 3000.

N



SCALE: 1"=20'

LEGEND

- φ - IRON PIPE FOUND
- - IRON PIPE PLACED
- - CONCRETE MONUMENT
- x - SPIKE



I, EUGENE A. BLOMQUIST, DO HEREBY CERTIFY THAT I HAVE SURVEYED THE PROPERTY HEREON DESCRIBED ACCORDING TO THE OFFICIAL RECORDS, AND THAT THE PLAT HEREON IS A CORRECT REPRESENTATION OF THE LOT LINES.

EUGENE A. BLOMQUIST
WISCONSIN REGISTERED LAND SURVEYOR, S - 1279
DATE May 27, 1977

ES-6

10-296