


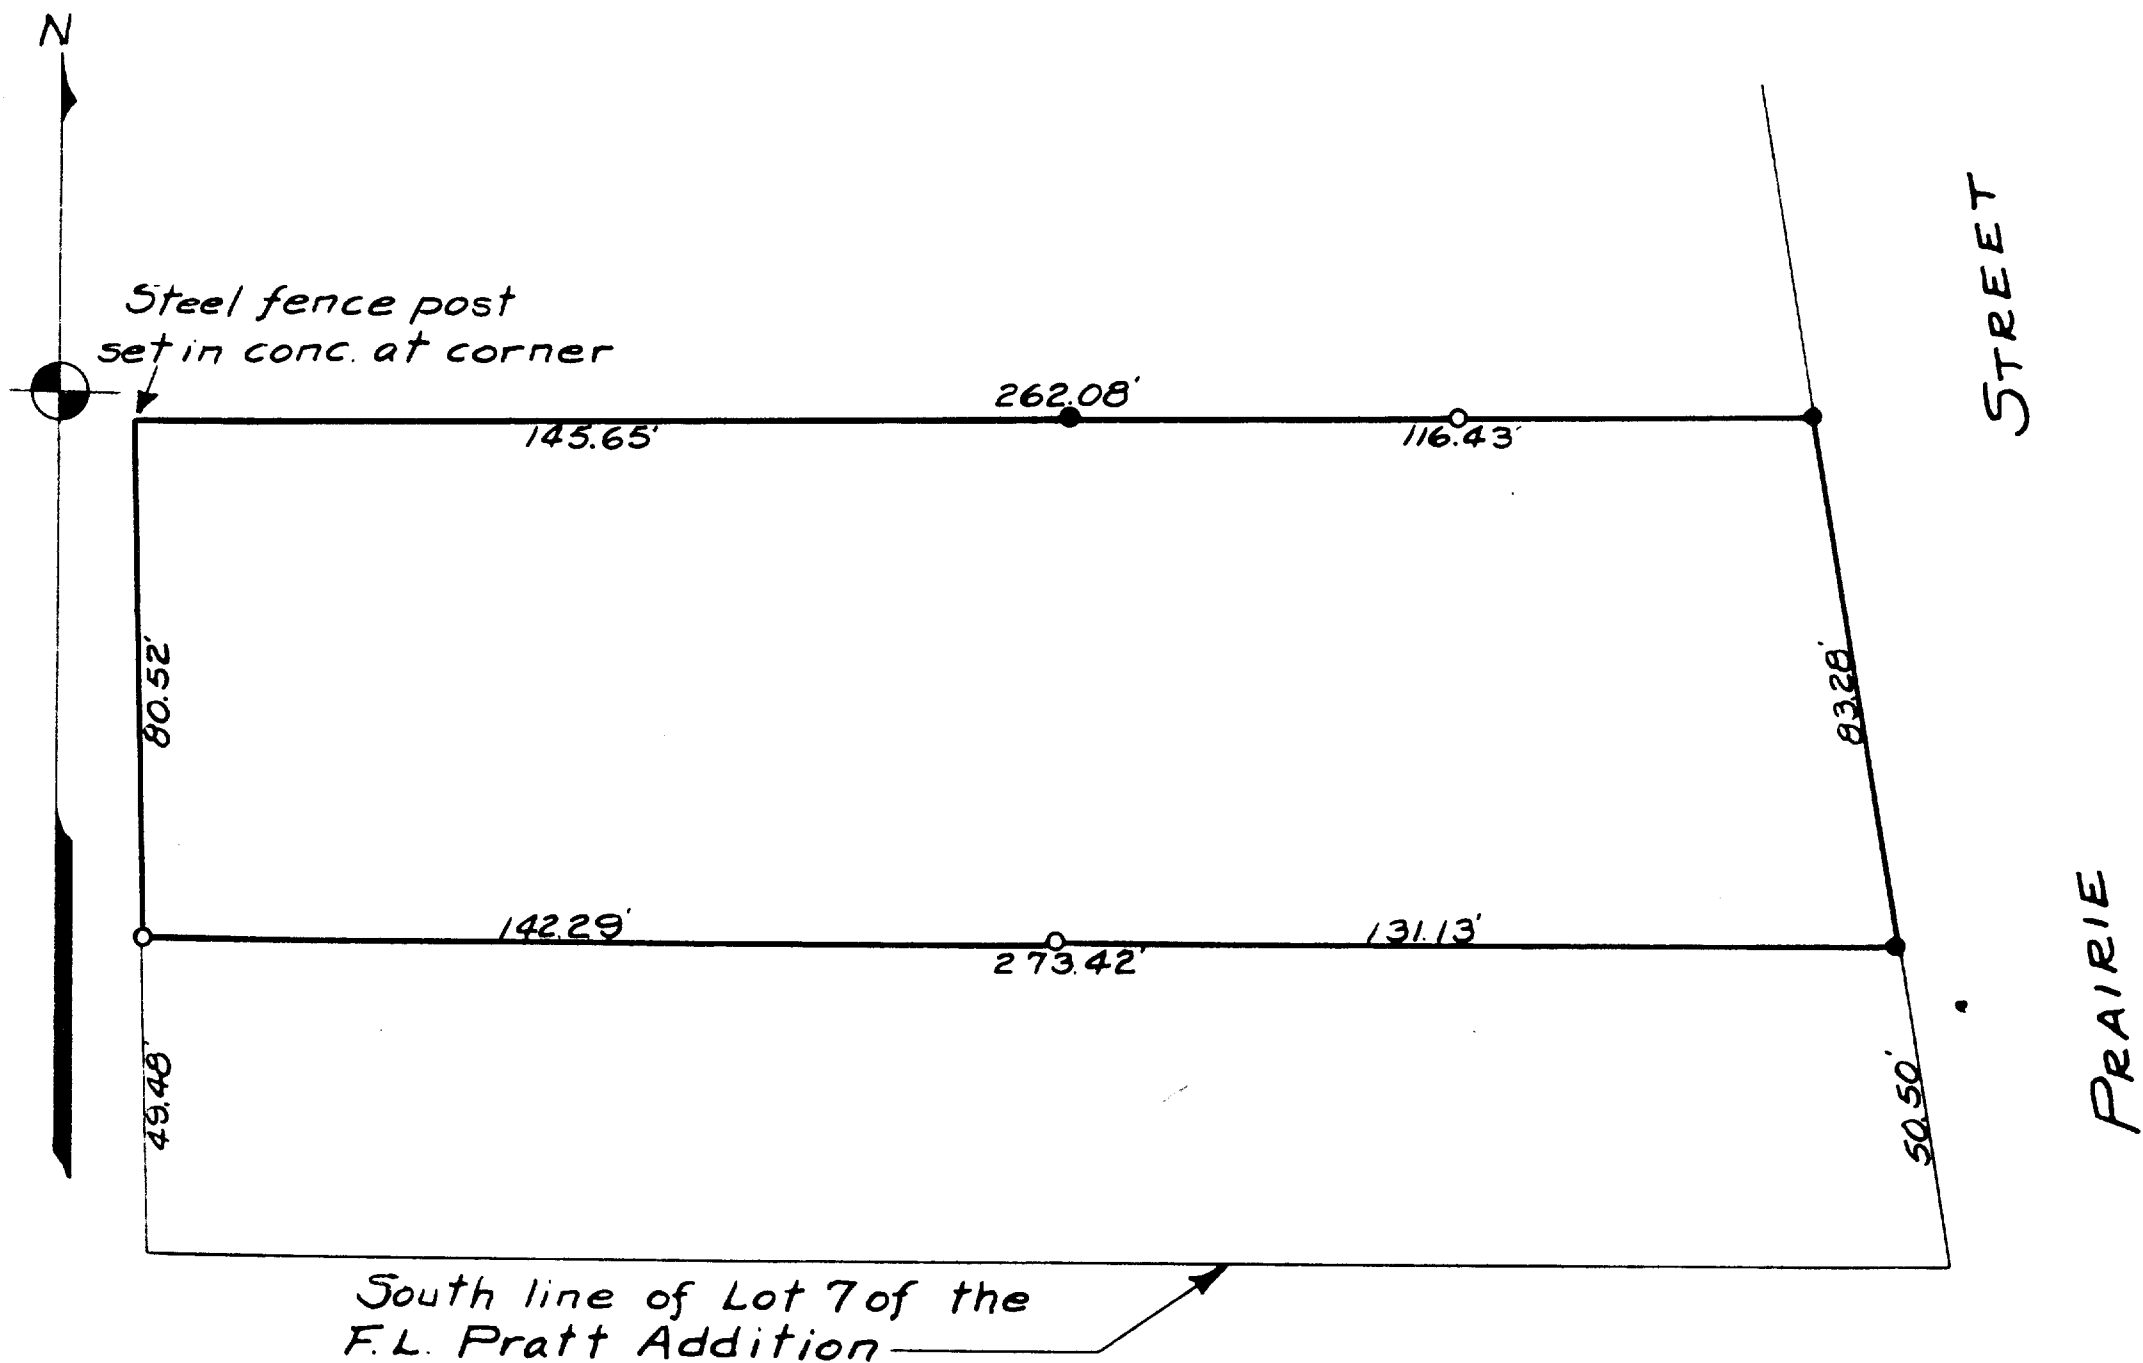

Plat of the survey of part of Lot 7 of
the F.L. Pratt Addition to the City of
Whitewater, Walworth County, Wisconsin.
Scale - 1" = 30'
o - Iron stake
• - Conc. Monu.

Date July 1935

Floyd S. Jensen
County Surveyor