


HAROLD H. KOLB

REGISTERED PROFESSIONAL LAND SURVEYOR
LAKE GENEVA, WISCONSIN

CHERRY STREET 60'

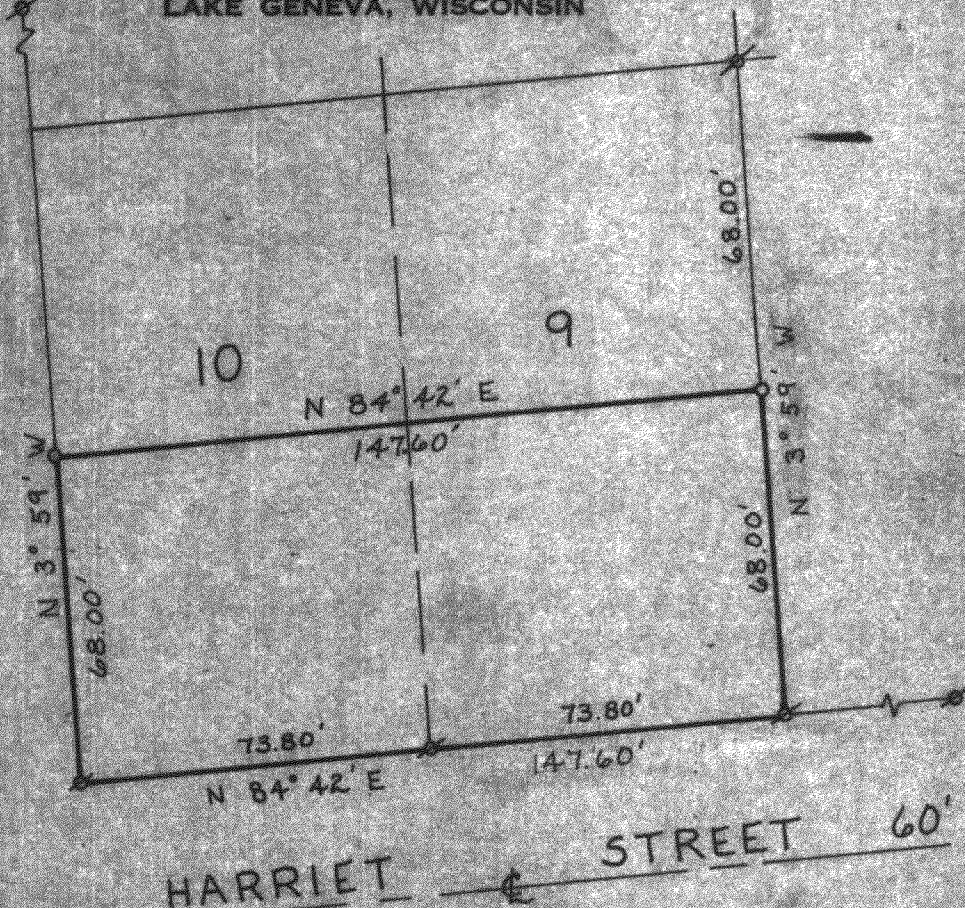


N

Scale: 1"=40'

LEGEND

- ⊕ - IRON PIPE FOUND
- - IRON PIPE PLACED
- - CONCRETE MONUMENT
- x - SPIKE

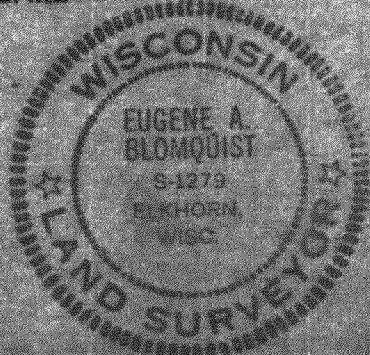

PLAT OF SURVEY OF
The South 1/2 of Lots 9, and 10, Stritzel Sub-
division, Section 4, T 4 N, R15 E, City of
Whitewater, Walworth County, Wisconsin.

Owned by:
Laird Scott
335 A. N. Cherry St.
Whitewater, WI.

Note: Bearings as-
sumed as platted.

I, EUGENE BLOMQUIST DO HEREBY CERTIFY THAT I HAVE
SURVEYED THE PROPERTY HEREON DESCRIBED ACCORDING
TO THE OFFICIAL RECORDS. AND THAT THE PLAT HEREON
IS A CORRECT REPRESENTATION OF THE LOT LINES.

Eugene A. Blomquist
EUGENE A. BLOMQUIST,

WISCONSIN REGISTERED LAND SURVEYOR, S-1279

DATE Oct 5, 1977

10-301