


PLAT OF SURVEY OF Lot 6 and Lot 7, except the West 50 feet of Lot 7,
of Hanford A. Congar's Subdivision of Block 6 in Birge's Addition to the
Village (now city) of Whitewater, Walworth County, Wisconsin.

I certify that I have surveyed the above described property and that the
plat shown hereon is an accurate survey and a true representation thereof
and correctly shows the boundary lines of said property and all encroachments
if any.

Dec. 19, 1977

Thomas P. A. Jensen
THOMAS P. A. JENSEN S-1084
JENSEN SURVEYING & MAPPING
ELKHORN, WISCONSIN

Surveyed for; J.M. Green, owner.

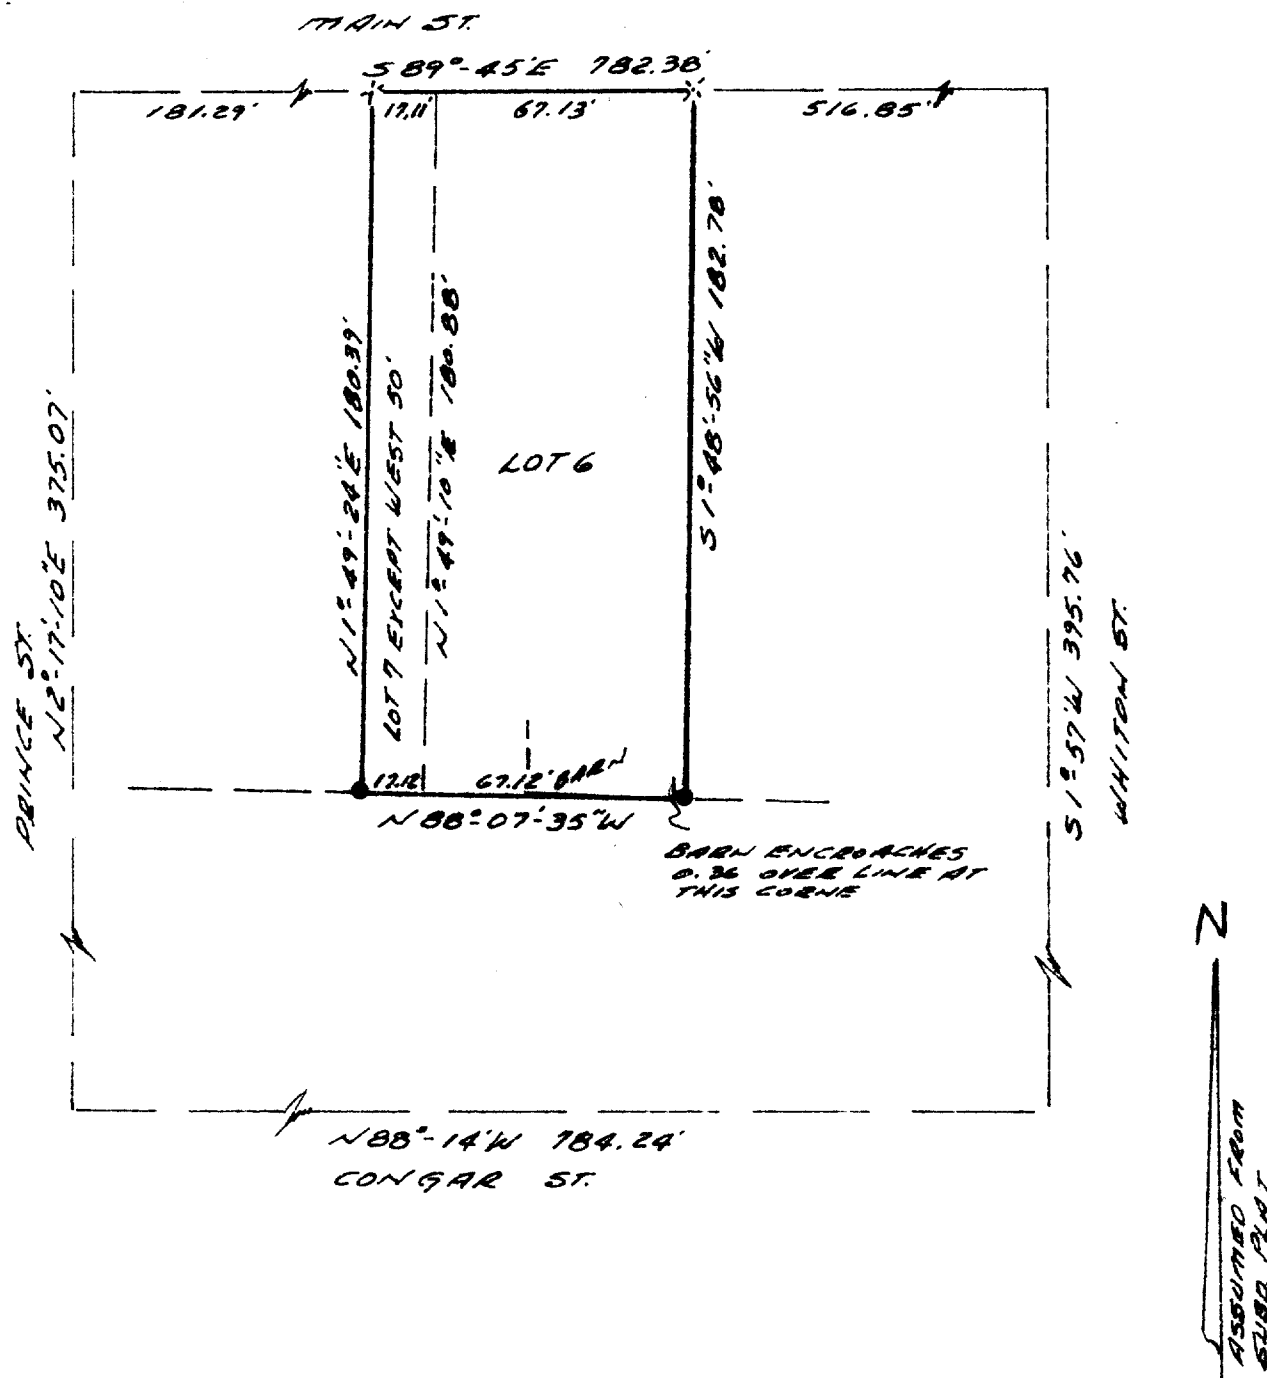

SCALE 1" = 50'
● ~ IRON ROD SET
X ~ CROSS CUT
IN CONG.