



PLAT OF SURVEY of Lot 2 and parts of Lot 17 and Lot 18, of Hanford A. Congar's
 Subdivision of Block 6 in Birge's Addition to the Village (now city) of
 Whitewater, Walworth County, Wisconsin.

I certify that I have surveyed the above described property and that the
 plat shown hereon is an accurate survey and a true representation thereof
 and correctly shows the boundary lines of said property and all encroachments
 if any.

Dec. 19, 1977

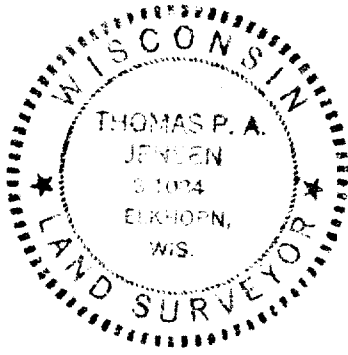

Thomas P.A. Jensen
 THOMAS P.A. JENSEN S-1084
 JENSEN SURVEYING & MAPPING
 ELKHORN, WISCONSIN

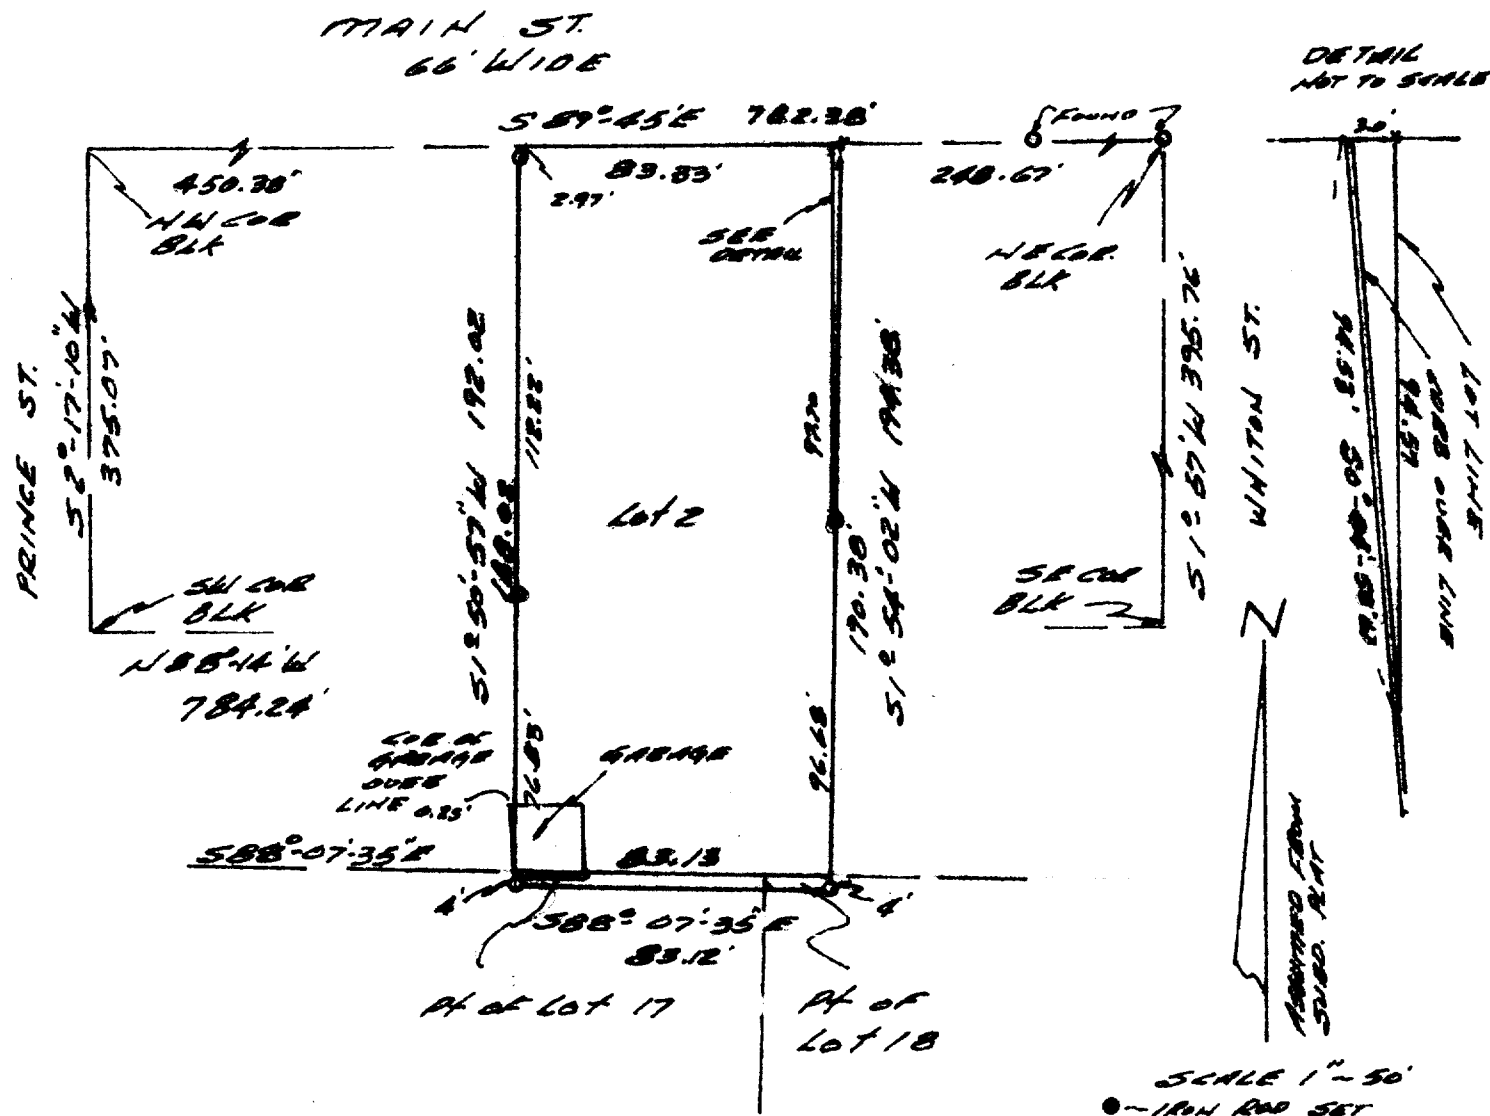

Surveyed for : J.M. Green, Owner

NOTE: DESCRIPTION OF DRIVEWAY ENCROACHMENT

Begin at the NE Corner of Lot 2, Block 6 of Hanford A. Congar's
 Subdivision of Block 6 in Birge's Addition to the Village (now city)
 of Whitewater; thence N89°-45'W 3.00 feet; thence S0°-04'-58"W 94.53
 feet to the East line of said Lot 2; thence N1°-54'-02"E, along the
 said East line, 94.57 feet to the point of beginning.

NOTE: The above survey is of land described in W.D. Vol. 540 P. 271
 recorded in the register of deeds, Walworth County, Court House.