


168/70

O-INDICATES IRON PIPE

PRAIRIE ST.

BOON ST.


CENTER ST.

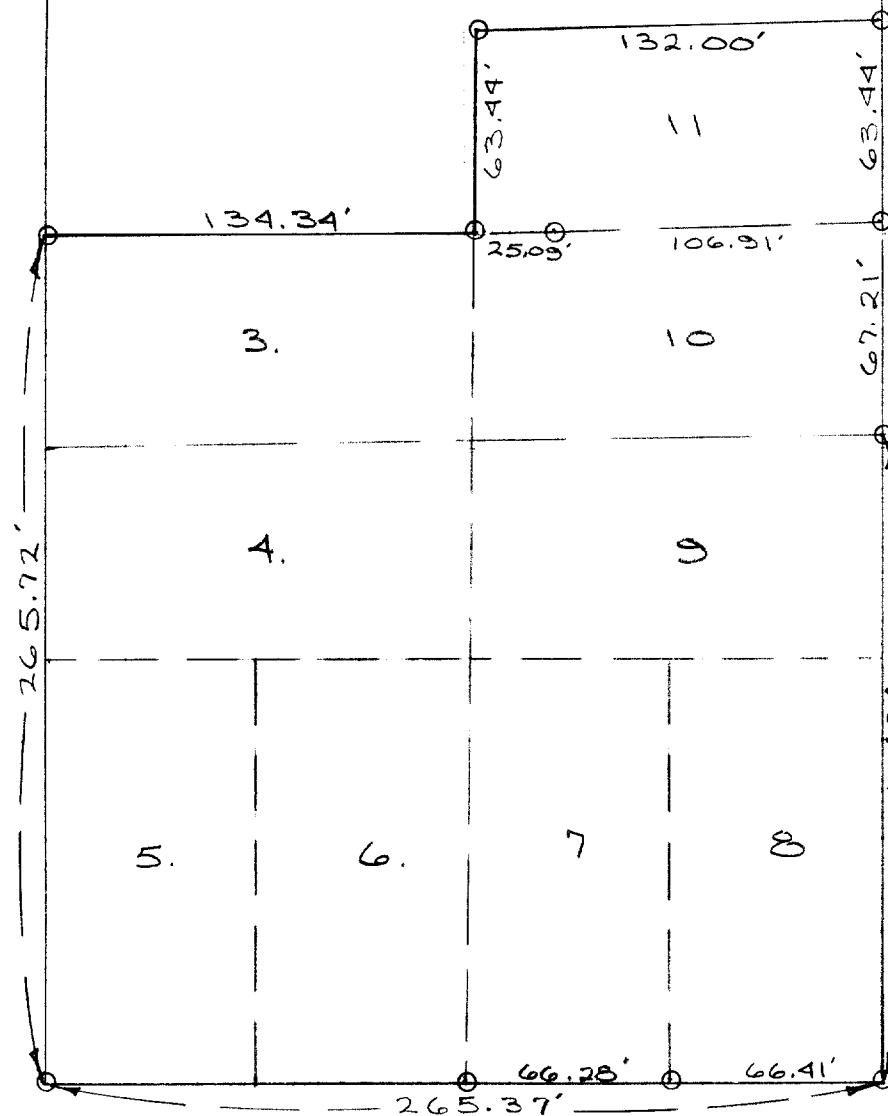

DESCRIPTION: Lots 3, 4, 5, 6, 7, 8, 9, 10, and 11 of Block
16 in Chapman and Ludingtons Addition to the
City of Whitewater, Walworth County, Wisconsin.

CERTIFICATE: I, James F. Biagi, surveyor, do hereby certify that
I have surveyed the property hereon described.

August 21, 1970

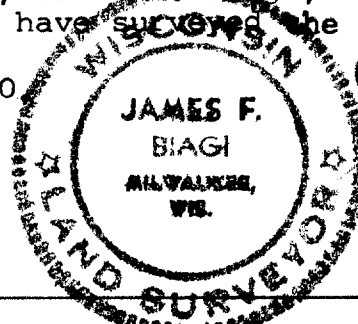

James F. Biagi, R.L.S. 272