


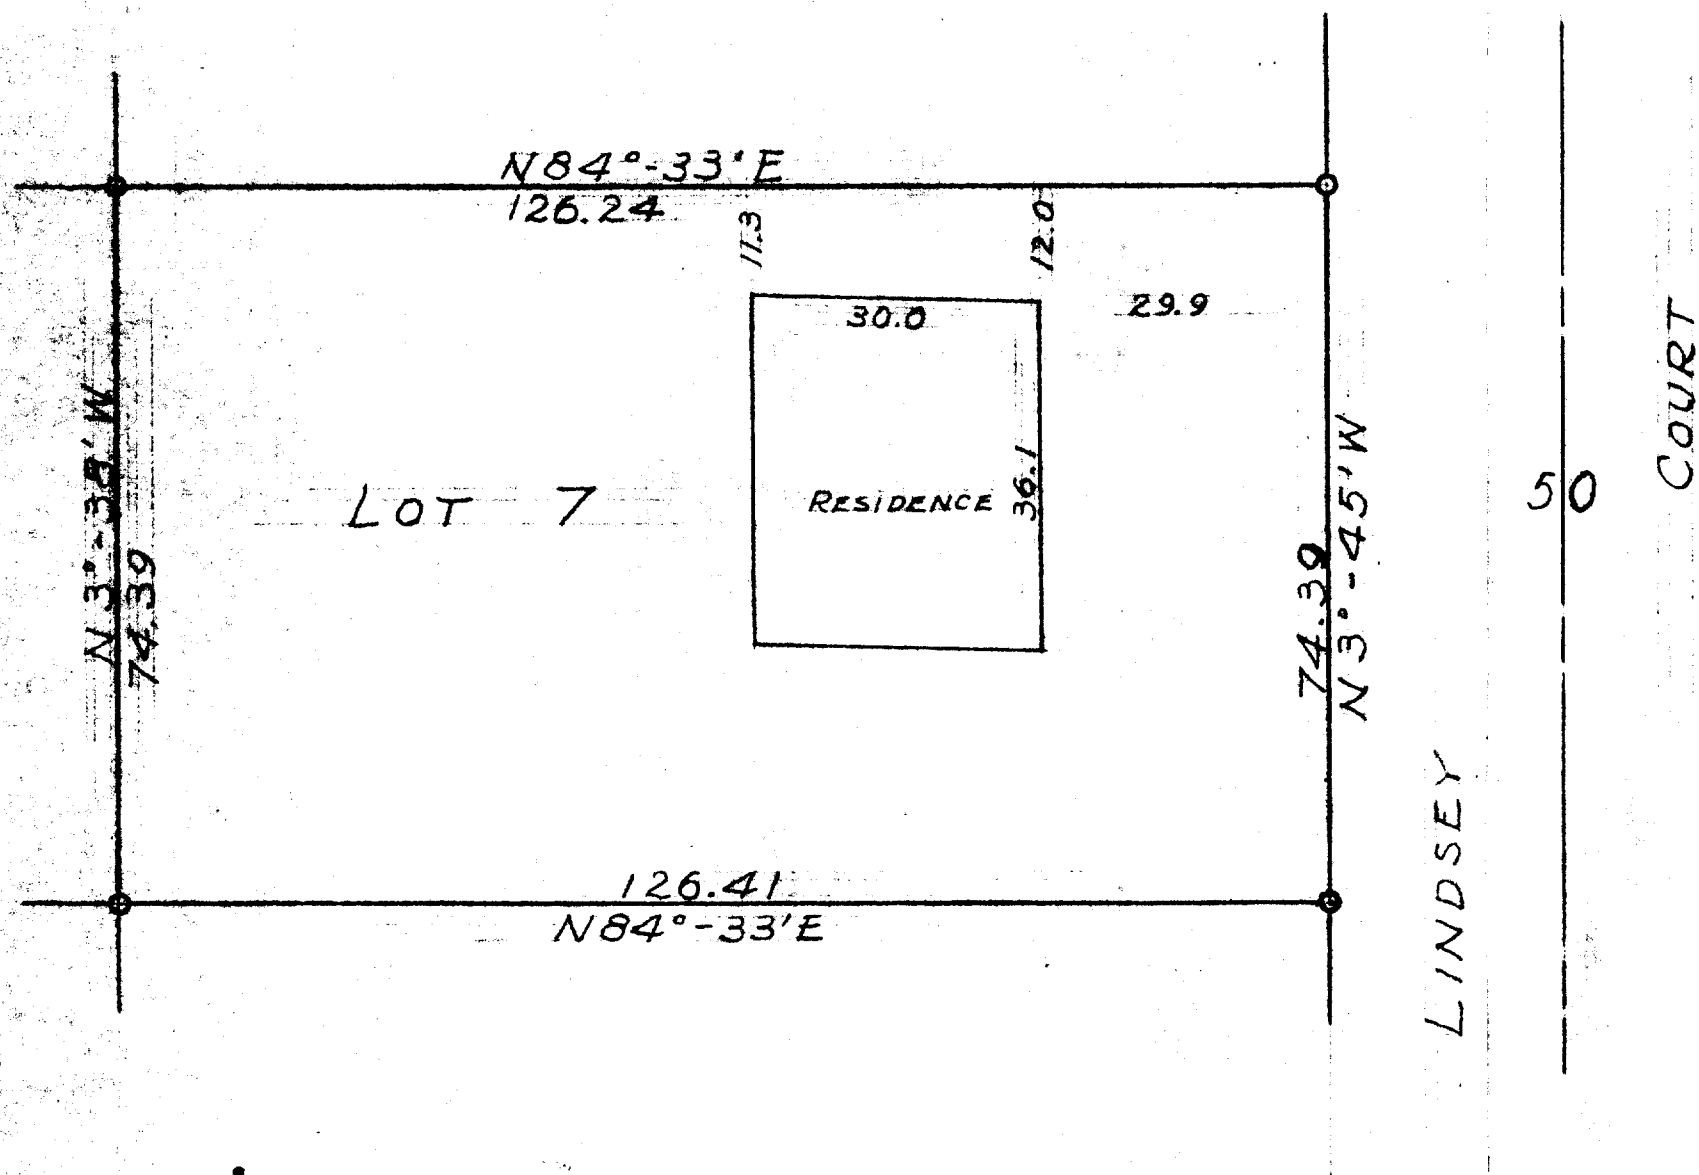

N

SCALE ~ 1"=20'
O ~ IRON PIPE

STATE OF WISCONSIN } S.S.
COUNTY OF WALWORTH }

I, GEORGE T. DUNHAM, DO HEREBY CERTIFY THAT I HAVE
SURVEYED THE PROPERTY DESCRIBED AS FOLLOWS:

LOT 7, BELL-AIRE HEIGHTS LOCATED IN THE
SOUTHEAST 1/4 OF THE NORTHWEST 1/4 OF SECTION 5,
T4N R15E, CITY OF WHITEWATER, WALWORTH COUNTY, WISCONSIN.

AND THAT THE PLAT SHOWN ABOVE IS A CORRECT REPRESENTATION
OF THE PROPERTY LINES AND OF THE BUILDINGS LOCATED THEREON.
JULY 12, 1957

George T. Dunham
GEORGE T. DUNHAM, SURVEYOR
DELAVER, WISCONSIN