


PRAIRIE ST.

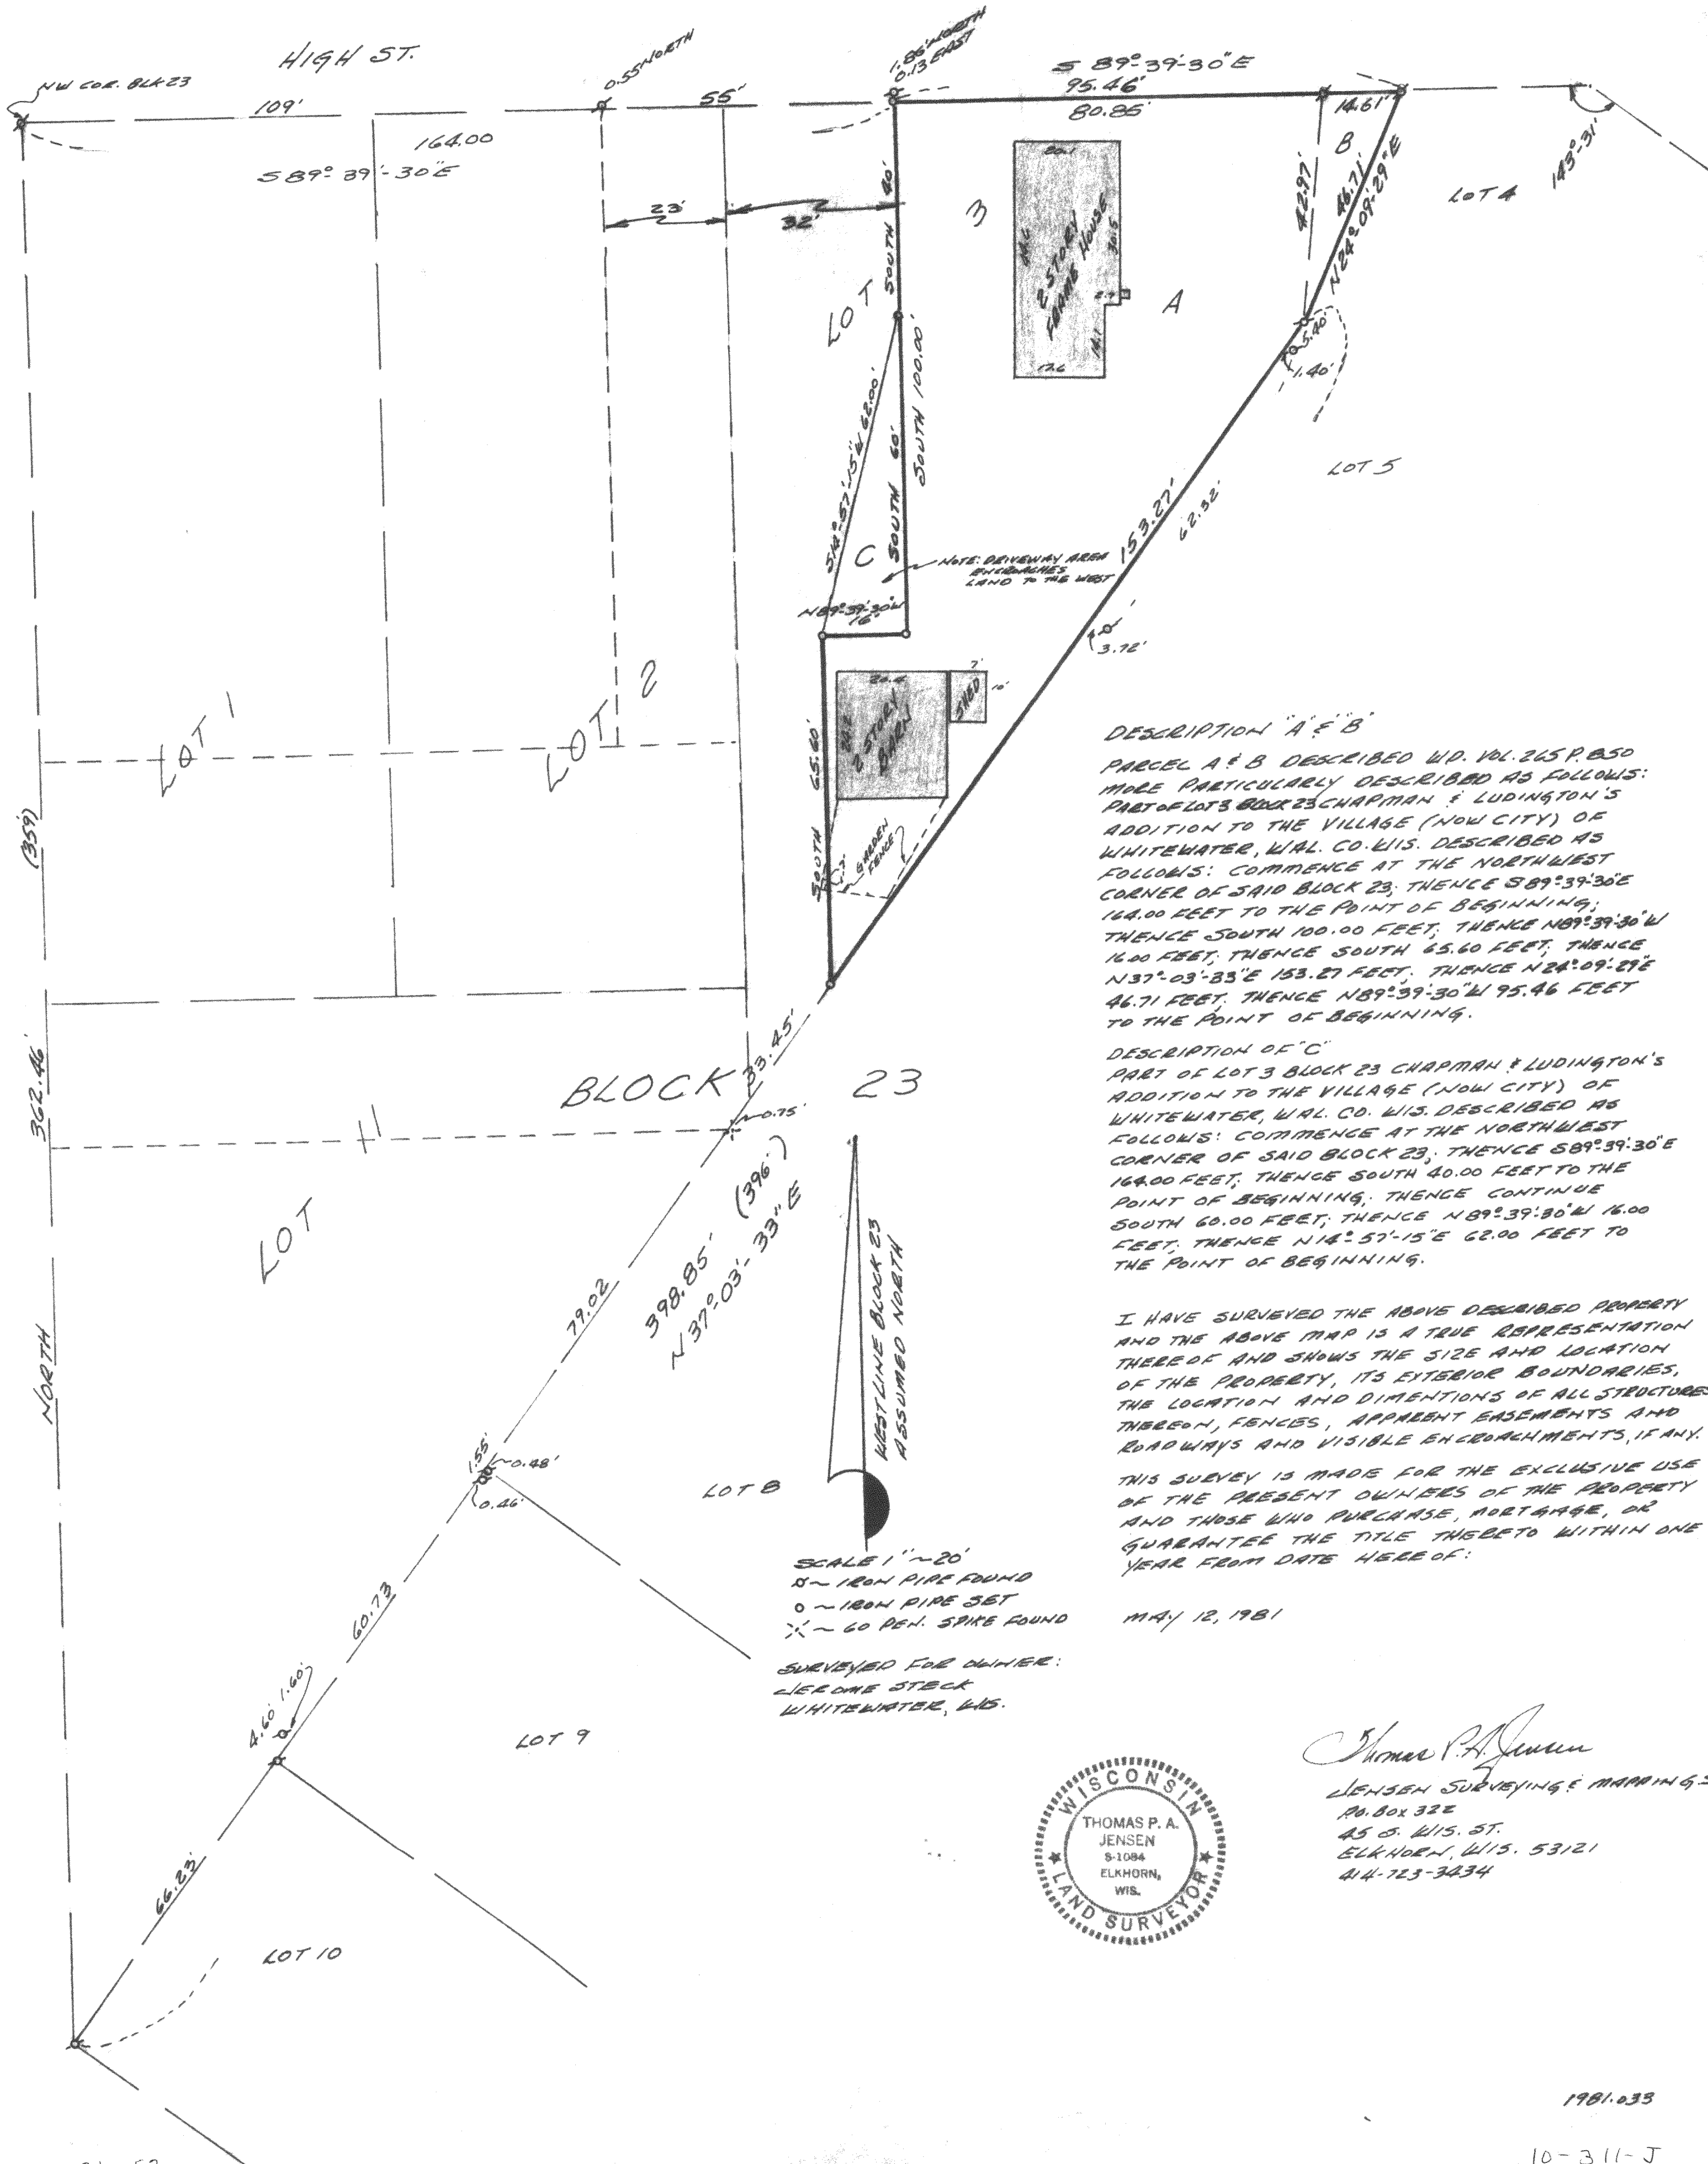

DESCRIPTION "A" & "B"

PARCEL A & B DESCRIBED W.D. VOL. 265 P. 850 MORE PARTICULARLY DESCRIBED AS FOLLOWS: PART OF LOT 3 BLOCK 23 CHAPMAN & LUDINGTON'S ADDITION TO THE VILLAGE (NOW CITY) OF WHITEWATER, WIAL. CO. WIS. DESCRIBED AS FOLLOWS: COMMENCE AT THE NORTHWEST CORNER OF SAID BLOCK 23; THENCE $S 89^{\circ} 39' 30'' E$ 164.00 FEET TO THE POINT OF BEGINNING; THENCE SOUTH 100.00 FEET; THENCE $N 89^{\circ} 39' 30'' W$ 16.00 FEET; THENCE SOUTH 65.60 FEET; THENCE $N 37^{\circ} 03' 33'' E$ 153.27 FEET; THENCE $N 24^{\circ} 09' 29'' E$ 46.71 FEET; THENCE $N 89^{\circ} 39' 30'' W$ 95.46 FEET TO THE POINT OF BEGINNING.

DESCRIPTION OF "C"


PART OF LOT 3 BLOCK 23 CHAPMAN & LUDINGTON'S ADDITION TO THE VILLAGE (NOW CITY) OF WHITEWATER, WIAL. CO. WIS. DESCRIBED AS FOLLOWS: COMMENCE AT THE NORTHWEST CORNER OF SAID BLOCK 23; THENCE $S 89^{\circ} 39' 30'' E$ 164.00 FEET; THENCE SOUTH 40.00 FEET TO THE POINT OF BEGINNING; THENCE CONTINUE SOUTH 60.00 FEET; THENCE $N 89^{\circ} 39' 30'' W$ 16.00 FEET; THENCE $N 14^{\circ} 57' 15'' E$ 62.00 FEET TO THE POINT OF BEGINNING.

I HAVE SURVEYED THE ABOVE DESCRIBED PROPERTY AND THE ABOVE MAP IS A TRUE REPRESENTATION THEREOF AND SHOWS THE SIZE AND LOCATION OF THE PROPERTY, ITS EXTERIOR BOUNDARIES, THE LOCATION AND DIMENSIONS OF ALL STRUCTURES THEREON, FENCES, APPARENT EASEMENTS AND ROADWAYS AND VISIBLE ENCROACHMENTS, IF ANY. THIS SURVEY IS MADE FOR THE EXCLUSIVE USE OF THE PRESENT OWNERS OF THE PROPERTY AND THOSE WHO PURCHASE, MORTGAGE, OR GUARANTEE THE TITLE THERE TO WITHIN ONE YEAR FROM DATE HERE OF:

MAY 12, 1981

SCALE 1" = 20'
 X - IRON PIPE FOUND
 O - IRON PIPE SET
 X - 60 PEN. SPIKE FOUND

SURVEYED FOR OWNER:
 JEROME STECK
 WHITEWATER, WIS.

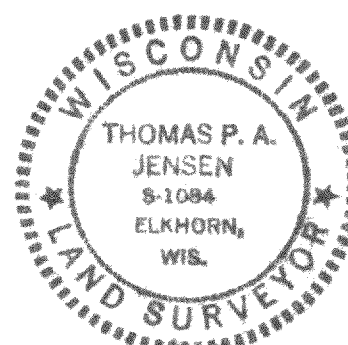

Thomas P. A. Jensen
 JENSEN SURVEYING & MAPPING, S.C.
 P.O. Box 328
 45 S. WIS. ST.
 ELKHORN, WIS. 53121
 414-723-3434

1981-033

10-311-J