


ENGINEERING, SURVEYING AND LAND PLANNING
715 W. WALWORTH ST. - P.O. BOX 467 - ELKHORN, WI 53121
OFFICE: 414/723-2000

CA-2
Please split
Parcel

CLARK STREET
(50.16' WIDE)

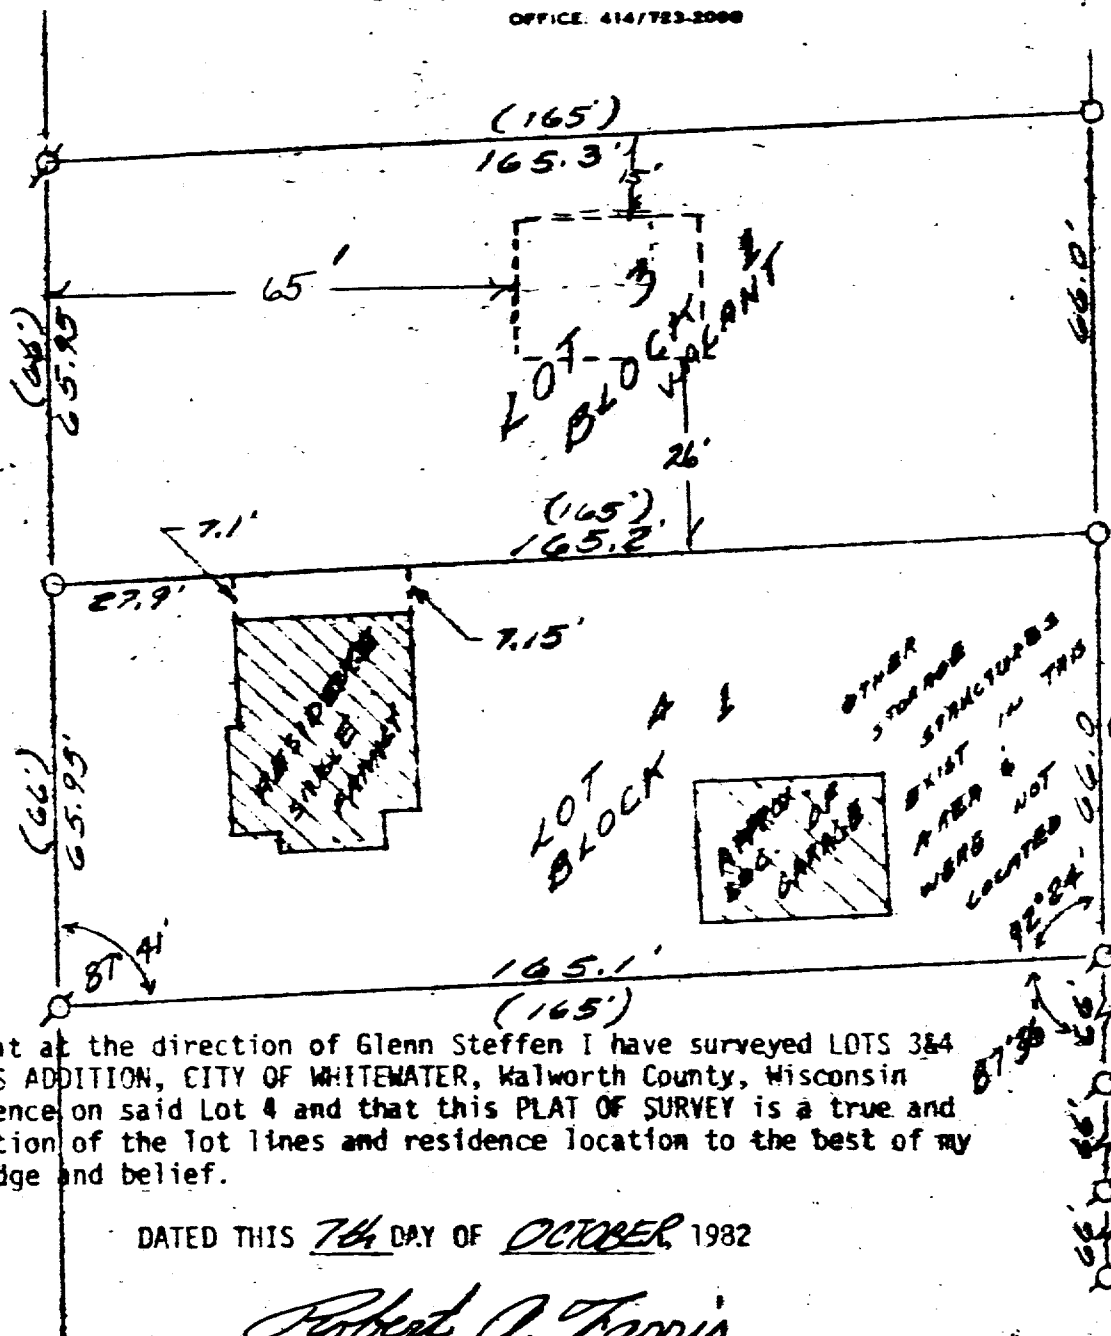

Q = IRON PIPE SURVEY
STAKE FOUND
O = 1" X 24" IRON PIPE
STAKE SET
(XX) = RECORD DIMENSION

I HEREBY CERTIFY that at the direction of Glenn Steffen I have surveyed LOTS 3 & 4 of BLOCK 1 of CAINES ADDITION, CITY OF WHITEWATER, Walworth County, Wisconsin and located a residence on said Lot 4 and that this PLAT OF SURVEY is a true and accurate representation of the lot lines and residence location to the best of my professional knowledge and belief.

DATED THIS 7th DAY OF OCTOBER, 1982

Robert A. Farris
Robert A. Farris, RLS

DRAWING NUMBER 2018

10-315-F

