


JEFFERSON

STREET

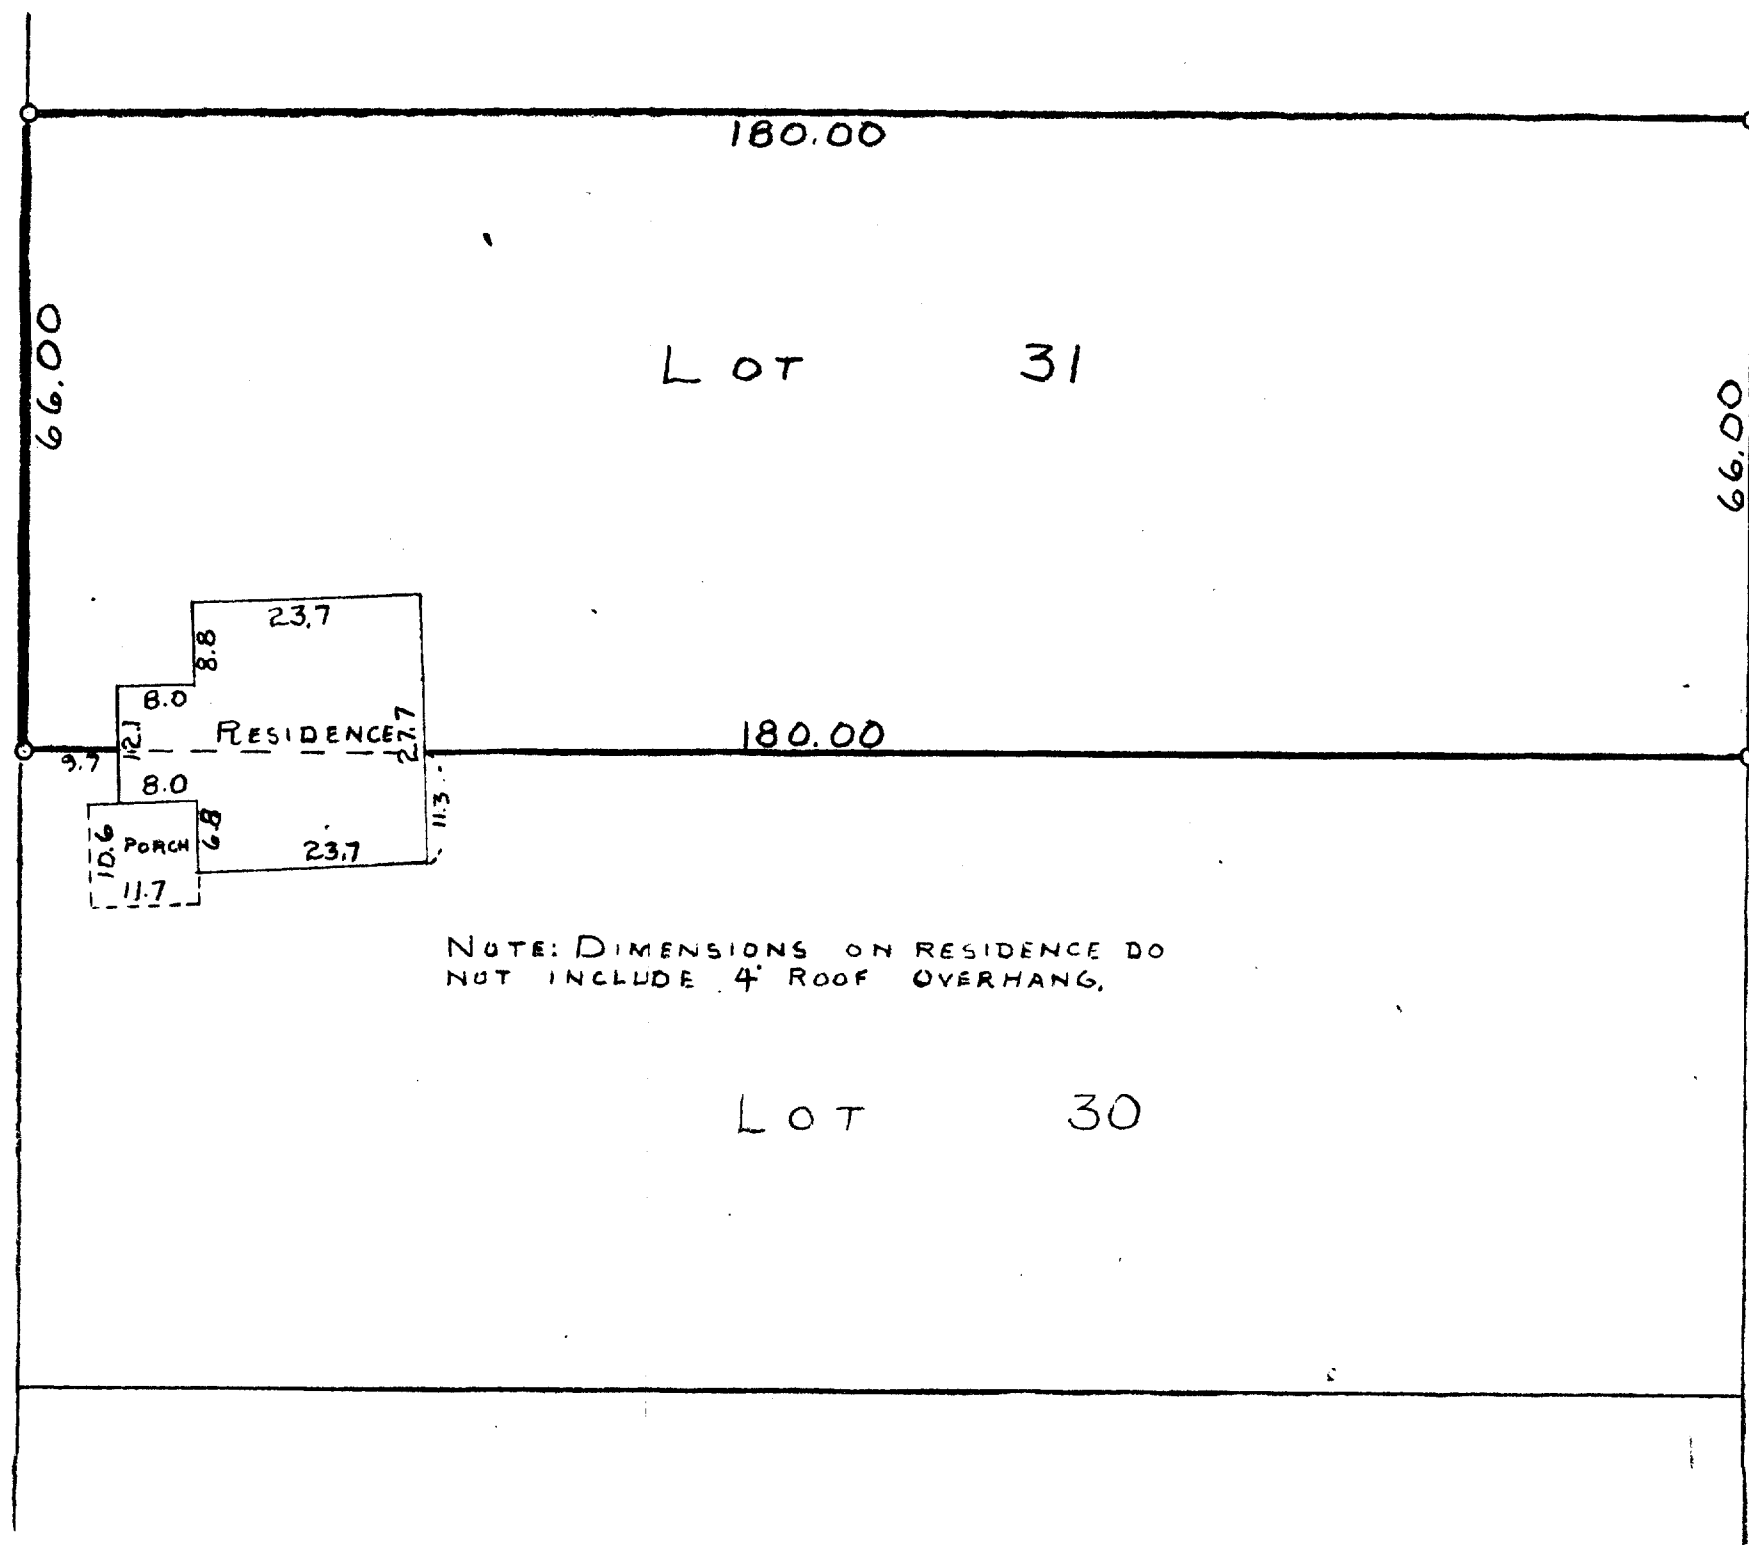

N

SCALE 1"=20'
O=IRON PIPE

PLAT OF SURVEY OF LOT 31, BLOCK 4, WILSON'S ADDITION,
CITY OF WHITEWATER, WALWORTH COUNTY, WISCONSIN.
NOV. 15, 1956

George T. Dunham
GEORGE T. DUNHAM, SURVEYOR
DELAVER, WISCONSIN

10-32

WSS-43