



PLAT OF SURVEY OF LOTS 4 & 5,
BLOCK 5, TRIPP'S ADDITION TO THE
CITY OF WHITEWATER, WALWORTH
COUNTY, WISCONSIN

ANN STREET
60' WIDE PUBLIC ROAD

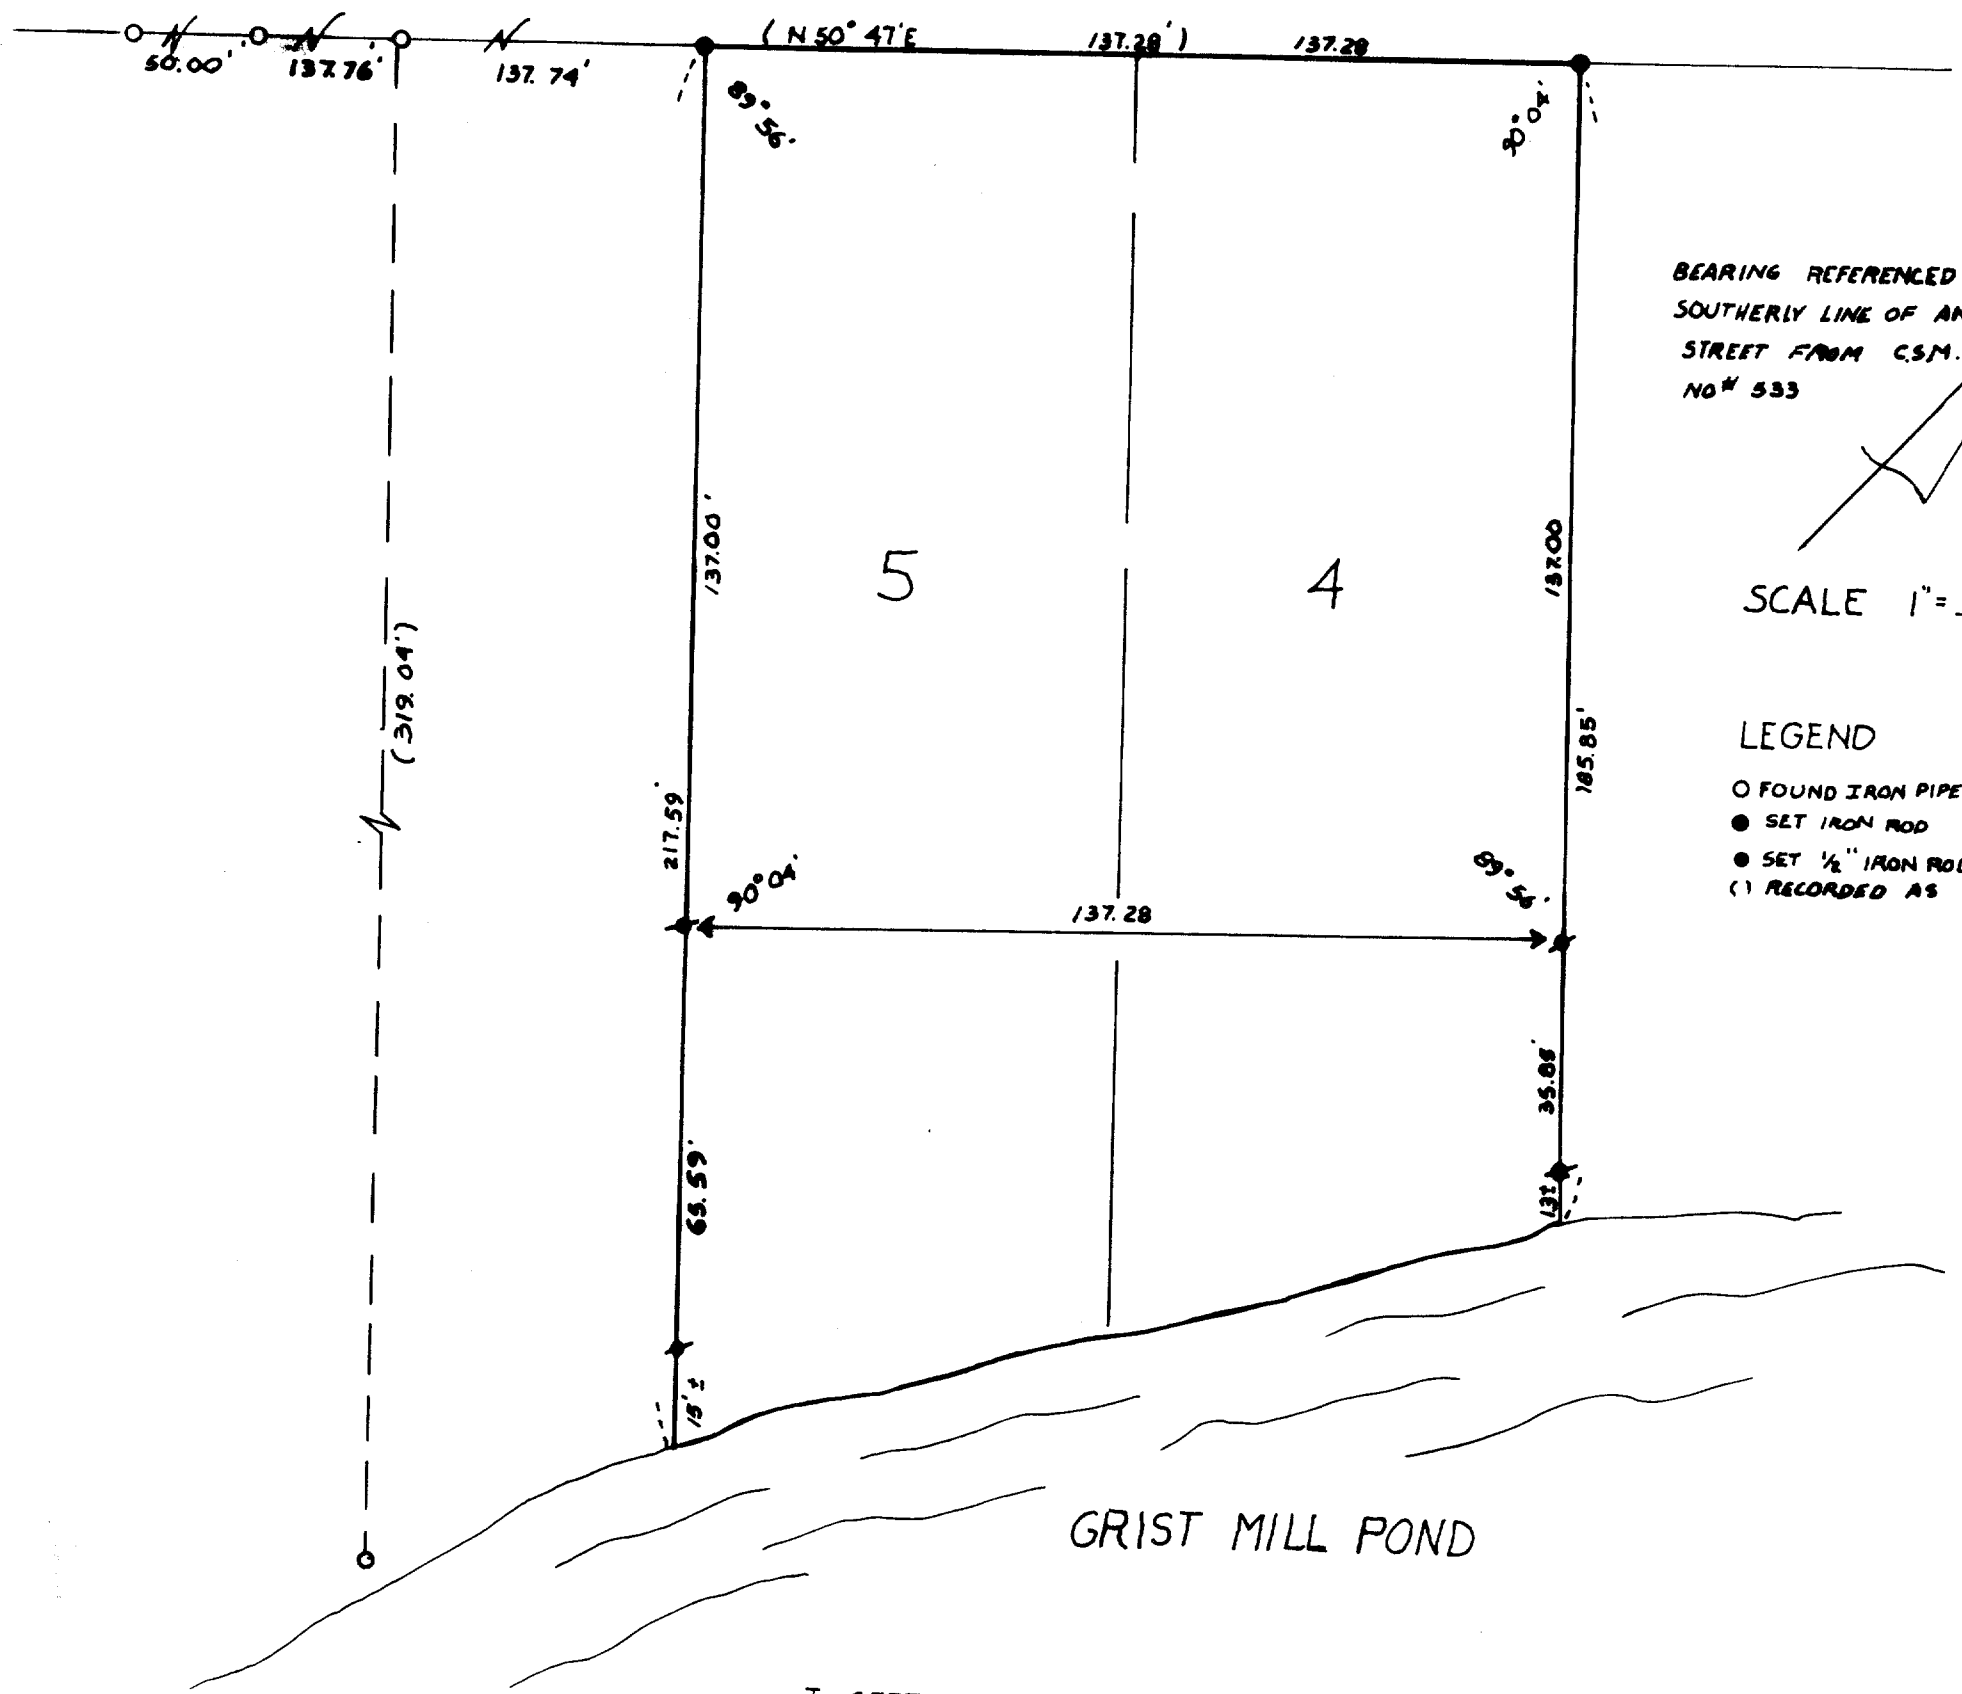

I CERTIFY THAT I HAVE SURVEYED THE ABOVE DESCRIBED PROPERTY
AND THE PLAT SHOWN HEREON IS AN ACCURATE SURVEY AND
CORRECTLY SHOWS THE EXTERIOR BOUNDARY LINES ON SAID PROPERTY
AND THE CORRECT MEASUREMENTS THEREOF

Thomas P. A. Jensen
THOMAS P. A. JENSEN R.L.S. #1084

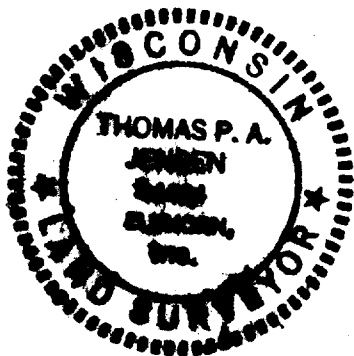

JENSEN SURVEYING & MAPPING S.C.

P.O. BOX 322
EIKHORN WI. 53121
(414) 723-3434

MAPPING DATE 6-13-83

