

WALNORTH COUNTY

KARL W. FUGE & ASSOCIATES
ENGINEERS — DESIGNERS
Fort Atkinson, Wisconsin

Name — Standard Oil Co.

Map No. 102

Address — 111 W. Madison St., Milwaukee, Wis.

Description — This is a lot in Block 3 of Trapp Addition to the City of Walworth, Wisconsin, described as follows: Beginning at an iron pipe stake at the corner of said lot; thence S 88° 54' E 100.0 feet along the East line of Depot Block; thence N 10° 42' E 100.0 feet parallel with the north line of said lot; thence S 88° 54' E 100.0 feet to an iron pipe stake at the north line of said lot; thence S 88° 54' E 100.0 feet to the point of beginning.

NOTE: Fence along east side is over the line as shown.



Scale of Map — 1" = 100 feet

STATE OF WISCONSIN
COUNTY OF PETERSON

LEGEND

- Iron Pipes Found
- Iron Pipes Set
- Reference Point


I, Karl W. Fuge, a registered Engineer of the State of Wisconsin, do hereby certify that on February 17, 1914, I surveyed the above described property according to official records and that the accompanying map is a correctly dimensioned representation to scale of the field notes. That all buildings and improvements shown on the said map are shown as they appear from said survey.

TOP OF POLE
BASE OF POLE

ARM 3 WIRES 26.40' VOLT
LE ARM 3 WIRES 23.00' VOLT
ARM 3 WIRES 24.00' VOLT

ALL WIRES EXCEPT 1
RE SOUTH OF THE POLES.

POWER WIRE 8' 7" HIGH
TOP OF TANK

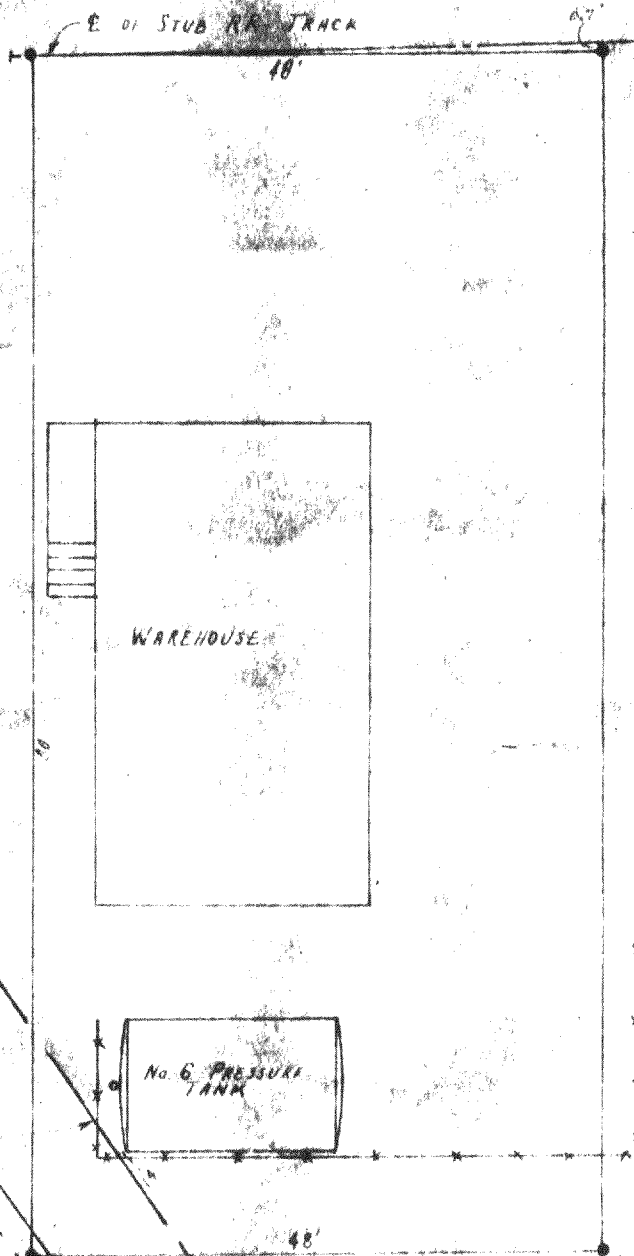

SCALE 1/16" = 10'

TOP OF POLE
BASE OF POLE

10-327