



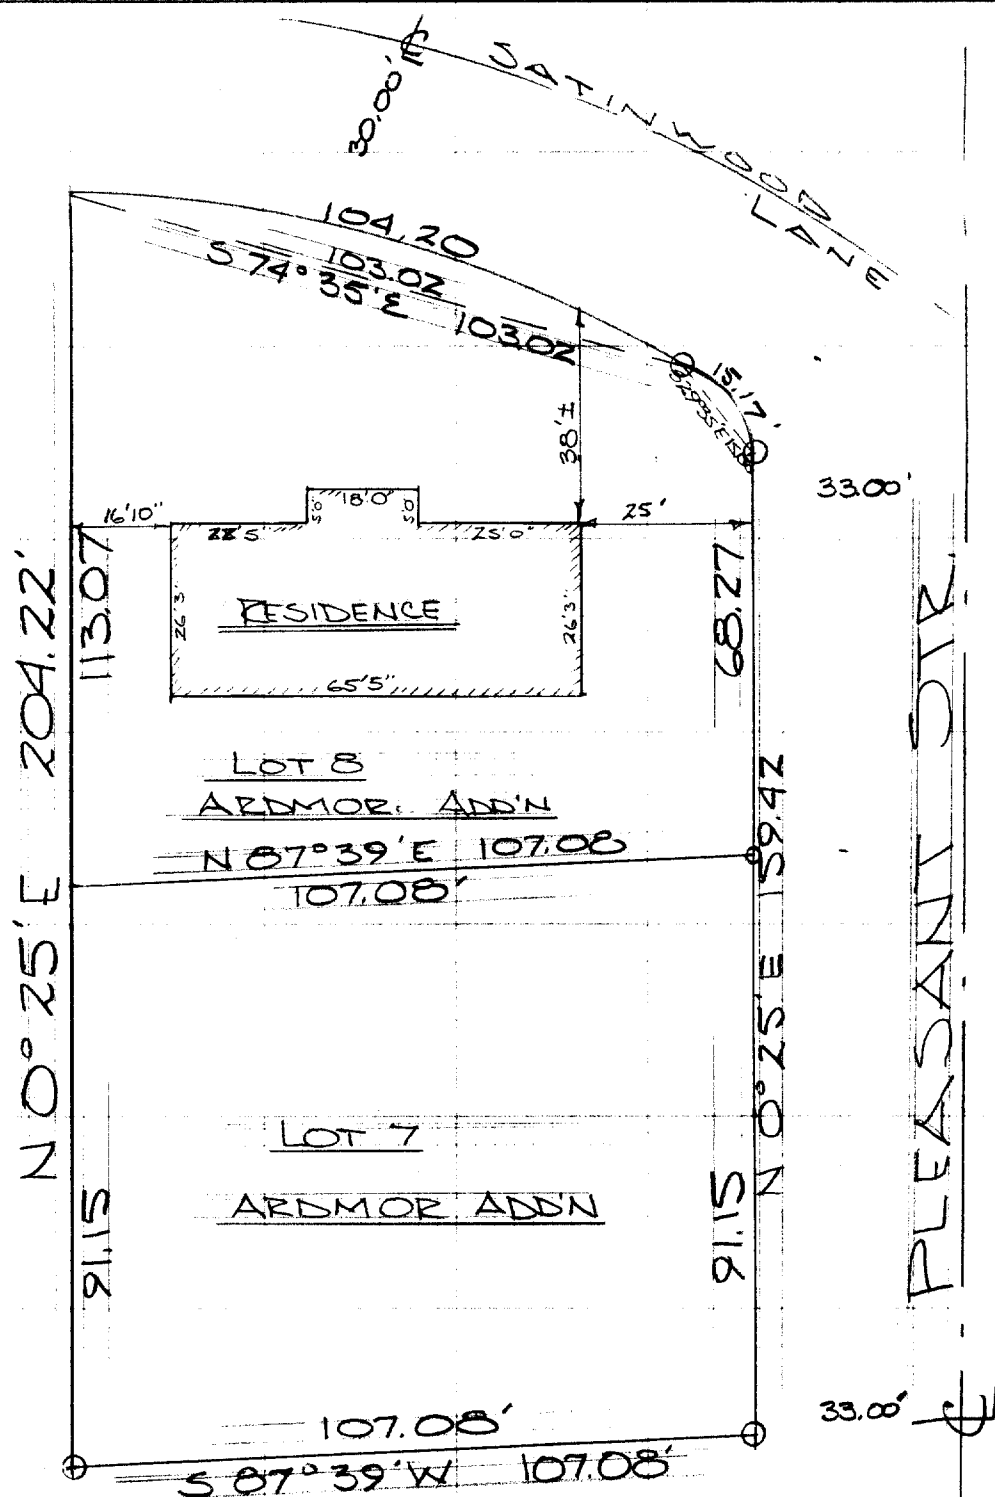

CERTIFICATE: I, James F. Biagi, surveyor do hereby certify that I have surveyed the property hereon described and that the location of the improvements are as shown.

James F. Biagi, ELS 272

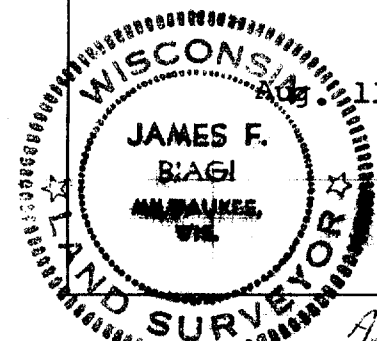

10-32B