


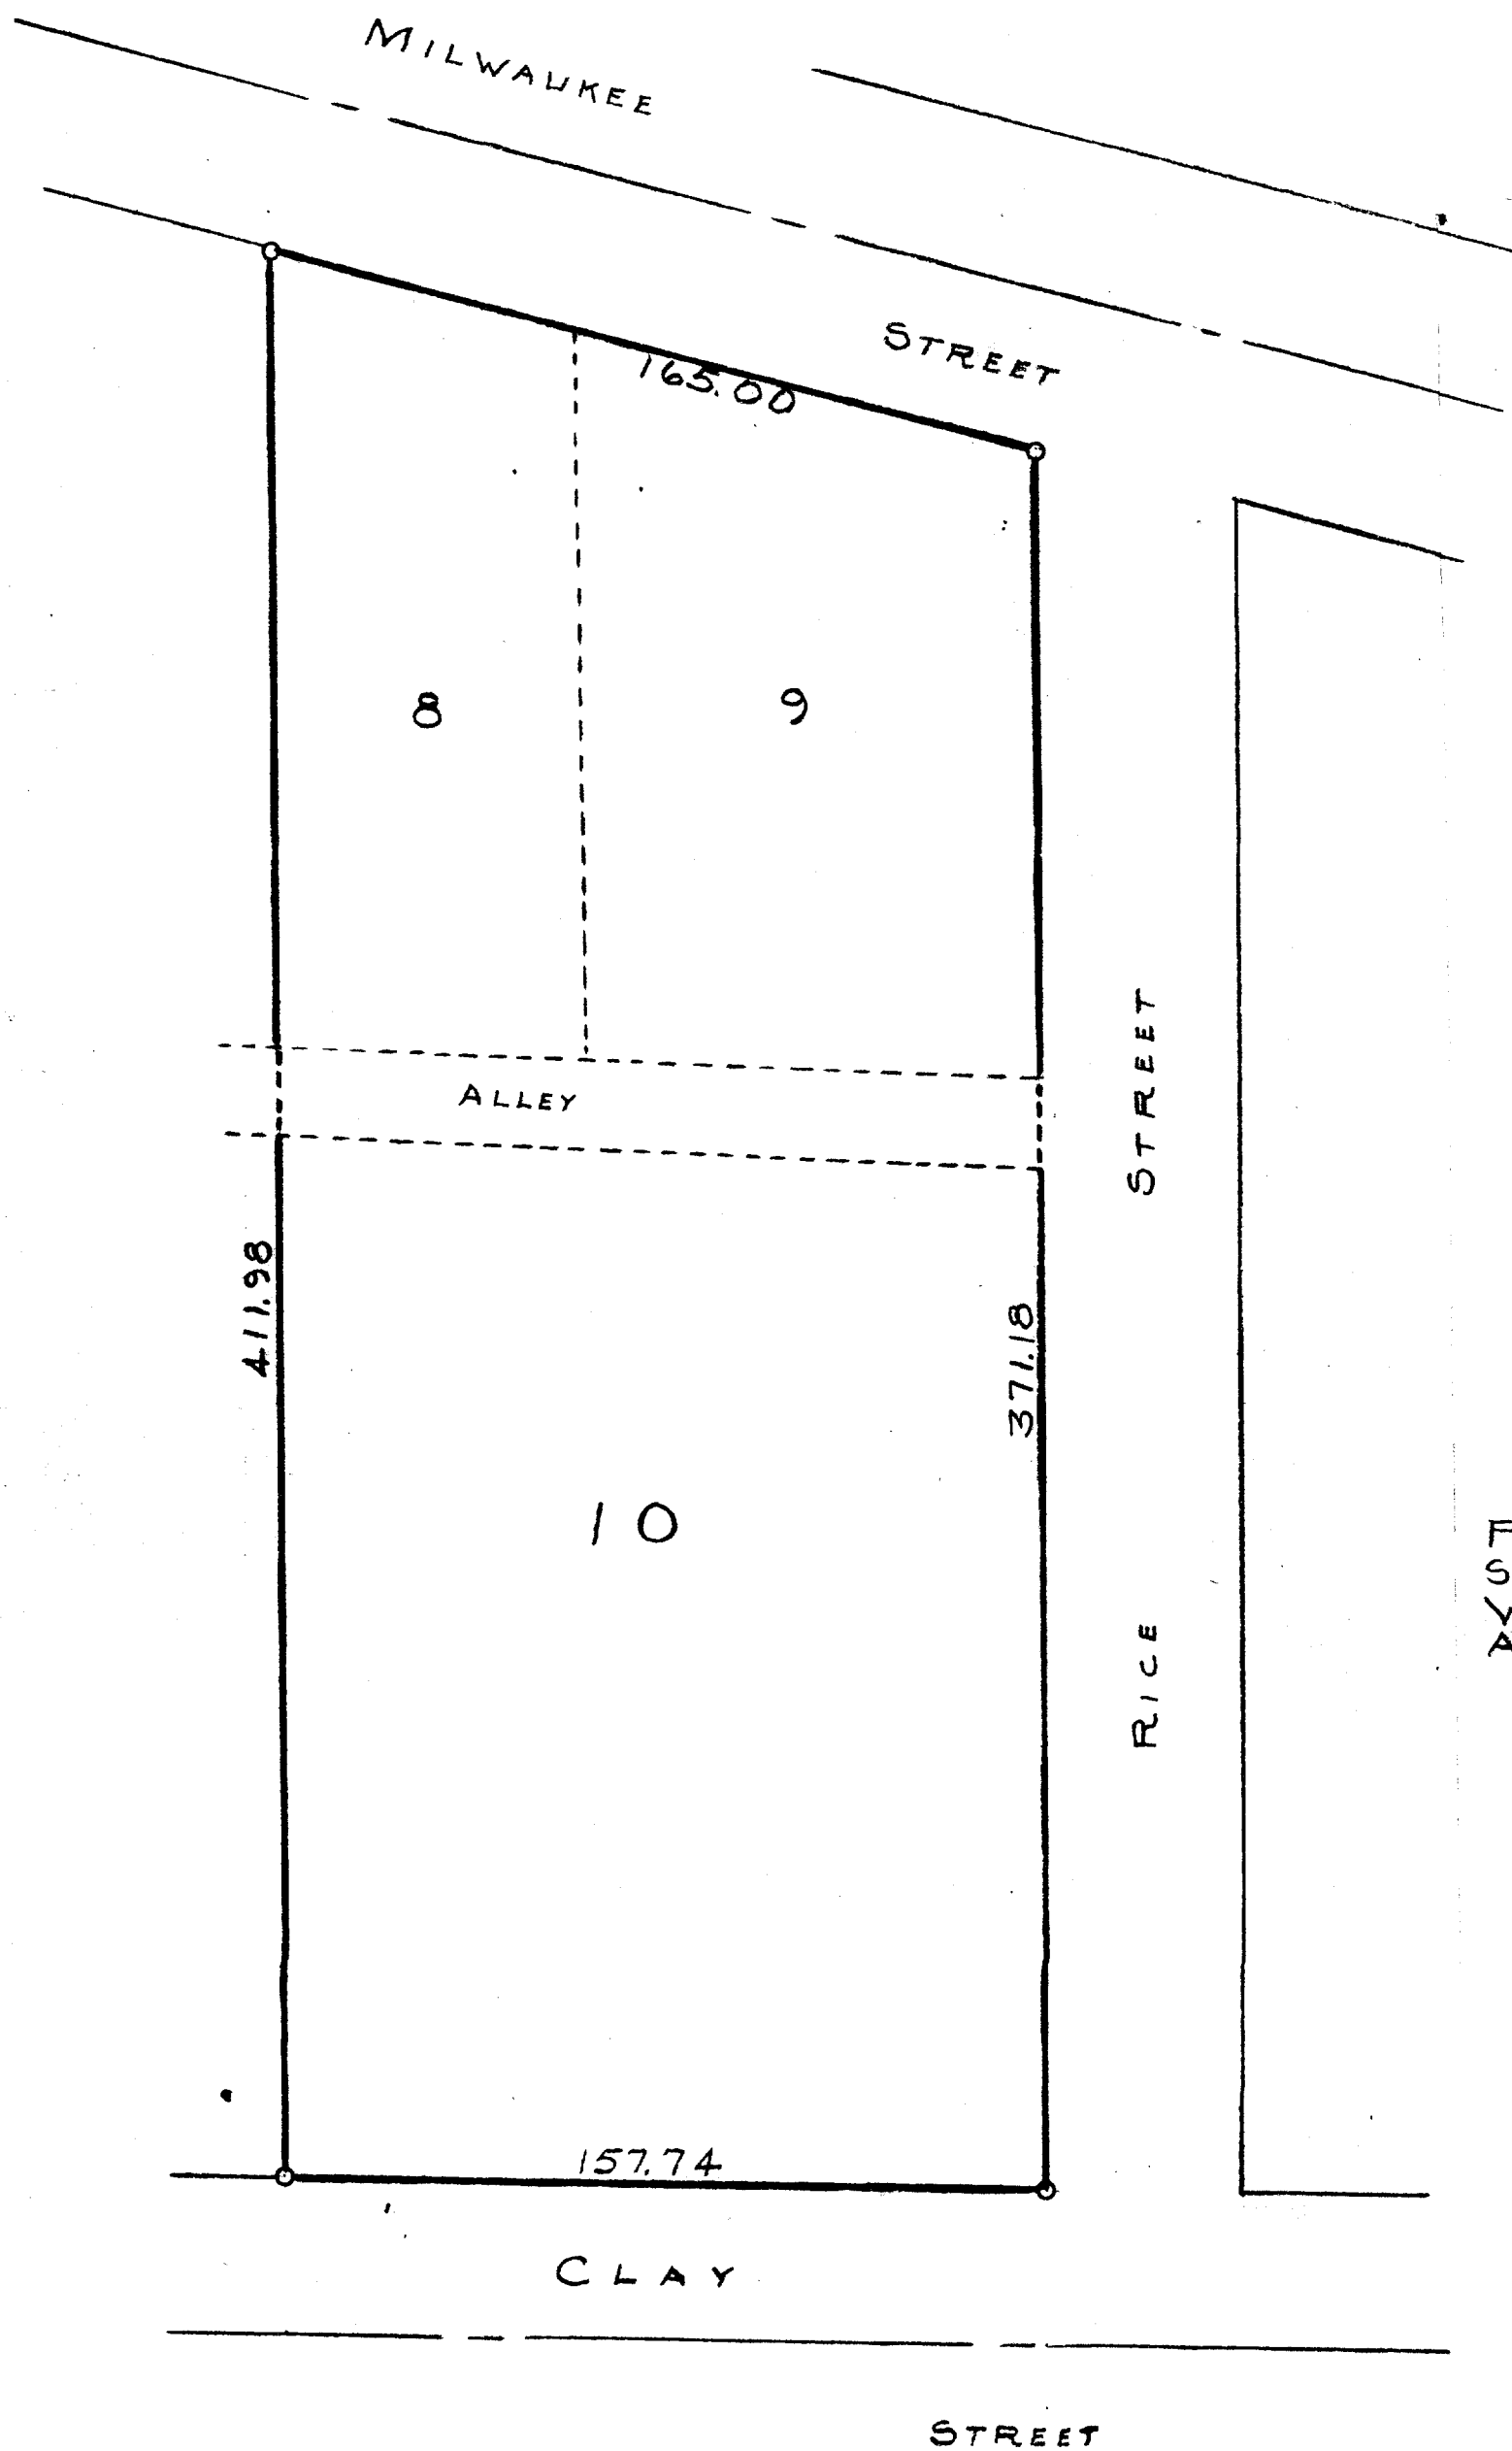

N

SCALE - 1" = 40'
O = IRON PIPE

PLAT OF SURVEY OF LOTS 8, 9, AND 10, BLOCK 8 OF
S. C. HALL'S ADDITION, CITY OF WHITEWATER,
WALWORTH COUNTY, WISCONSIN
AUGUST 1956

George T. Dunham
GEORGE T. DUNHAM,
DELAVER, WISCONSIN
WIS. LAND SURVEYOR NO 5-306

10-33

HAS 47 47A, 48