

W 1/4 COR
SEC 4, T4N
R15E

NORTH

GEORGE ST.

DETAIL 8


CONCRETE
CURB & GUTTER

STREET

- Found Chiseled "X"
- Found 1" Iron Pipe
- Found 3/4" Iron Rod
- Found 3/4" Iron Pipe
- Set 1"x3/4" Iron Pipe Weighing 1.13 #/lin. Ft.
- Set PK Nail in Concrete
- Cross Out Cross in Curb Inlet
- W & corner located from County Surveyor's ties (No Monument)

0 25 50 100

SCALE - 1" = 30'

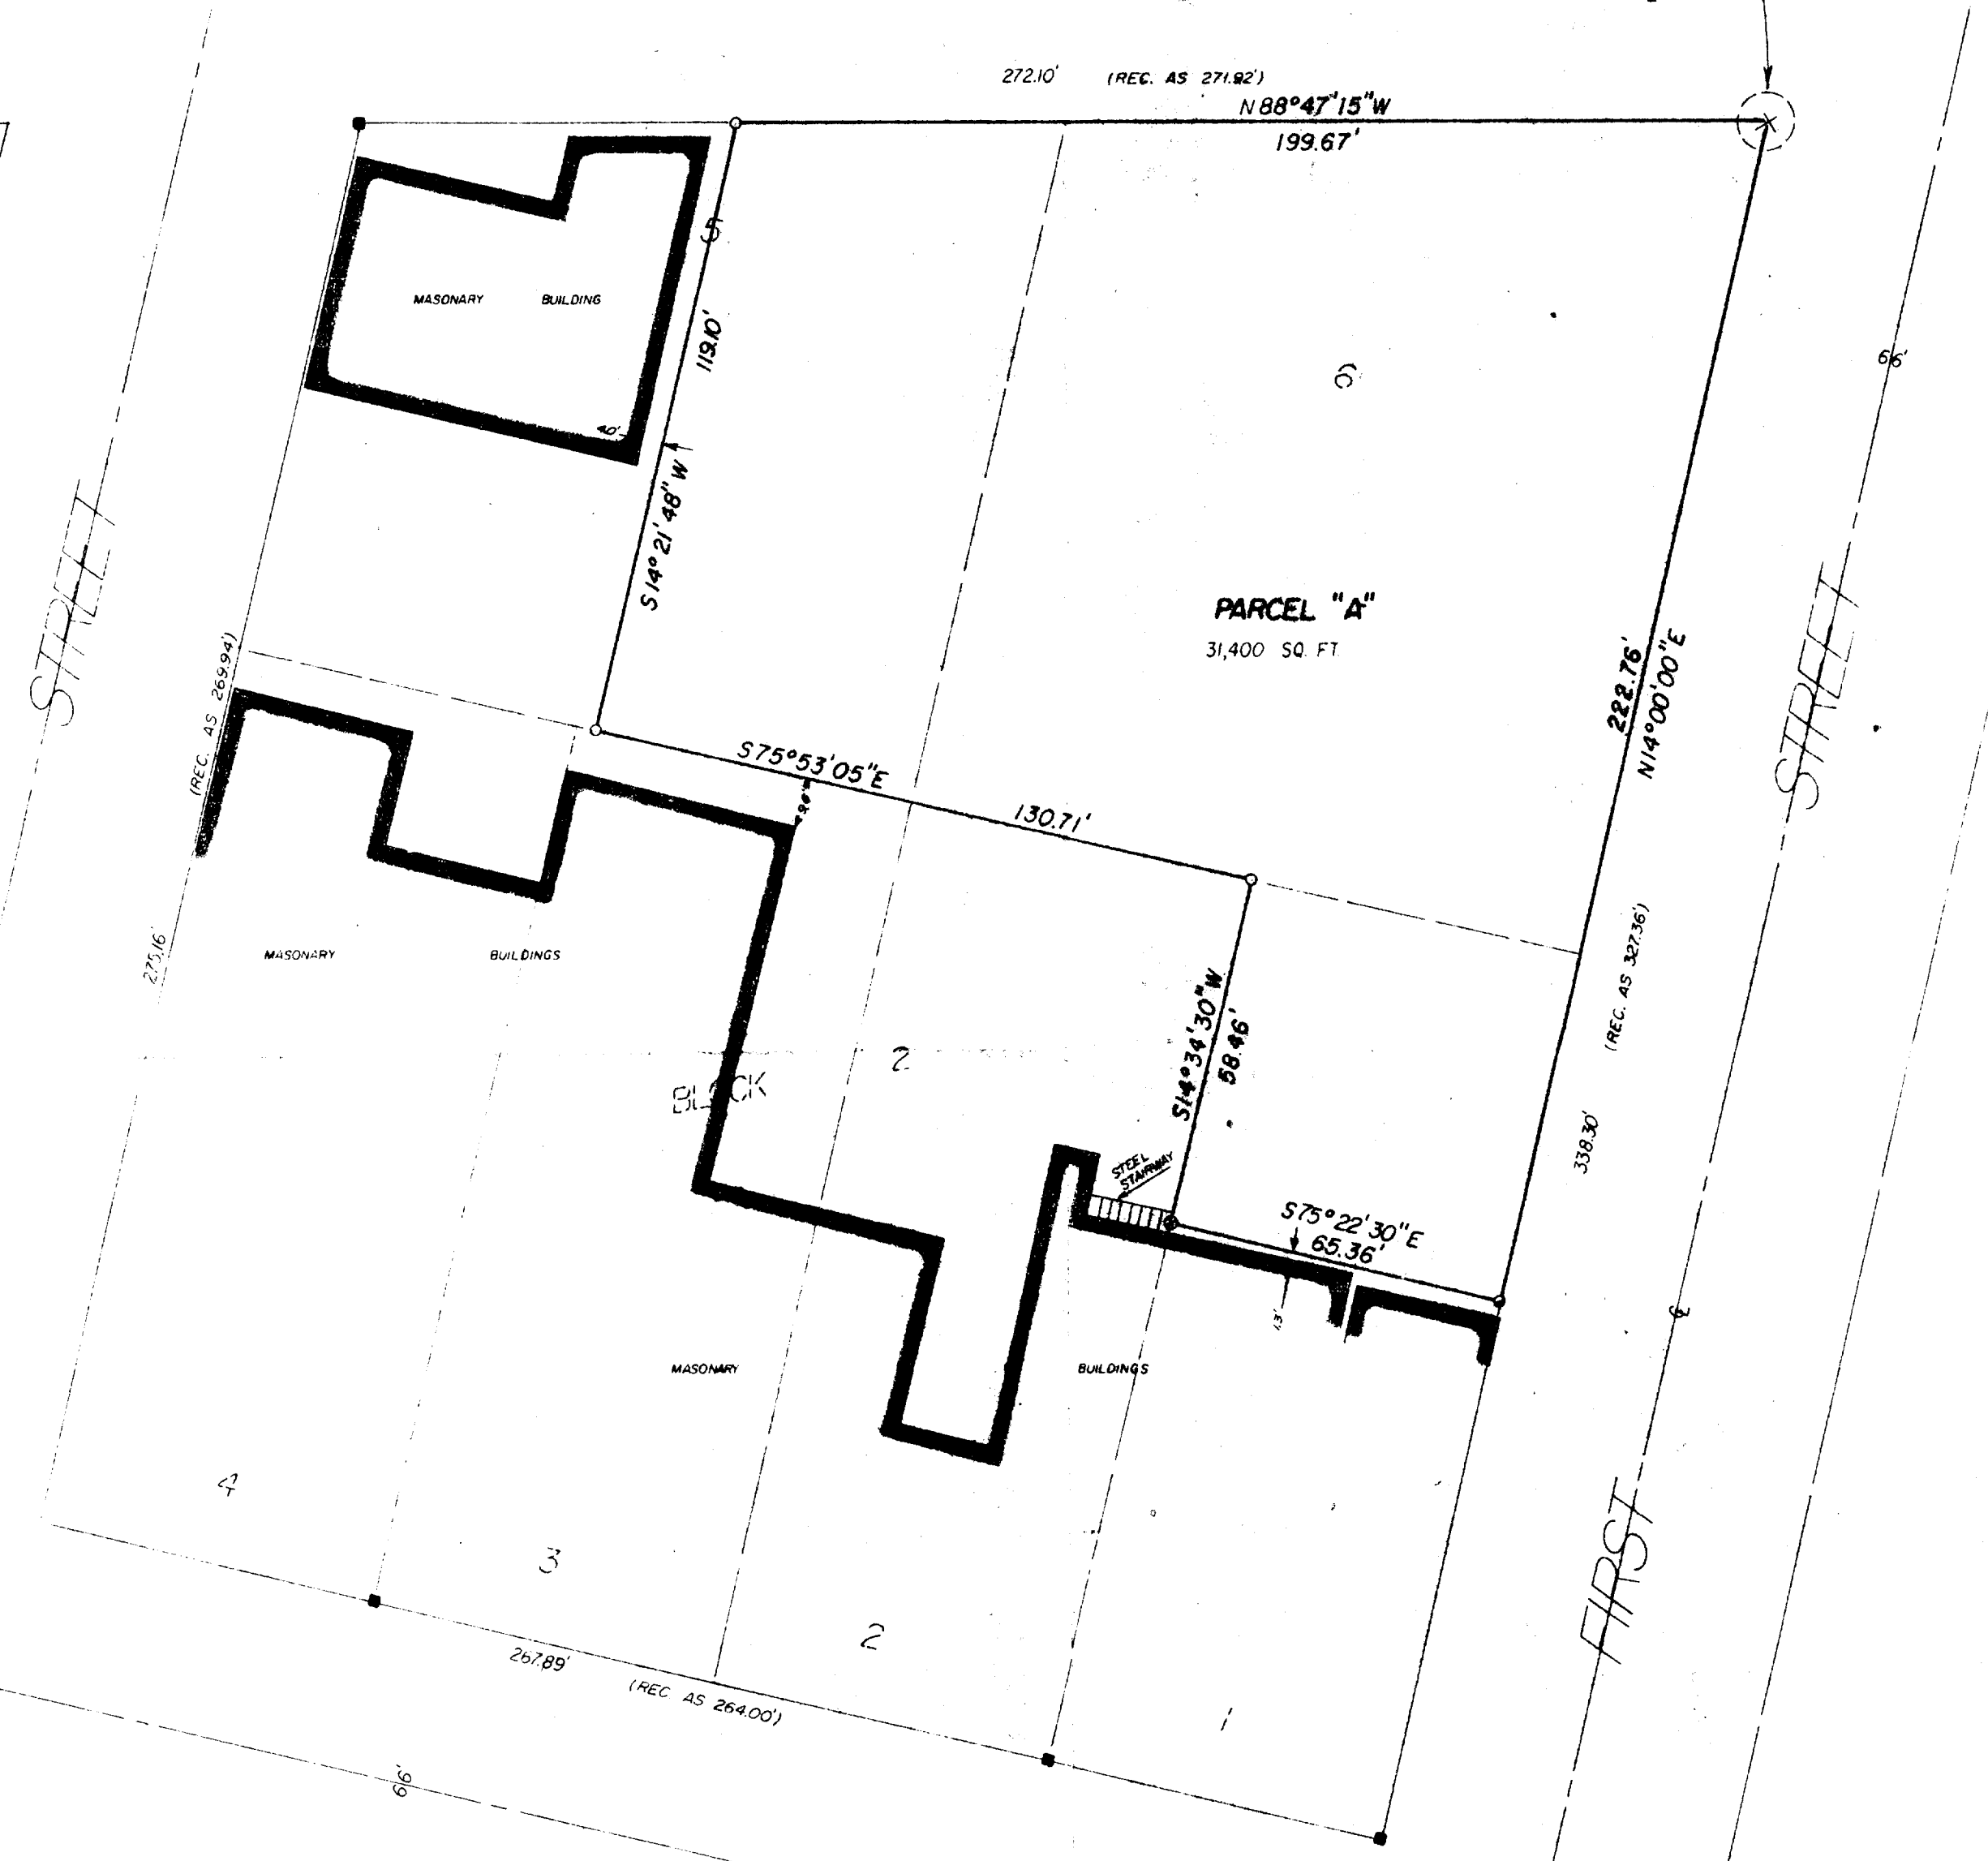

DESCRIPTION

Lot 6, the East 1/2 of Lot 5 and part of Lot 1, Block 2, ORIGINAL PLAT OF THE CITY OF WHITEWATER in the SW 1/4 of Section 4, T4N, R15E, City of Whitewater, Walworth County, Wisconsin, more particularly described as follows:


Beginning at the NE corner of said Block 2; thence N88°47'15"W, along the north line of said Block 2, 199.67 feet to a 1" iron pipe; thence S14°21'48"W, 119.10 feet to a 1" iron pipe; thence S75°53'05"E, 130.71 feet to a 1" iron pipe; thence S14°34'30"W, along the west line of said Lot 1, 58.46 feet to a PK nail; thence S75°22'30"E, 65.36 feet to a 3/4" iron pipe on the easterly line of said Block 2; thence N14°00'00"E, along said easterly line, 222.76 feet to the point of beginning, containing 31,402 sq. ft.

CERTIFICATION

I hereby certify that the property described above has been surveyed under my responsible direction and supervision and that this map is a correct representation of the lot lines and dimensions and the principle lines of the permanent structures thereon.

Date 7-15-81

James B. Woodman
Registered Land Surveyor, S-1239

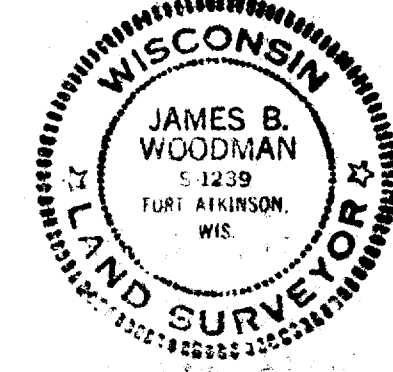

Prepared For: City of Whitewater
312 W. Whitewater
Whitewater, WI 53190

STRAND & WOODMAN ASSOCIATES
consulting engineers and land surveyors
210 Madison Avenue (414) 563-8162
Fort Atkinson, Wisconsin 53538

PLAT OF SURVEY
City of Whitewater Parking Lot

DSN.	DATE	REV.	DATE	SCALE	1"=30'
DSN.	7/15/81	REV.		JOB NO.	512-81
APP.	7/15/81	REV.		SHEET	1 OF 1