



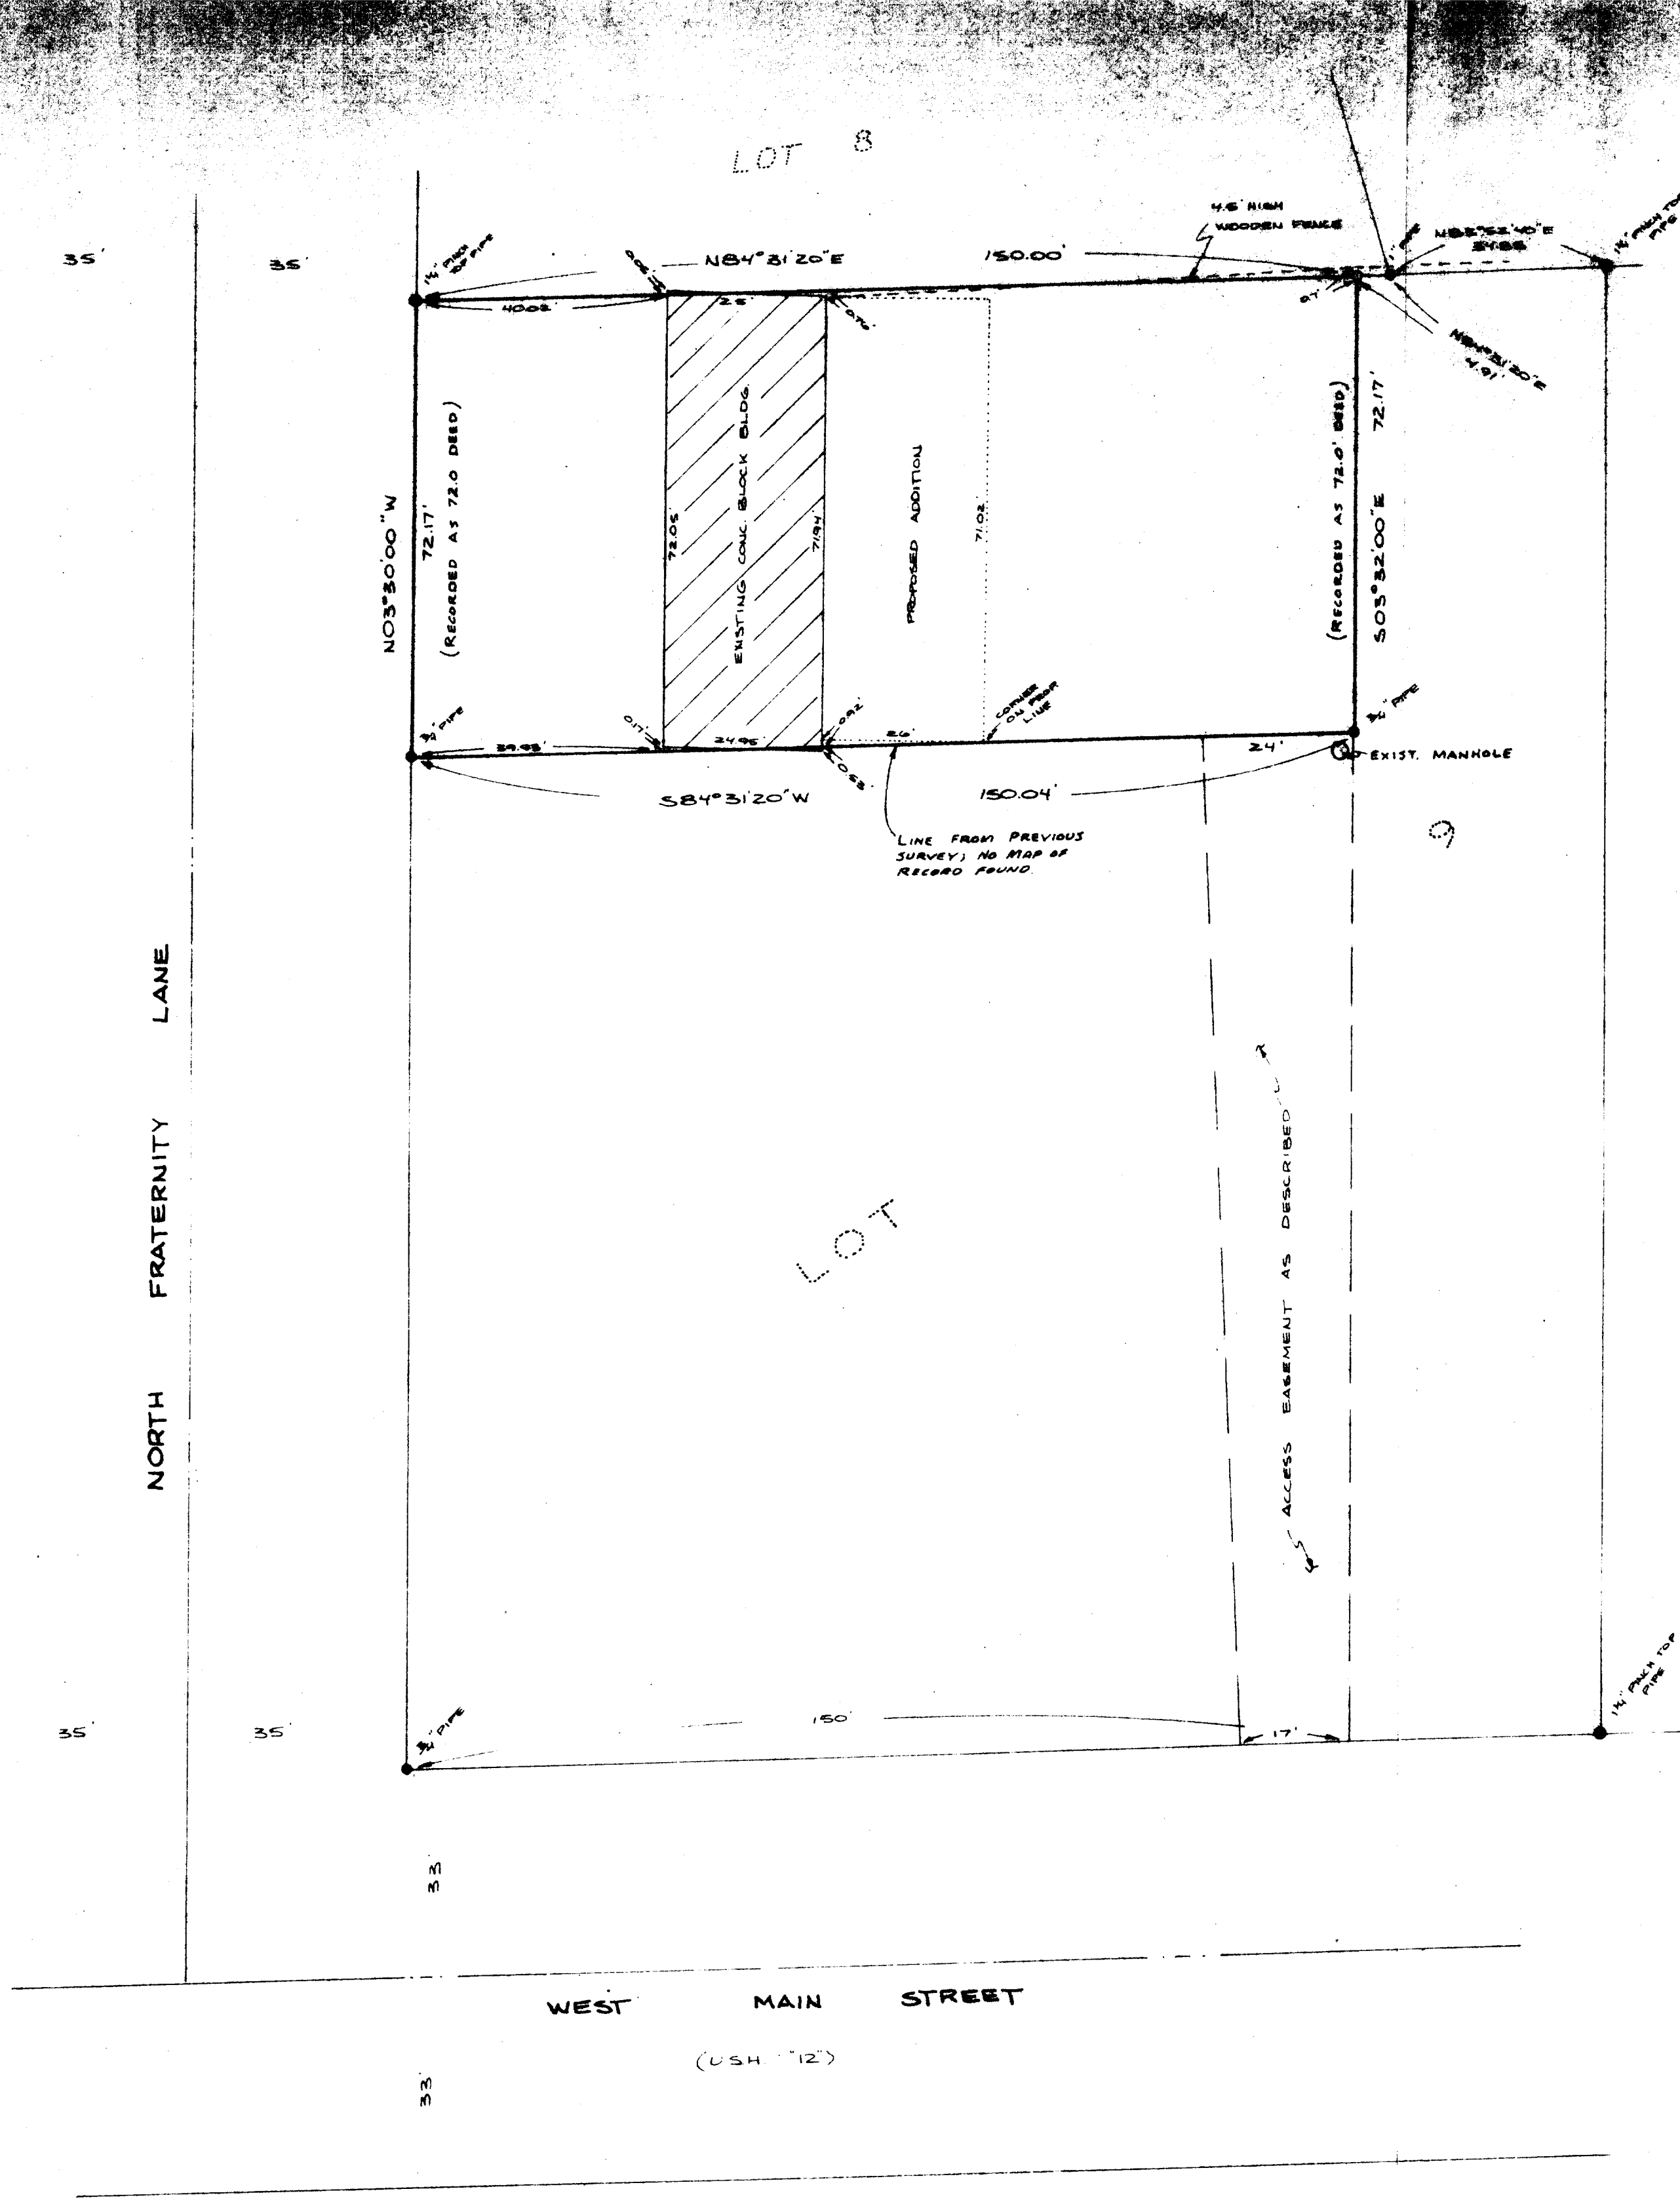

DESCRIPTION

Part of Lot Nine (9) Rose Crest Addition, being a Subdivision of the Southeast Quarter (SE $\frac{1}{4}$) of the Northwest Quarter (NW $\frac{1}{4}$) of Section Five (5), Township Four (4) North, Range Fifteen (15) East, City of Whitewater, described as follows:

Beginning at the Northwest corner of said Lot 9; thence easterly along the north line of said Lot 9 a distance of 150 feet to a point; thence south and parallel with the westerly line of said Lot 9 a distance of 72 feet to a point; thence westerly and parallel with the north line of said Lot 9 to the West line of said lot; thence northerly along the west line of said Lot 9 to the point of beginning. Also, the use of the following described premises in common with others for ingress and egress. Beginning at the Southeast corner of the above described parcel; thence in a southerly direction to a point on the south line of said Lot 9 and 150 feet east of the Southwest corner of Lot 9; thence westerly along the south line of Lot 9 a distance of 17 feet to a point; thence northerly to a point on the south line of the above described parcel and 24 feet westerly from the Southeast corner thereof; thence easterly along the south line of the above described parcel to the point of beginning; Except easements and restrictions of record. This is not homestead property.

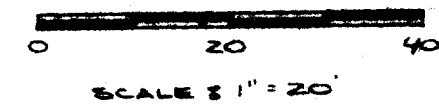

LEGEND


- 1" x 24" iron pipe set
- iron pipe found

SURVEYORS CERTIFICATE

I, Glen L. Northrop, Registered Land Surveyor, hereby certify that this survey and map was made under my direction and control and is a true representation of the field survey made on June 3, 1982.

Dated this 7th day of July, 1982 at Cambridge, Wisconsin.

Glen L. Northrop
Glen L. Northrop S 982

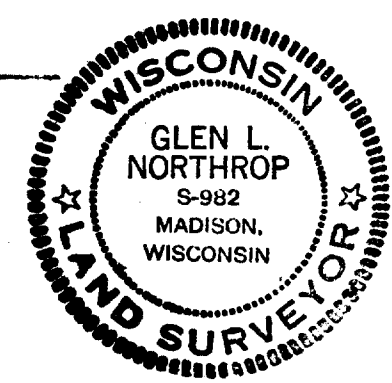

PLAT OF SURVEY

Part of Lot 9, Rose Crest Addition to the City of Whitewater, Walworth County, Wisconsin.

Surveyed for: Mr. David Wadman, OWNER
1109 CASWELL ST., FORT ATKINSON, WI.
Surveyed by: Apex Survey, Ltd.
Box 369, Cambridge, WI

Field survey on: 6/3/82 by: G. Northrop D. Riesop Drawn: 7/2/82 D. Riesop Printed:	Order No. AB 853-82 Dwg. No. 853 Sheet 1 of 1
--	---

Parcel, RC-9A

C.S. COPY

10-331N