

DESCRIPTION OF PROPERTY SURVEYED

Part of the E 1/2 of the SE 1/4 of Sec. 5, T 4 N, R 15 E, and bounded as follows, commencing on the W. line of Prairie St. at a point 15 rods S. of the N. line of said 1/2, and running thence W. and parallel with the N. line of said 1/2, 10 rods, and 7 lks. thence S. and parallel with the E. line of Cottage Street, 5 rds. to N. line of Lot 11 Block 17 Chapman and Ludington's Addition to Village of Whitewater, thence E. on said N. line of Lot 11, 1 rd. and 7 lks. thence S. on Shedd's E. line 1 rd. to Converse's N. line, thence E. on Converse's N. line to W. line of Prairie Street, thence N. on W. line of Prairie Street to place of beginning, Also Lot 11, Block 17 except South 3 feet of Chapman and Ludington's addition to the City of Whitewater.

LEGEND

- ✕ CROSS CHIELED IN CONC. EXIST.
- Existing iron stake found.
- 1" I.D. x 24" iron pipe set except where noted different on drg.
- Existing property line or street line.
- Existing recorded plat lot line.
- Previous property line and/or previous surveyed line.
- Existing wire fence.


METRIC CONVERSION:
TO CHANGE TO METERS,
MULTIPLY FEET X .3048

SURVEYOR'S CERTIFICATE

I, Glen L. Northrop, hereby certify that a field survey of the lands described and mapped hereon was made by me in March, 1984 and that this map is a true representation of said field survey made and is correct to the best of my knowledge and belief.

Dated this 22 day of May 1984.

Glen L. Northrop S-982

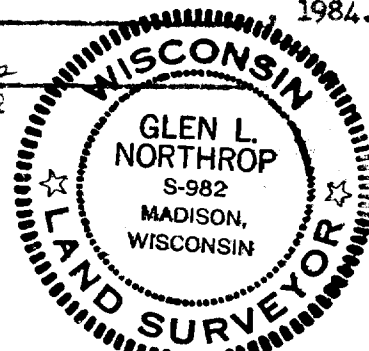

PLAT OF SURVEY

OF PROPERTY AT PRAIRIE STREET, WHITEWATER, WISCONSIN
PART OF NE 1/4 OF SEC. 5, T 4 N, R 15 E, AND LOT 11,
BLOCK 17, CHAPMAN AND LUDINGTON'S ADDITION TO WHITEWATER.
ALL IN CITY OF WHITEWATER, WALWORTH COUNTY, WISCONSIN.

Surveyed for: Allen Heth, owner of Route 1, Whitewater, WI

Surveyed by: Abex Survey Ltd. Box 369, Cambridge, WI
Tel. 608/423-3331


Field survey completed on: 5/19/84
Drafted by: G. Northrop
Print issue date: 6/13/84

DRG. NO. 976

SHEET 1 OF 1

COTTAGE STREET

PRAIRIE STREET

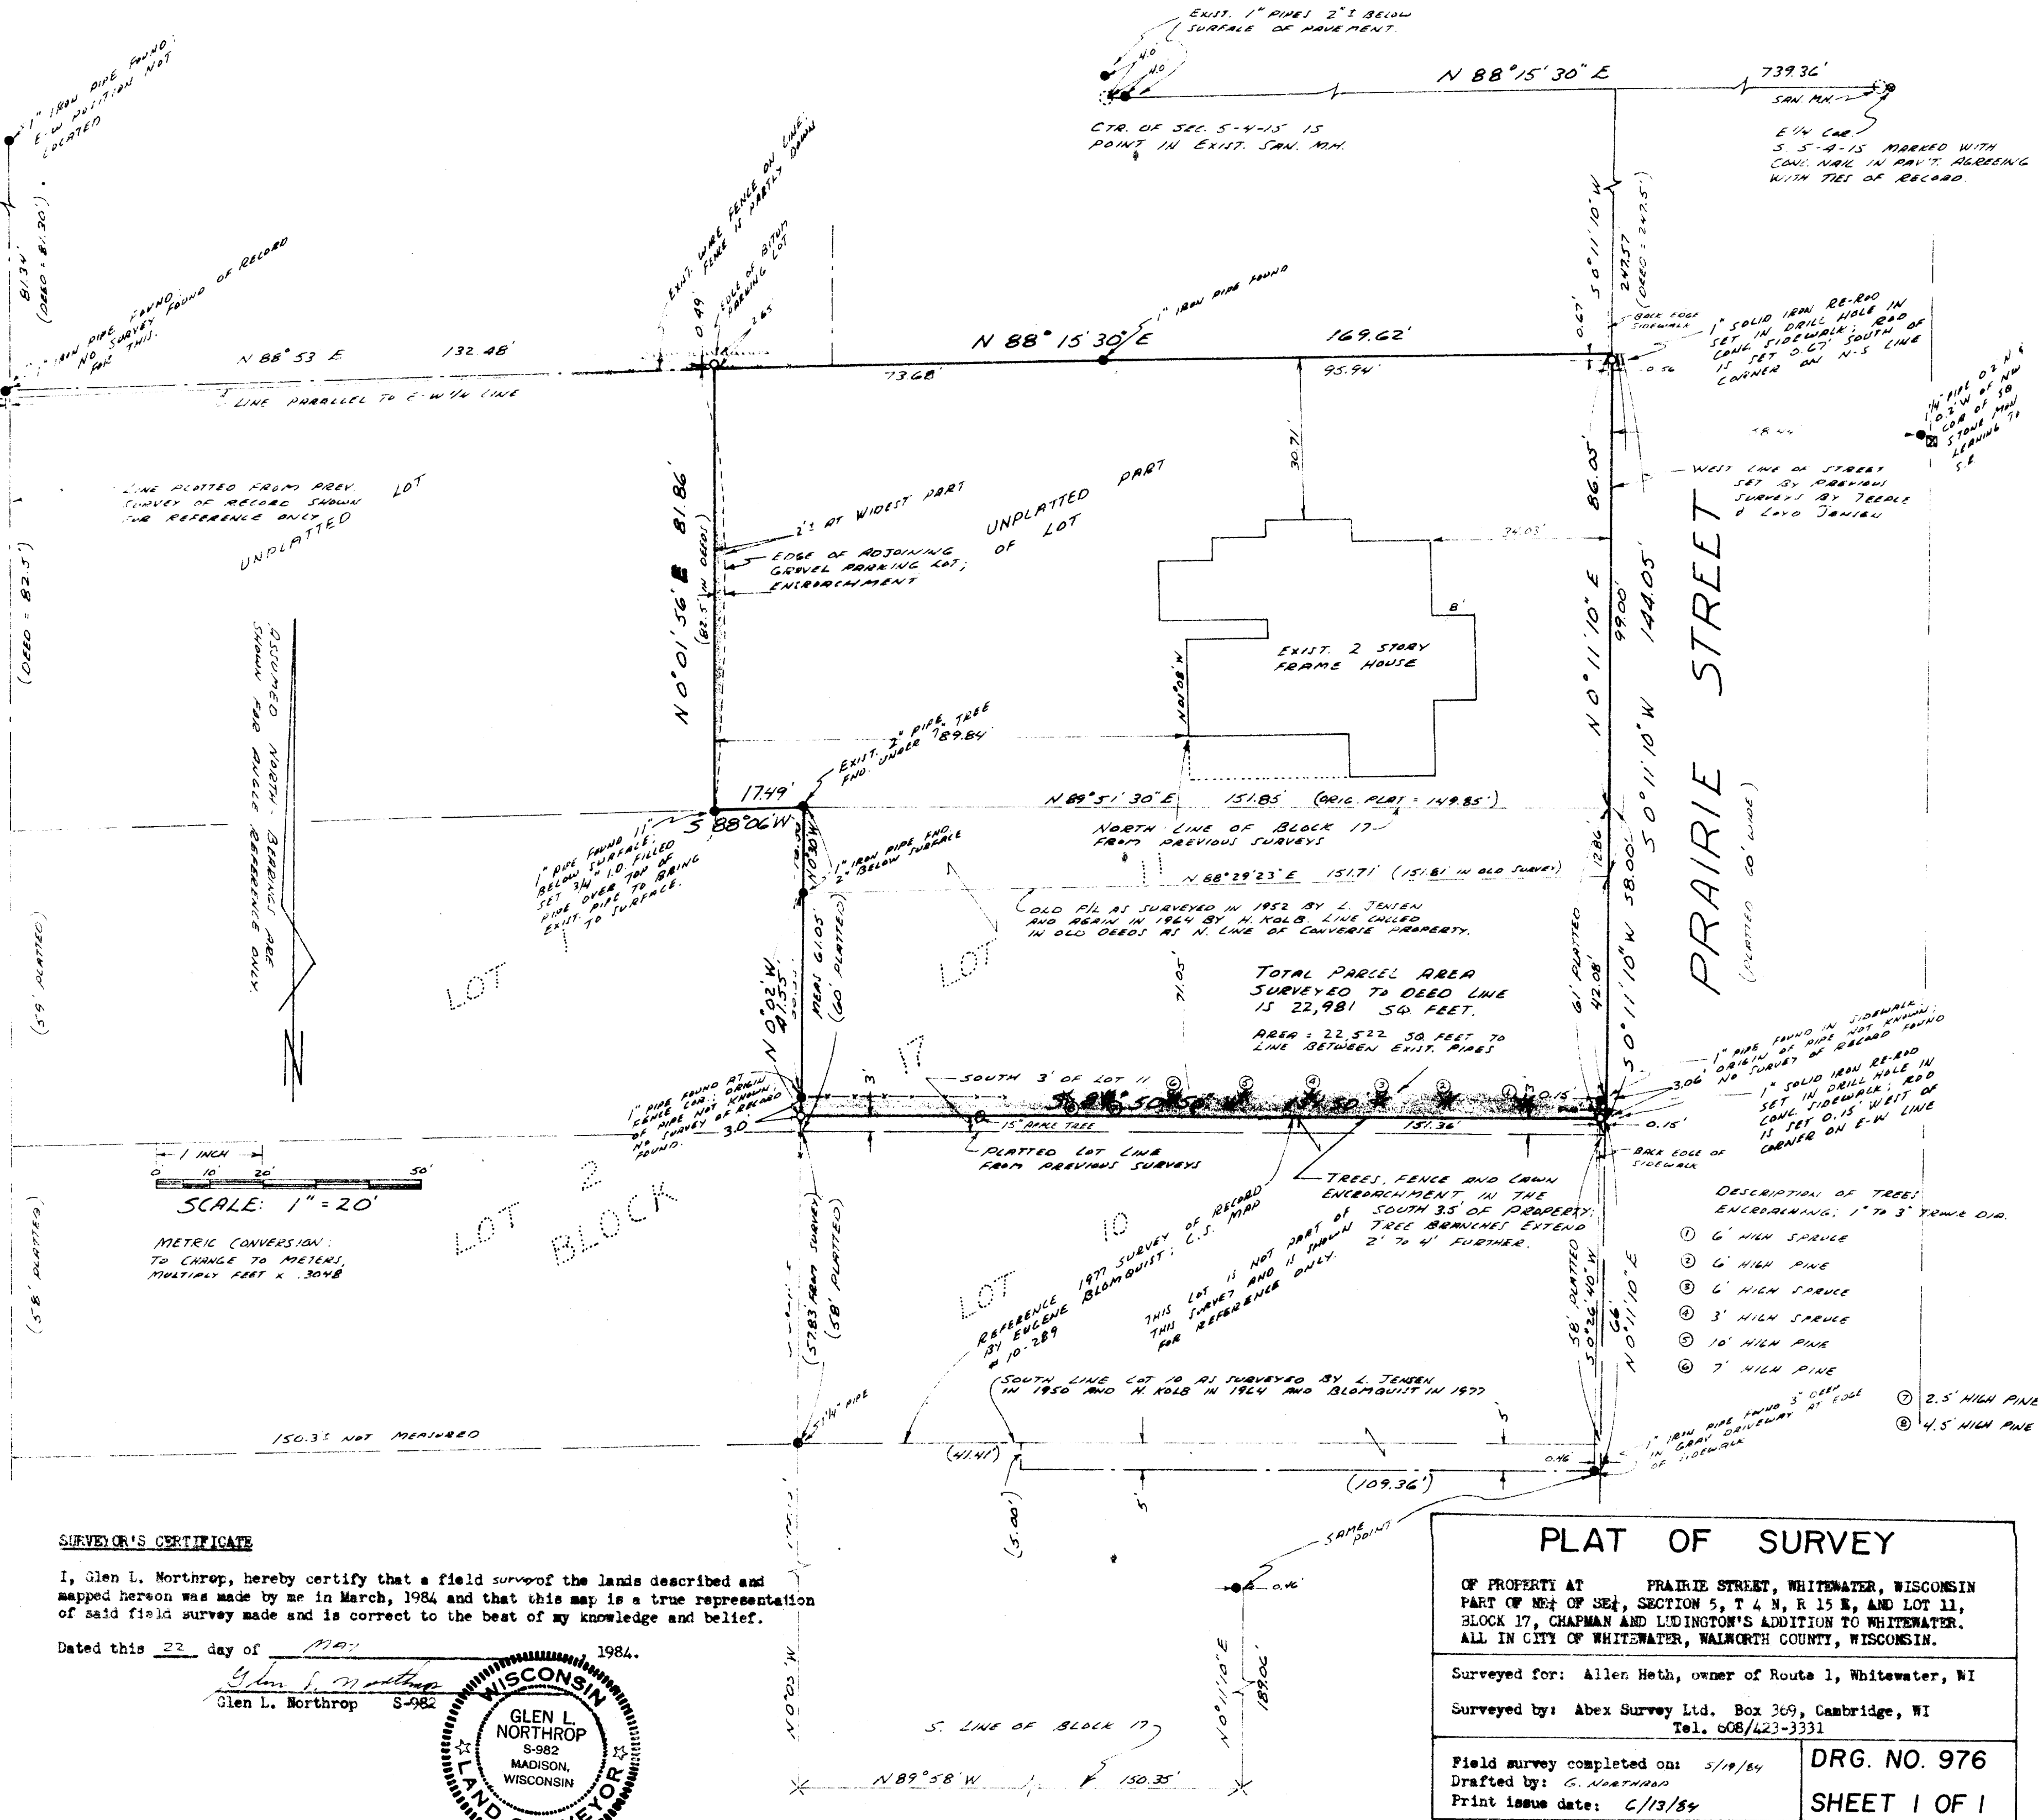

DESCRIPTION OF PROPERTY SURVEYED

Part of the E 1/2 of the SE 1/4 of Sec. 5, T 4 N, R 15 E, and bounded as follows, commencing on the W. line of Prairie St. at a point 15 rods S. of the N. line of said 1/4, and running thence W. and parallel with the N. line of said 1/4, 10 rods, and 7 lks. thence S. and parallel with the E. line of Cottage Street, 5 rds. to N. line of Lot 11 Block 17 Chapman and Ludington's Addition to Village of Whitewater, thence E. on said N. line of Lot 11, 1 rd. and 7 lks. thence S. on Shedd's E. line 1 rd. to Converse N. line, thence E. on Converse N. line to W. line of Prairie Street, thence N. on W. line of Prairie Street to place of beginning, Also Lot 11, Block 17 except South 3 feet of Chapman and Ludington's addition to the City of Whitewater.

LEGEND

- ✕ CROSS CHISELED IN CONC. EXIST.
- Existing iron stake found.
- 1" I.D. x 24" iron pipe set except where noted different on drg.
- Existing property line or street line.
- Existing recorded plat lot line.
- Previous property line and/or previous surveyed line.
- Existing wire fence.

() Numbers shown in parenthesis are recorded from deeds or previous surveys of record.




SURVEYOR'S CERTIFICATE

I, Glen L. Northrop, hereby certify that a field survey of the lands described and mapped hereon was made by me in March, 1984 and that this map is a true representation of said field survey made and is correct to the best of my knowledge and belief.

Dated this 22 day of May, 1984.

Glen L. Northrop
Glen L. Northrop S-982

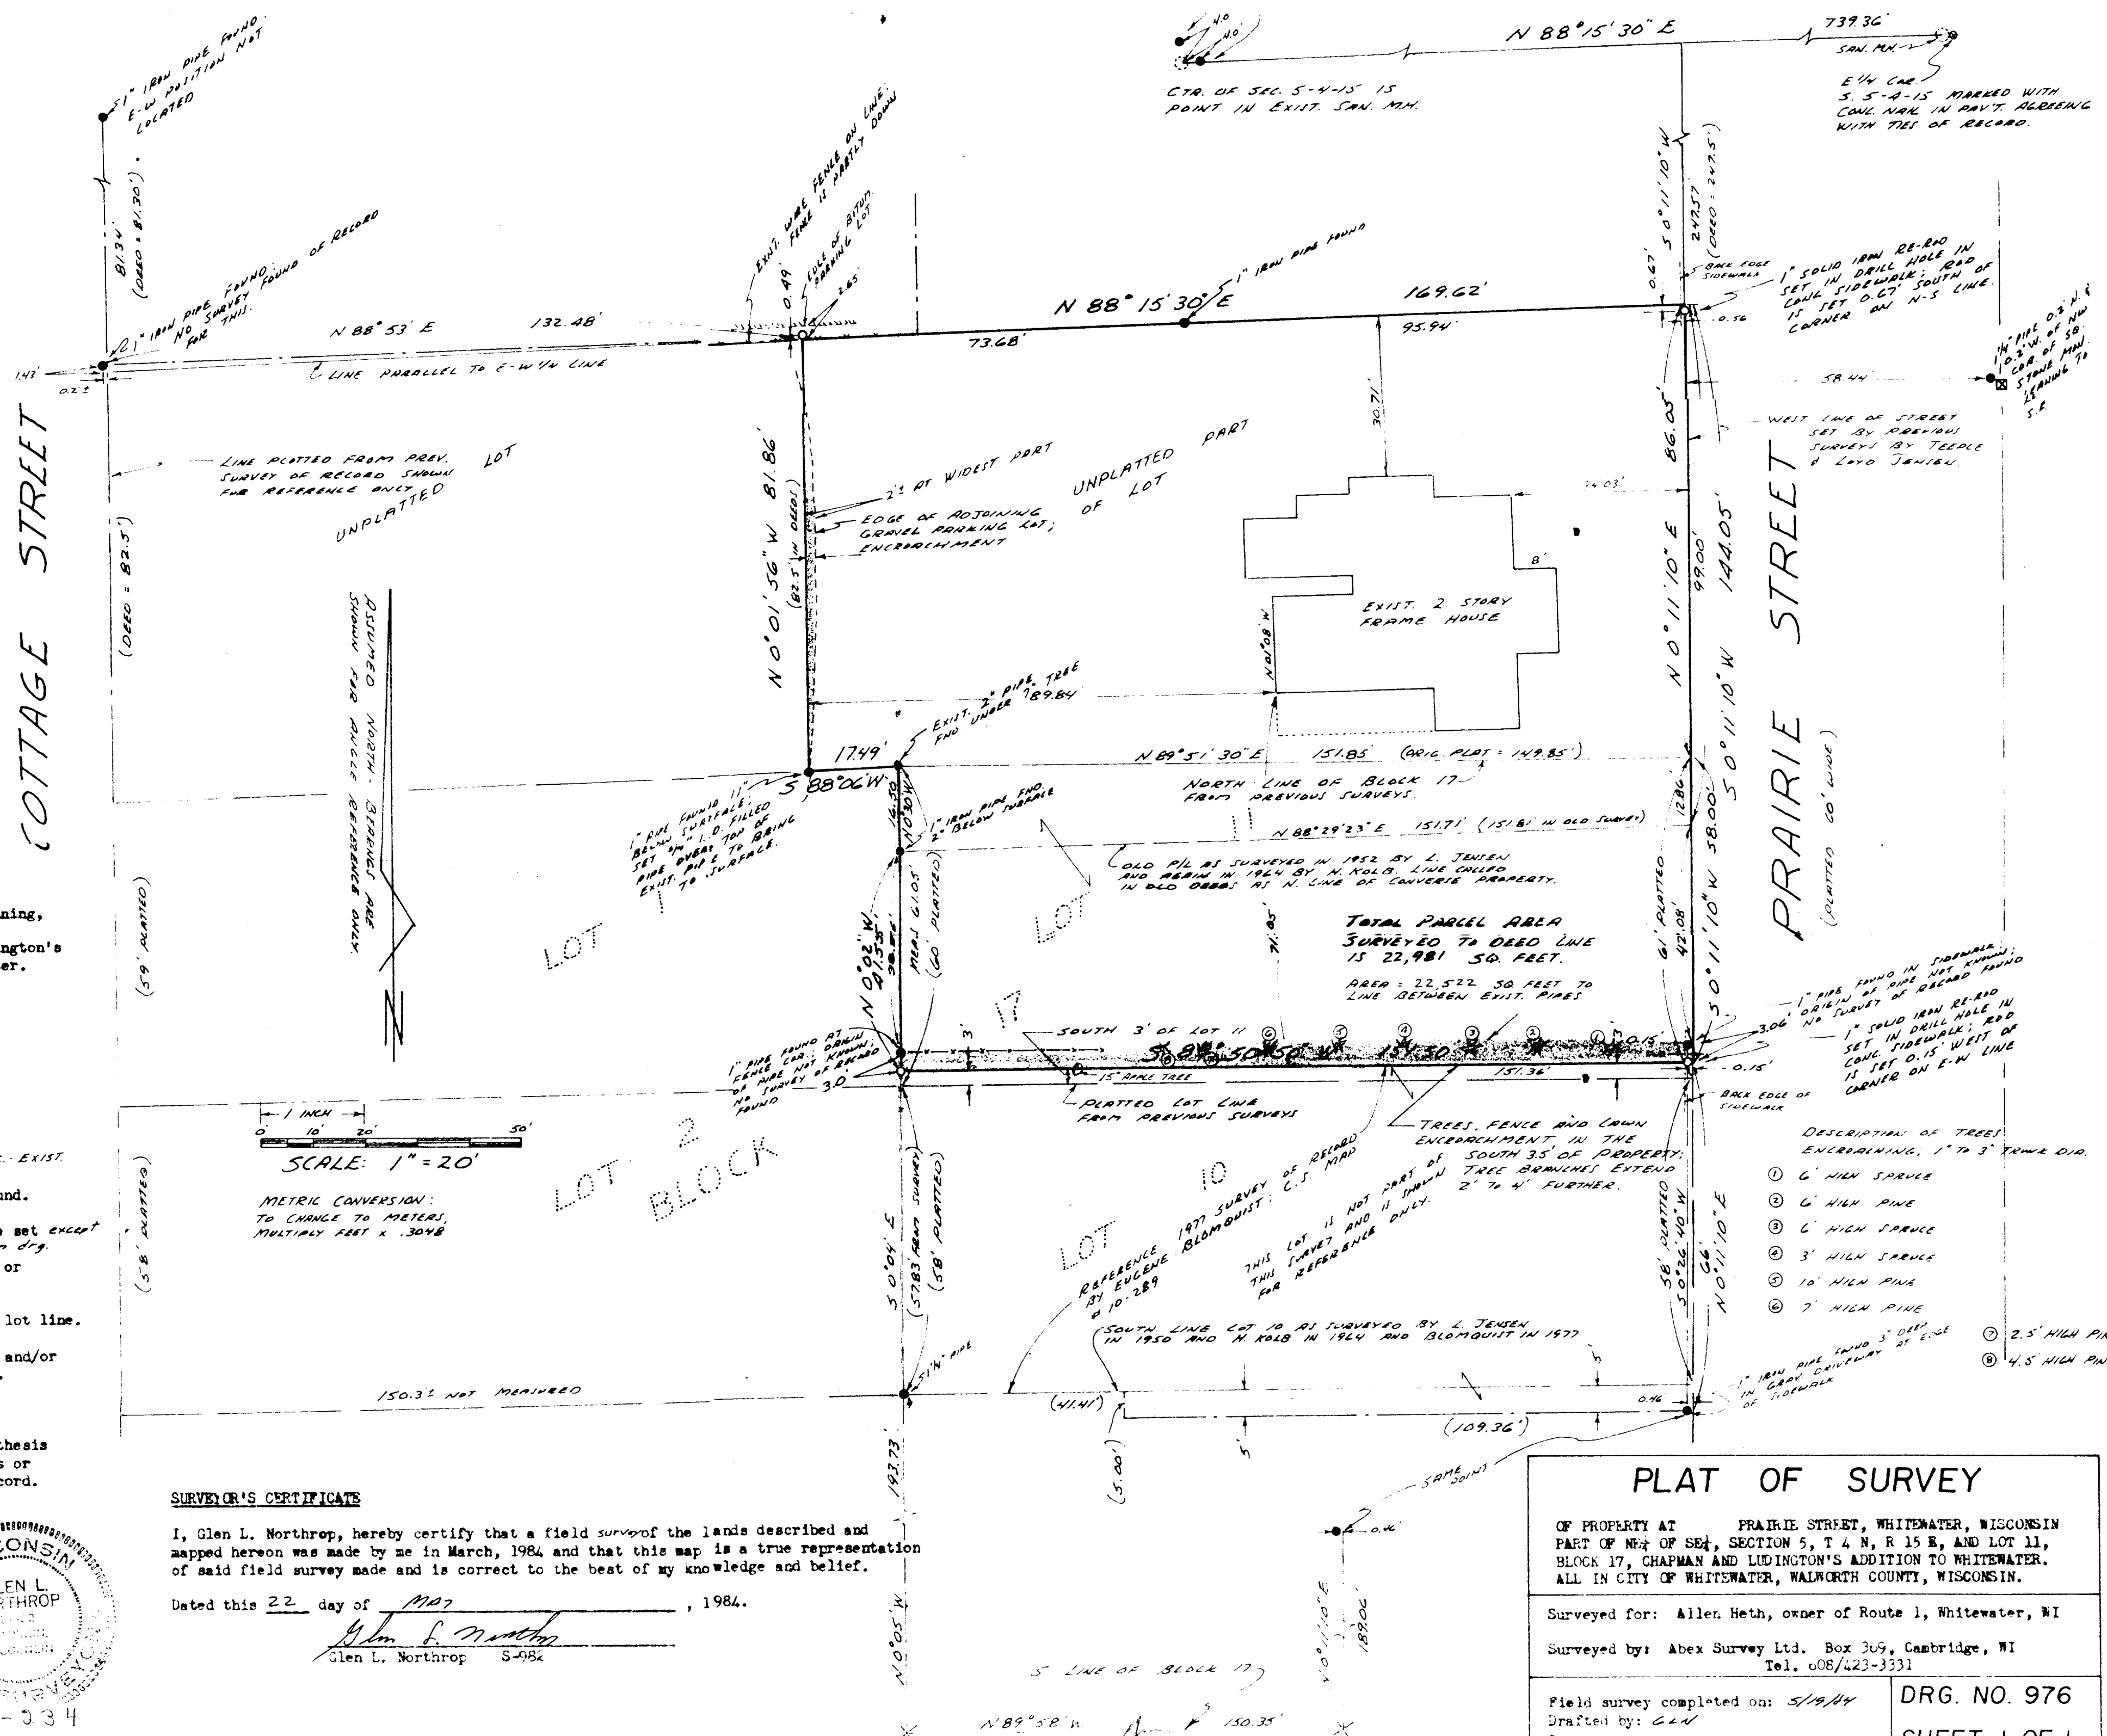

PLAT OF SURVEY

OF PROPERTY AT PRAIRIE STREET, WHITEWATER, WISCONSIN
PART OF NE 1/4 OF SEC. 5, T 4 N, R 15 E, AND LOT 11,
BLOCK 17, CHAPMAN AND LUDINGTON'S ADDITION TO WHITEWATER.
ALL IN CITY OF WHITEWATER, WALWORTH COUNTY, WISCONSIN.

Surveyed for: Allen Heth, owner of Route 1, Whitewater, WI

Surveyed by: Abex Survey Ltd. Box 309, Cambridge, WI
Tel. 608/423-3331

Field survey completed on: 5/19/84
Drafted by: G.L.N.
Print issue date: 5/22/84

DRG. NO. 976
SHEET 1 OF 1