


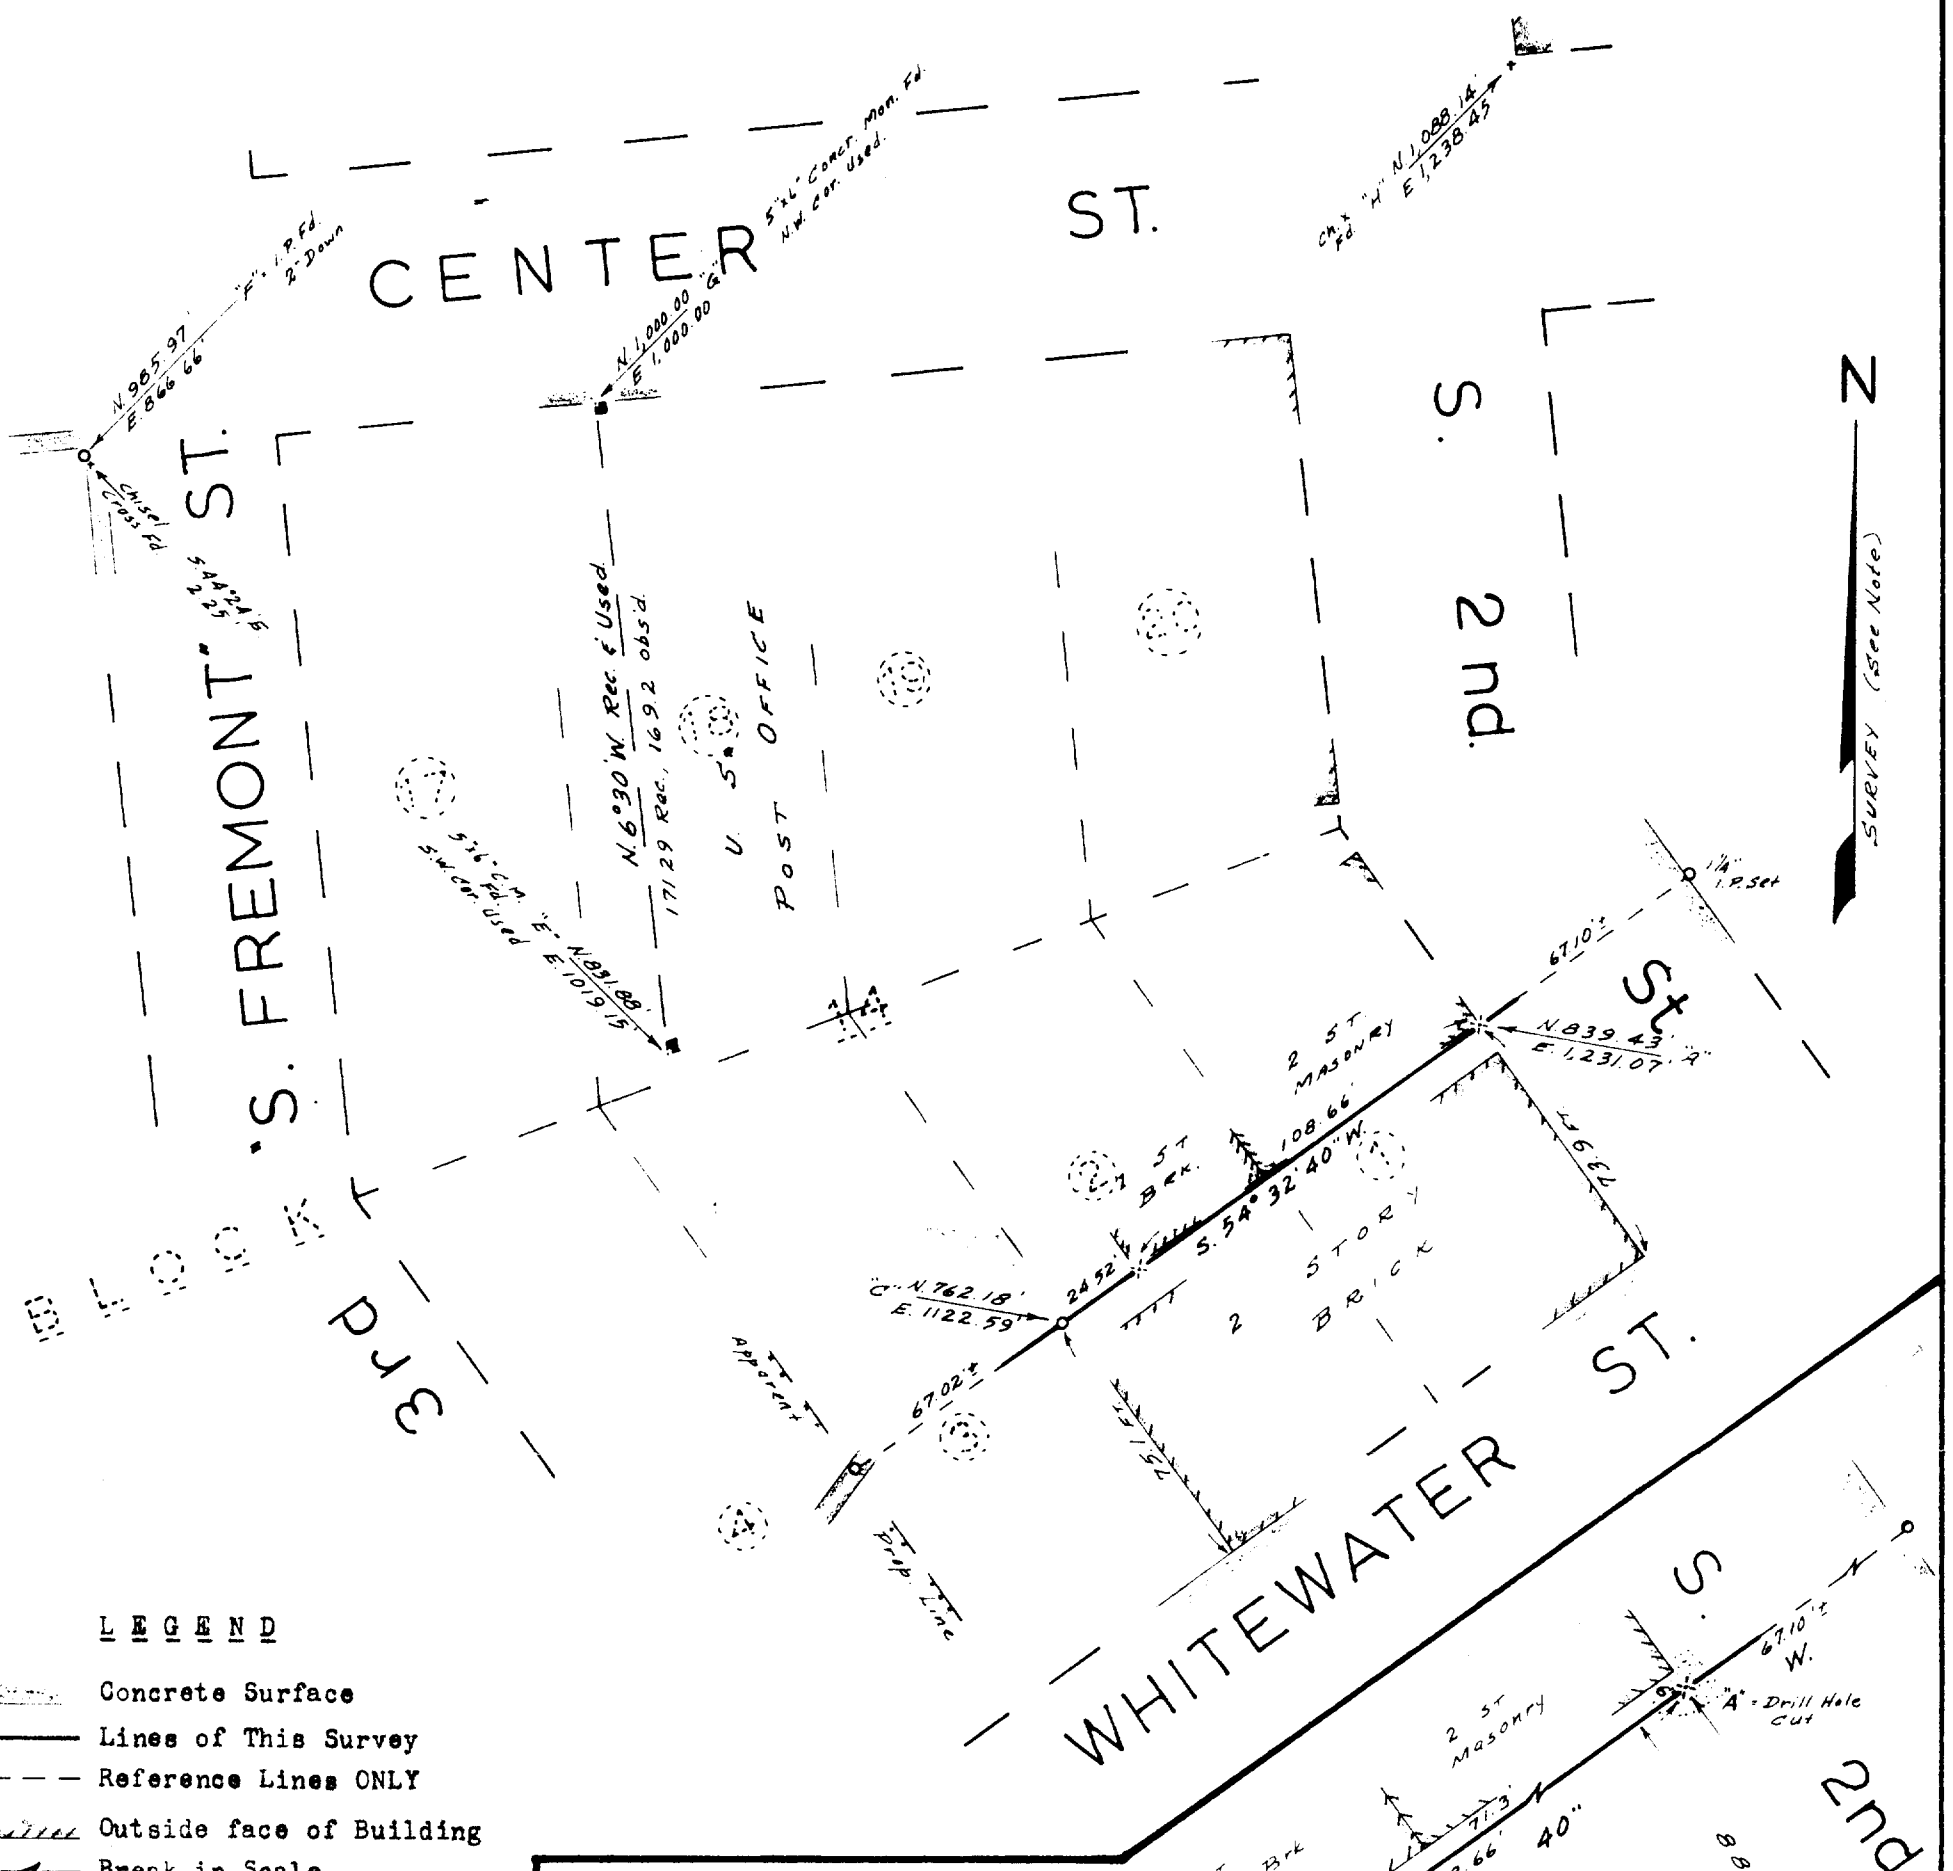

LEGEND

- Concrete Surface
- Lines of This Survey
- Reference Lines ONLY
- Outside face of Building
- Break in Scale


NOTES

1. SCOPE OF SURVEY: To establish (heavy) dividing line ONLY. All other (broken) lines and figures are for reference ONLY.
2. PRECISION: 1/10,000
3. COORDINATES: Arbitrary, plane, rectangular.
4. ORIENTATION & BASIS OF BEARINGS: N.6°30'W. on apparent W. line of Post Office parcel.
5. REFERENCES: Plat of "Whitewater Village as Resurveyed", Vol. 3, Pg. 21.
6. ENCROACHMENTS: None appear across dividing line except as shown.
7. CERTIFICATE: I, Richard R. Mayer, a registered surveyor in the State of Wisconsin, hereby certify that I have executed the survey as shown hereon.

Richard R. Mayer

DETAIL of DIVIDING LINE

Scale: 1" to 5'

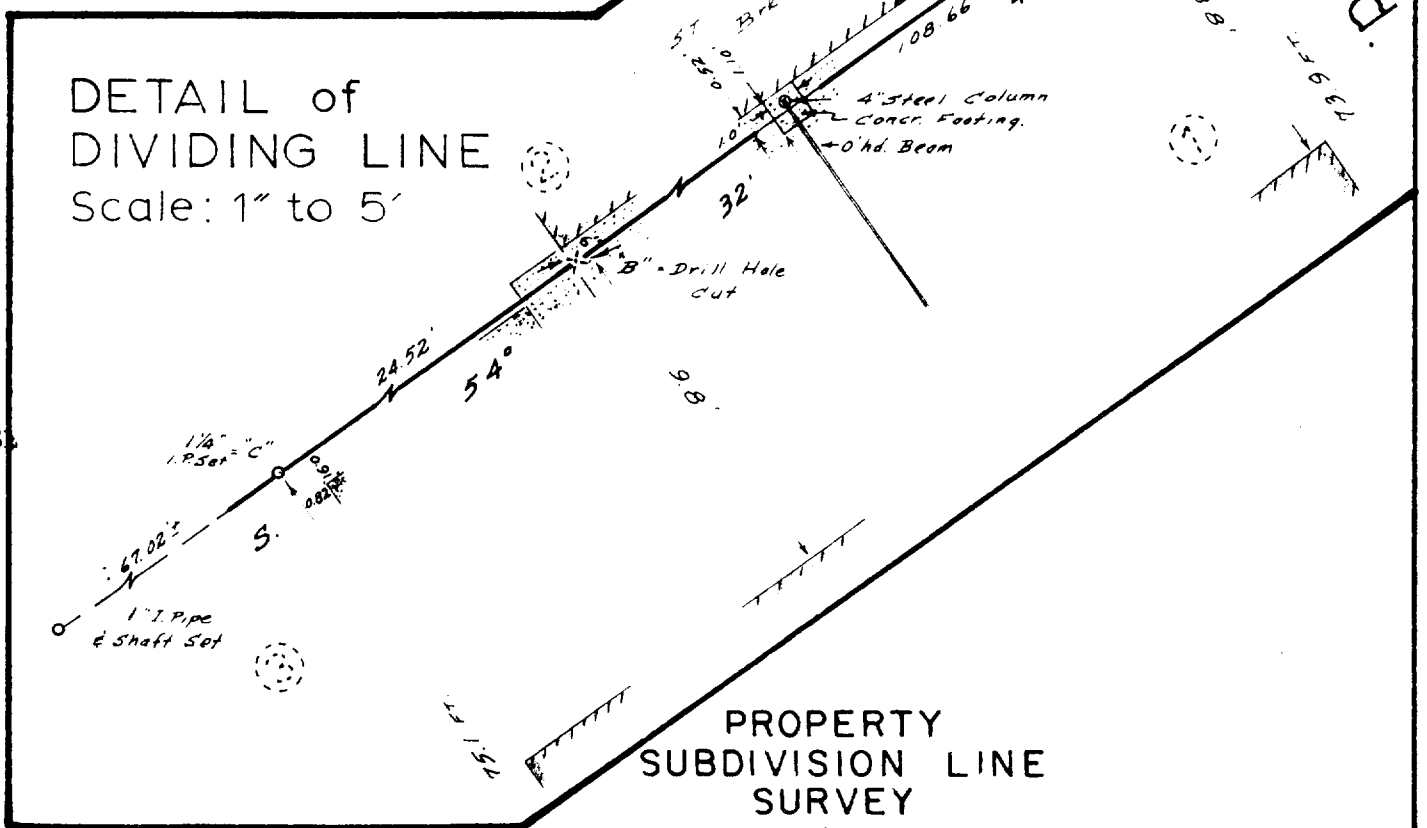

PROPERTY SUBDIVISION LINE SURVEY

IN
LOTS 1, 2, & 3, BLOCK 14
CITY OF WHITEWATER, WALWORTH COUNTY, WIS.

FOR
WEILER and COMPANY

AUGUST 24, 1964

SCALE: 1 IN. to 50 FT.

RICHARD R. MAYER
SURVEYOR
FORT ATKINSON, WISCONSIN

64-29-11

Line between OT-144 & OT-145

10-343