


DESCRIPTION OF SURVEY

Lots 7 and 8, Block 7, Tripps Addition,
City of Whitewater.

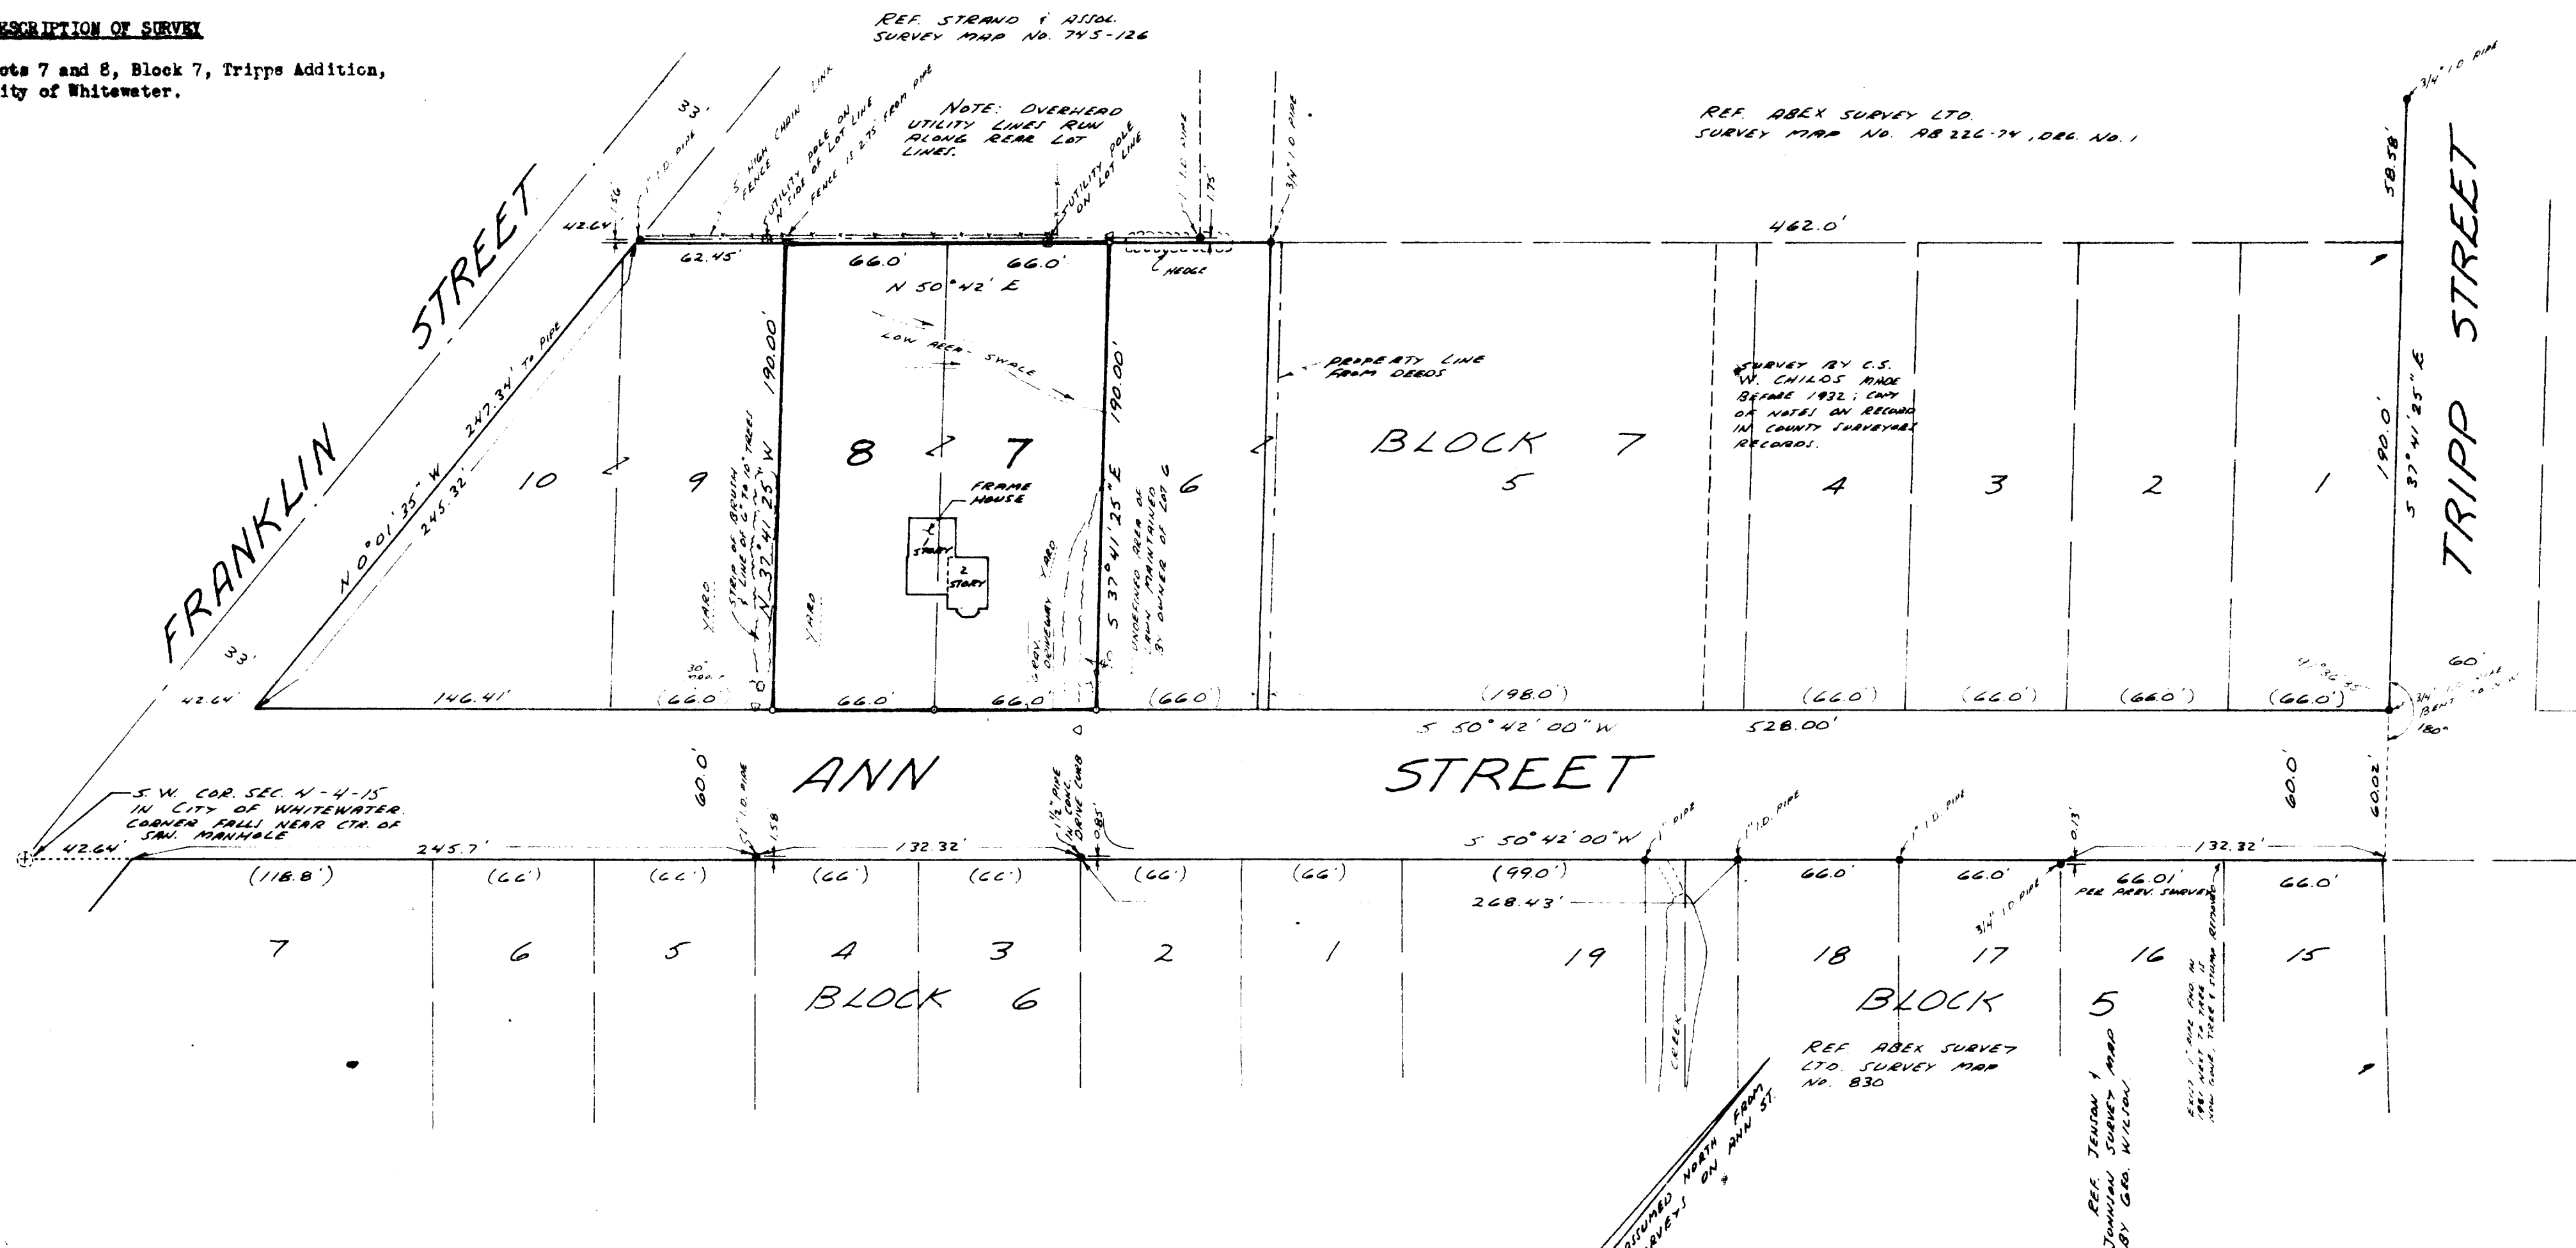

NOTES

- Bearings shown are referenced to assumed north bearings.

LEGEND

- Existing iron stake find., size and type as shown.
- 1" I.B. x 24" iron pipe set.
- Boundary of property surveyed.
- Surveyed lines this survey.
- Surveyed lines from previous surveys.
- Platted lot lines.
- Survey traverse point, spike set.



SURVEYOR'S CERTIFICATE

I, Glen L. Northrop, Registered Land Surveyor, do hereby certify that I have surveyed the land described and mapped hereon and that this map and description is a true representation of the field survey made on Jan. 3 and Feb. 20, 1985 and that this survey is correct to the best of my knowledge and belief.

Glen L. Northrop 2/28/85
Glen L. Northrop S-82

PLAT OF SURVEY

FOR SURVEY OF LOTS 7 AND 8, BLOCK 7, TRIPPS ADDITION, CITY OF WHITESTER, WALWORTH COUNTY, WISCONSIN.

SURVEYED FOR: Ray Stritzel, owner at Whitewater, WI.

SURVEYED BY: ABEX Survey Ltd., 136 W. Main St., Cambridge, WI. 53523
Tel: 608-423-3331

Field Survey: COMPLETE ON FEB 26, 1985
BY R. MOEN & G. NORTHRUP
Drafted: COMPLETE ON FEB 26, 1985
BY G. NORTHRUP
Print Issue Date:

Order No. AB1040-85
DRG. NO. 1040
Sheet 1 of 1