


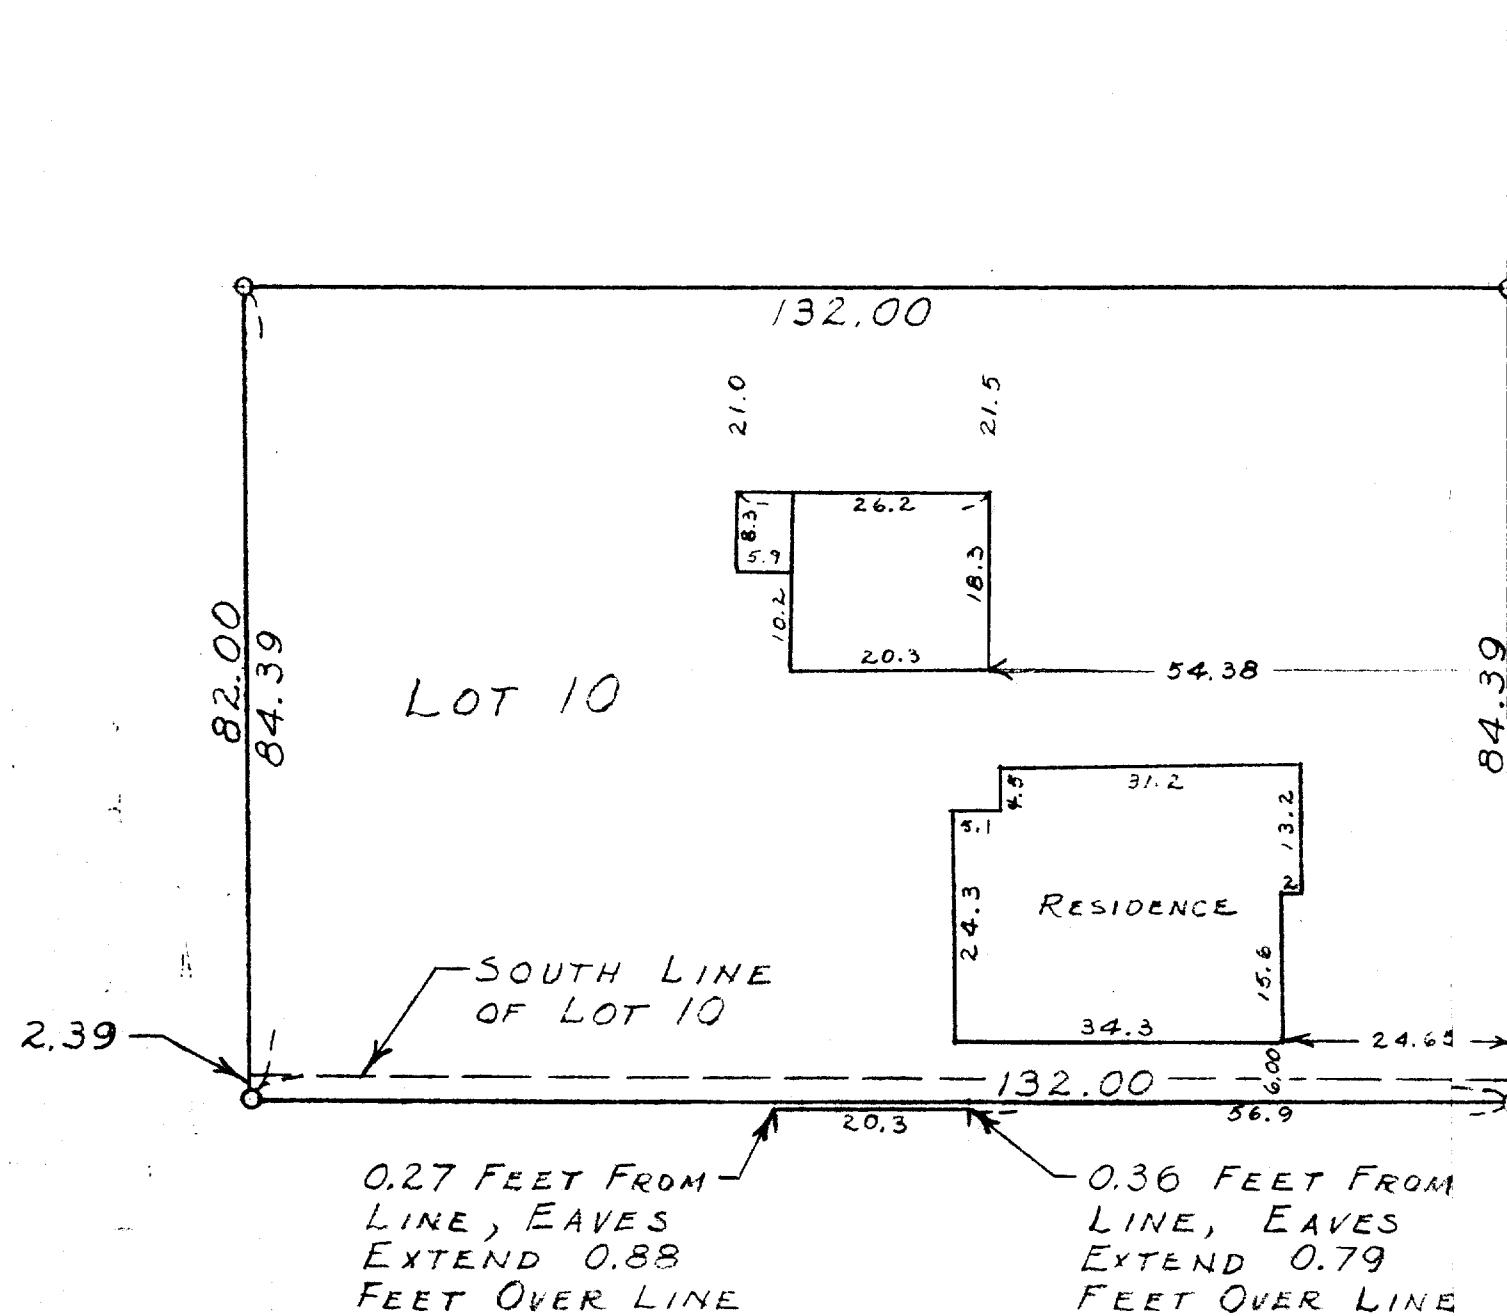

FRANKLIN

STREET

N

SCALE ~ 1" = 20'
O ~ IRON PIPE

PLAT OF SURVEY OF LOT 10 AND ADJOINING PARCEL, BLOCK 28, CHAPMAN
AND LUDINGTON'S ADDITION TO THE VILLAGE (NOW
CITY) OF WHITEWATER, WALWORTH COUNTY, WISCONSIN
JUNE 17, 1957

George T. Dunham
GEORGE T. DUNHAM, SURVEYOR
DELAVER, WIS

10-36