




NEWCOMB STREET

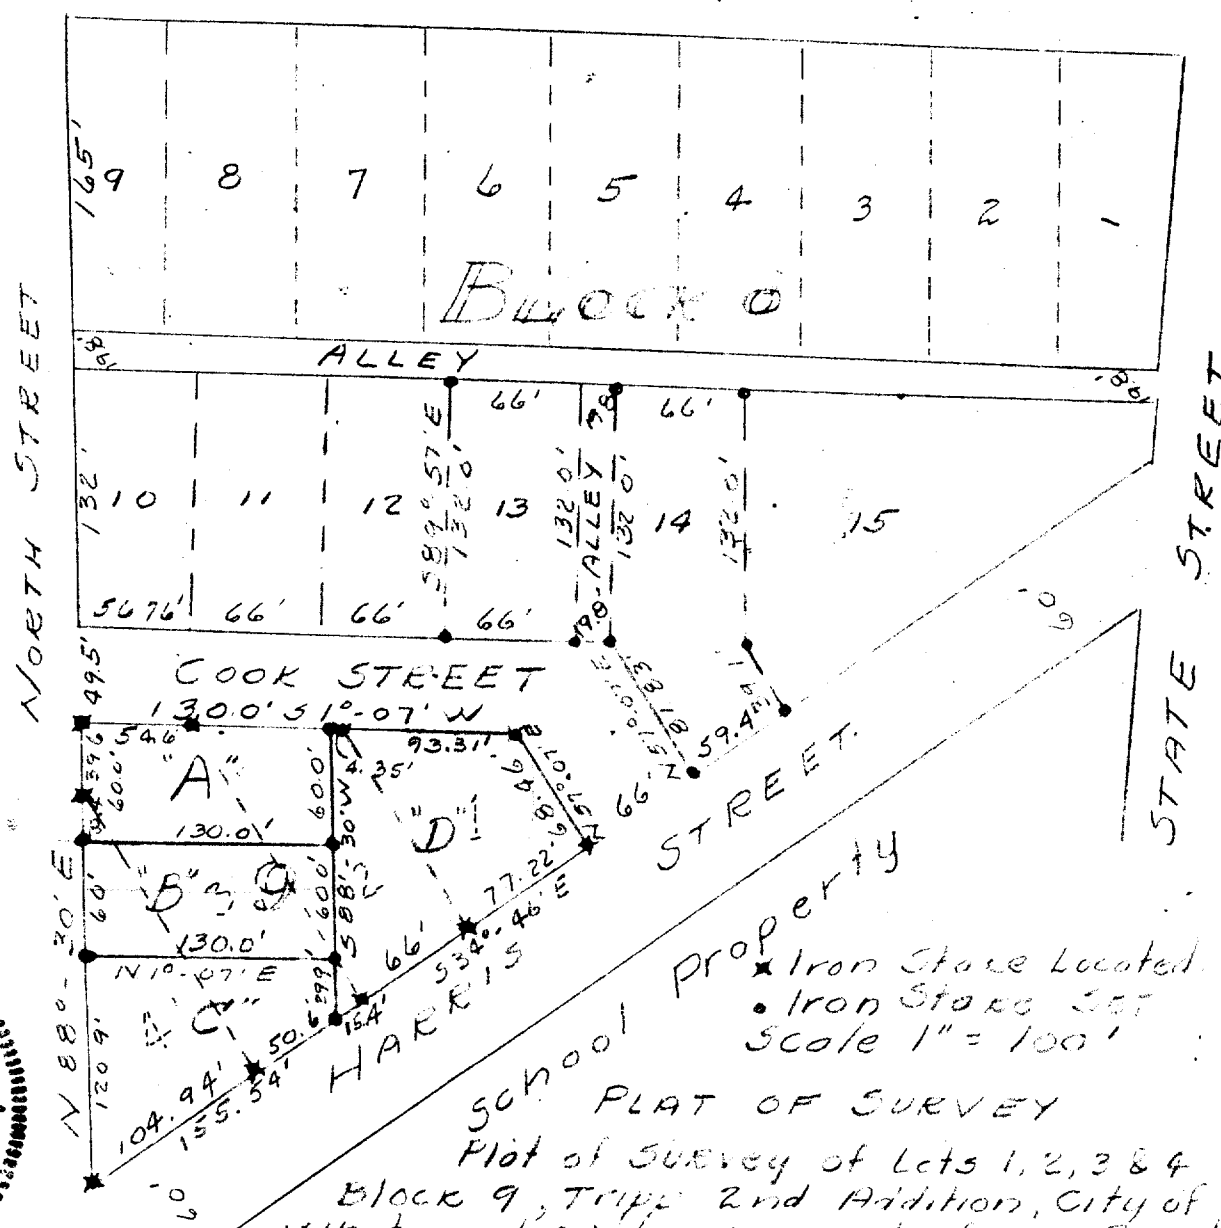

Iron Stake Located
• Iron Stake Set
Scale 1" = 100'

PLAT OF SURVEY

Plot of Survey of Lots 1, 2, 3 & 4
Block 9, Trip 2nd Addition, City of
White Water, Wisconsin, to form Parcels
"A", "B", "C" and "D". Owners D. & V. K. K. K. K.

Descriptions of Parcels: Parcel "A". Parts of Lots 2, 3 & 4, more fully described as follows: Beginning at an iron stake marking the NE Corner of Block 9, thence $51^{\circ}-07'W$ for 130.0 feet; thence $588^{\circ}-30'W$ for 60.0'; thence, $N1^{\circ}-07'E$ for 130.0'; thence, $N88^{\circ}-30'E$ for 60.0 feet to the point of beginning. Contains 7800 sq. ft.
Parcel "B": Parts of Lots 2, 3, & 4, more fully described as follows: Beginning at NE Corner of Block 9, thence $588^{\circ}-30'W$ for 60.0 feet to the point of beginning; thence $51^{\circ}-07'W$ for 130.0 feet; thence $588^{\circ}-30'W$ for 60.0 feet; thence $N1^{\circ}-07'E$ for 130.0 feet; thence $N88^{\circ}-30'E$ for 60.0 feet to the point of beginning. Contains 7800 sq. ft.
Parcel "C": Parts of Lots 3 & 4, more fully described as follows: Beginning at the NE Corner of Block 9, thence $588^{\circ}-30'W$ for 120.0 feet to the point of beginning; thence $51^{\circ}-07'W$ for 130.0 feet; thence $588^{\circ}-30'W$ for 29.9 feet; thence $N34^{\circ}-46'W$ for 155.54 feet; thence $N88^{\circ}-30'E$ for 120.9 feet to the point of beginning. Contains 10,387 sq. ft.
Parcel "D": Parts of Lots 2 & 3 and all of Lot 1, Blk 9; more fully described as follows: Beginning at NE Cor. of Block 9, thence $51^{\circ}-07'W$ for 130.0 feet to the point of beginning; thence $51^{\circ}-07'W$ for 97.66 feet; thence $557^{\circ}-07'W$ for 68.46 feet; thence $N34^{\circ}-46'W$ for 158.62 feet; thence $N88^{\circ}-30'E$ for 149.9 feet to point of beginning. Contains 12,961.7 sq. ft.

I, J. C. Trueloff, do hereby certify that I have surveyed the property described above according to the official records, and that the plat is a correct representation of the lines and measurements.

J. C. Trueloff

June 1958

Wis. Reg. Land Surveyor, No 355