



D. Cooper & CO., INC
Rt 4 Box 508B • Elkhorn WI 53121

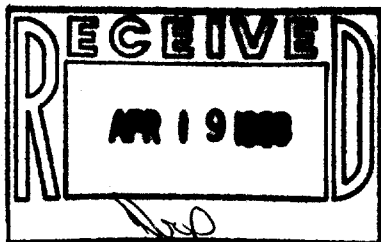

Part of Lots One (1) and Two (2) in Block Fifteen (15) of the VILLAGE (NOW CITY) OF WHITEWATER, which plat was recorded on October 6, 1851 in Volume 3 of Plats at page 46, being a subdivision of the South West One-quarter (1/4) of Section Four (4), in Township Four (4) North, Range Fifteen (15) East, in the City of Whitewater, bounded and described as follows: Commencing at a point on the East side of said Lot 1, 162 feet North of the South East corner thereof, thence Westerly and parallel with Whitewater Street to the West line of said Lot 2; thence Northerly along said West line, 66 feet; thence Easterly and parallel with Whitewater Street to the East line of said Lot 1; thence Southerly along said East line 66 feet to the place of beginning.

SCALE 1" = 30'

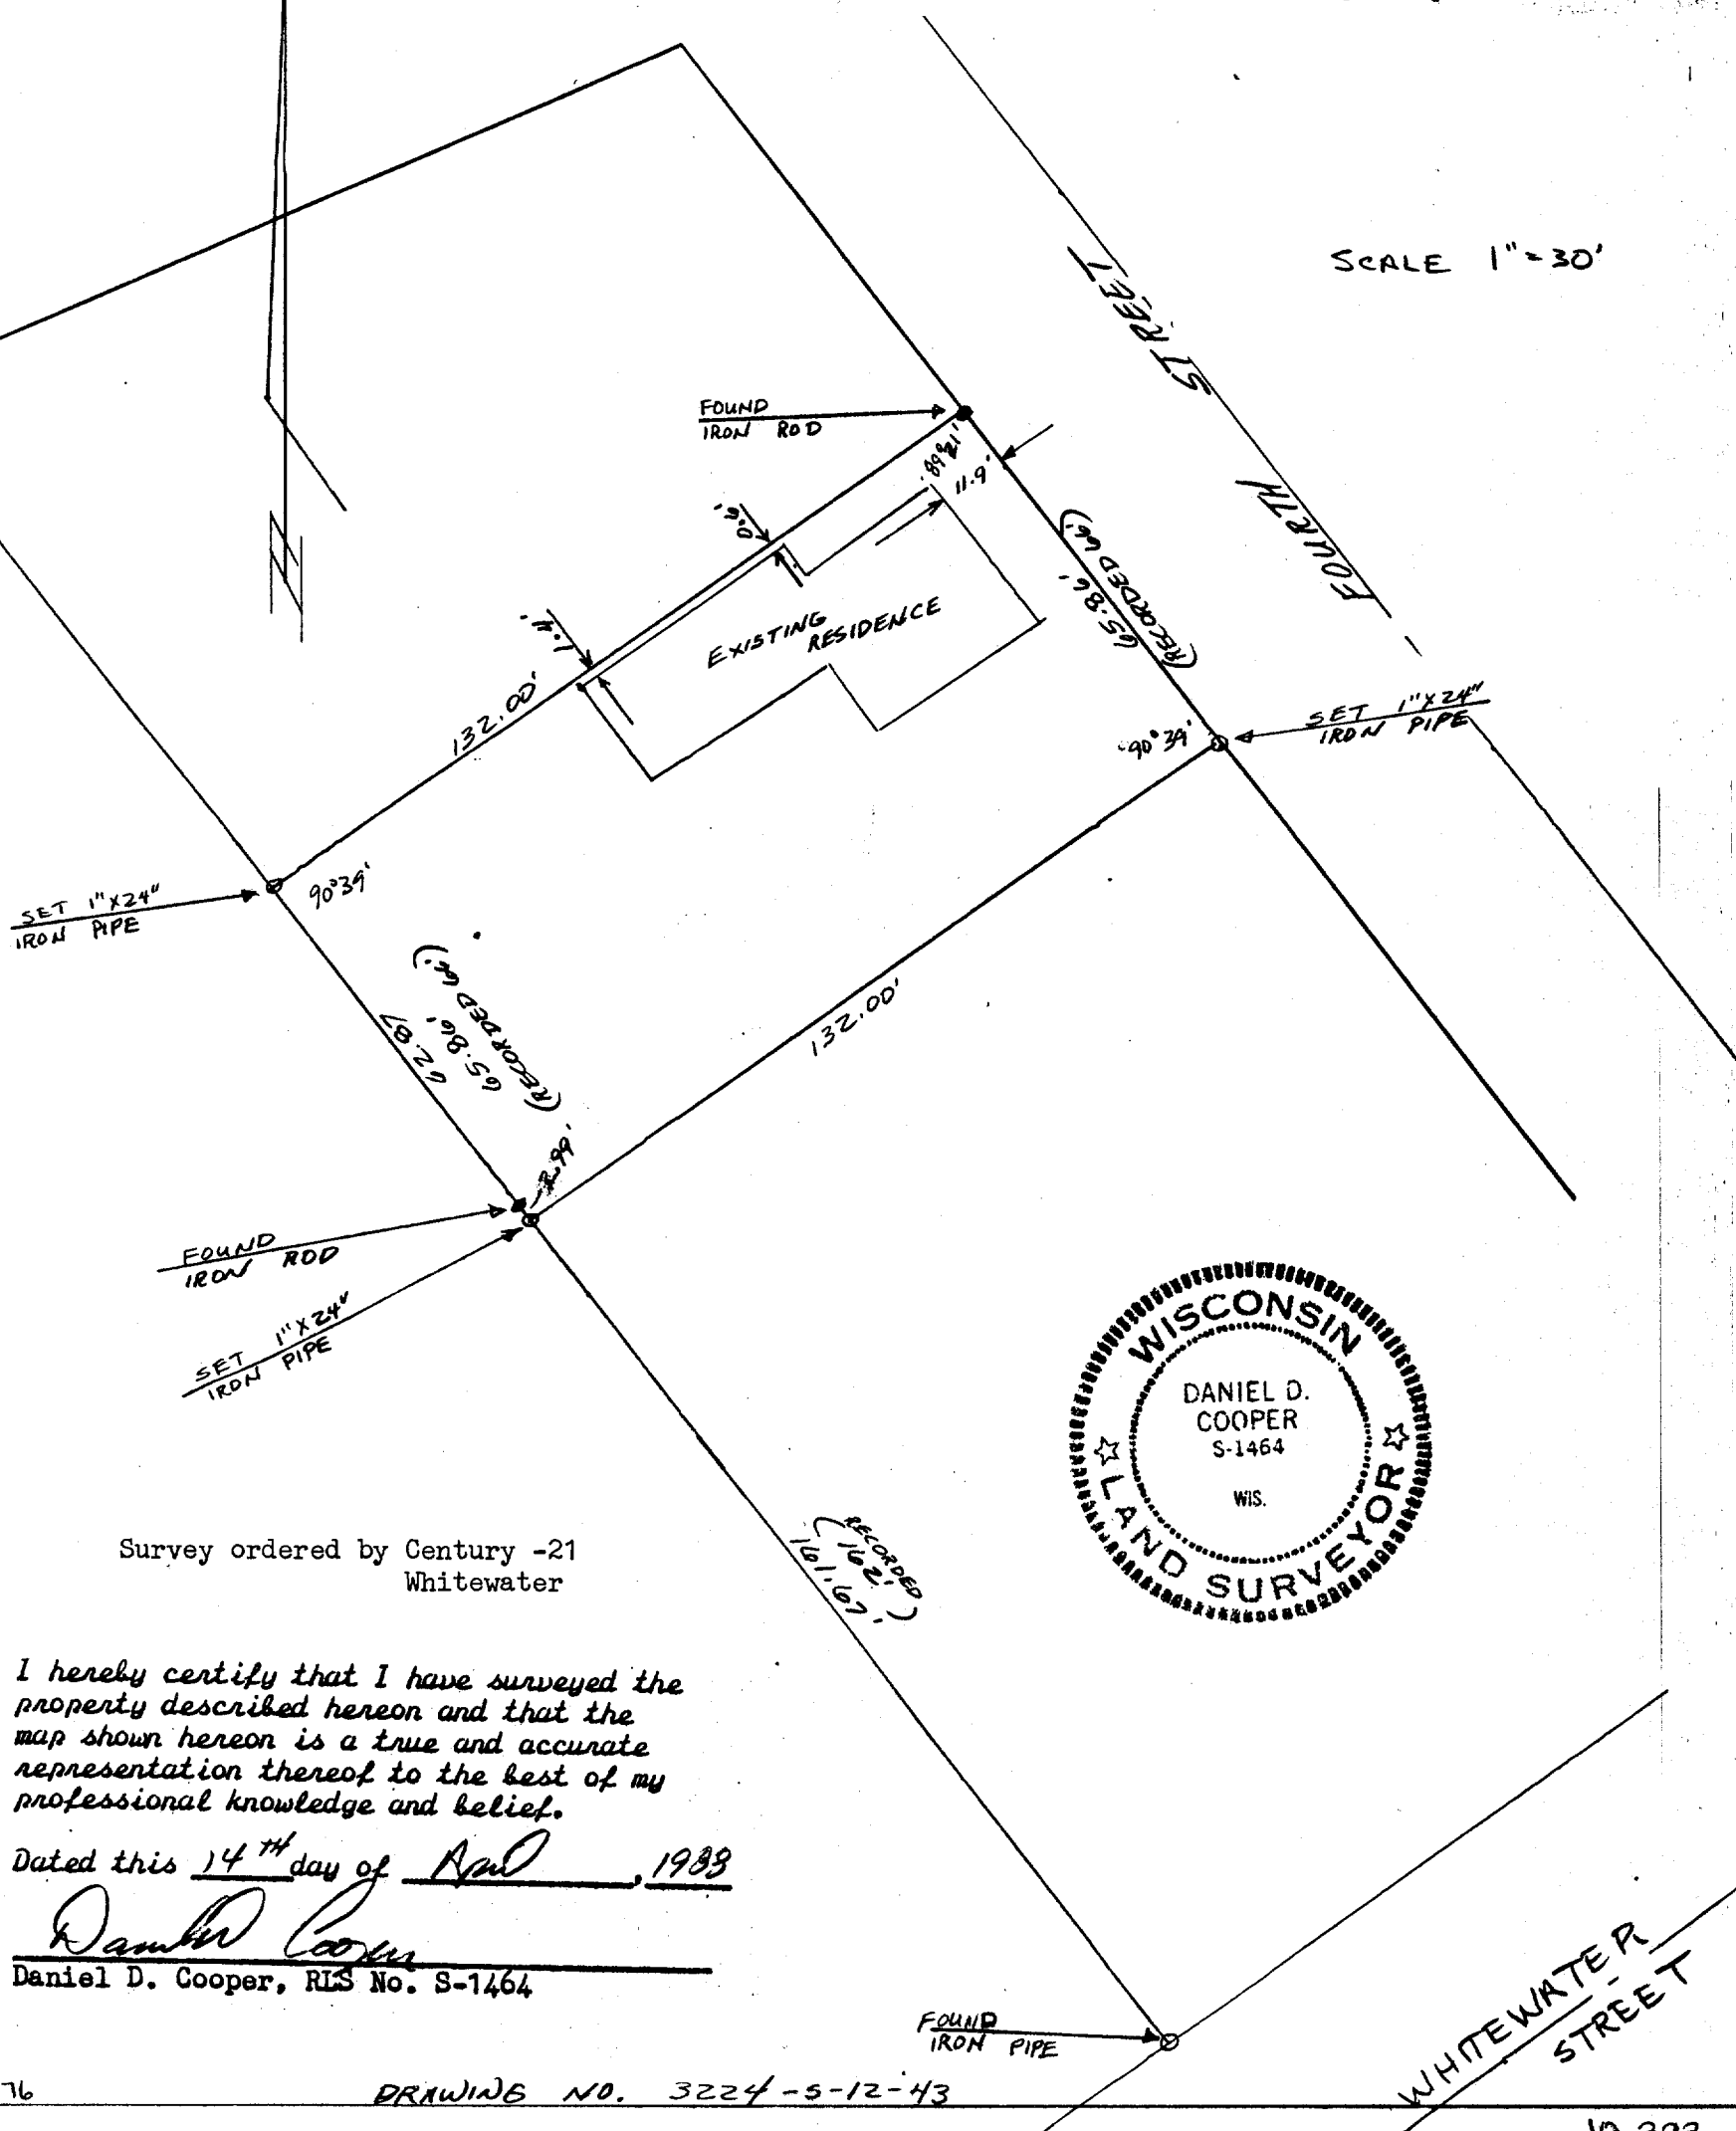

Survey ordered by Century -21
Whitewater

I hereby certify that I have surveyed the property described hereon and that the map shown hereon is a true and accurate representation thereof to the best of my professional knowledge and belief.

Dated this 14th day of April, 1939

Daniel D. Cooper
Daniel D. Cooper, RLS No. S-1464